


Addendum No. 3  
Date: April 17, 2026

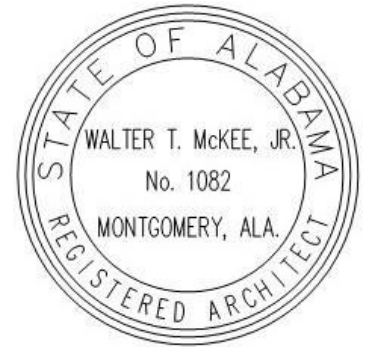

Project:  
**Site Improvements and Interior Alterations to  
Fairhope High School for the  
Baldwin County Public Schools  
Fairhope, Alabama**

**MCKEE PROJECT NO. 25-160B  
ALABAMA DIVISION OF CONSTRUCTION MANAGEMENT NO. 2026083**

The following changes and/or substitutions to the plans and specifications are hereby made a part of same and are incorporated in full force as part of the contract.

Bidders shall acknowledge receipt of this Addendum in writing on his Proposal Form.

**A3.1 GENERAL MODIFICATIONS:**

- A. Refer to the **Table of Contents (Revised 4-17-26)**, herein.
- B. Refer to added **Section 01000 Alternates**, herein.

**A3.2 SPECIFICATION MODIFICATIONS:**

- A. Refer to added **Section 02810 Sodding and Topsoil**, herein.
- B. **DELETE Section 02811 Seeding and Topsoil.**
- C. Refer to added **Section 09301 Porcelain Tile**, herein.

**A3.3 DRAWING MODIFICATIONS:**

- A. Refer to the following revised drawing sheets, herein.
  - 1. Sheets **G1.1, FS-200 Revised 04-17-2026.**
  - 2. Sheets **P1.0, P1.1, P2.1, P3.1, P3.2, M1.1, and M2.0, Revised 04-17-2026.**
  - 3. Sheets **E0.0, E0.1, E1.0, E1.1, E1.2, E2.0, E2.1, E2.2, E2.3, E3.0, E3.1, E3.2, E3.3, E4.0, E4.1, E5.0, E5.1, E6.0, ED1.1, and ED2.1, Revised 04-17-2026.**

**END OF ADDENDUM**

## TABLE OF CONTENTS

---

# Site Improvements and Interior Alterations

to  
**Fairhope High School**  
for the  
**Baldwin County Board of Education**  
Fairhope, Alabama

**MCKEE PROJECT NO. 25-160B**

### **BIDDING REQUIREMENTS**

- Advertisement For Bids
- Instructions to Bidders (DCM Form C-2)
- Request For Information (McKee Form)
- Prior Approval/Substitution Request Form (McKee Form)
- Proposal Form (DCM Form C-3)
- Accounting of Sales Tax (Attachment Form, DCM Form C-3A)
- Form Of Bid Bond (DCM Form C-4)
- Special Instructions to Bidders (McKee Form)

### **CONTRACT FORMS**

- Preparation and Approval of Construction Contracts and Bonds (DCM Form B-7)
- Construction Contract (DCM Form C-5)
- Performance Bond (DCM Form C-6)
- Payment Bond (DCM Form C-7)
- General Conditions of the Contract (DCM Form C-8)
- Instructions for Contractor's Insurance Company (Article 37 of DCM Form C-8)
- Supplement to General Conditions of the Contract (McKee Form)
- State of Alabama Disclosure Statement Form, Required by Article 3B of Title 41, Code of Alabama 1975 with Information and Instructions regarding Relationships Between Contractor/Grantees and Public Officials/Employees.
- State of Alabama E-Verify Memorandum of Understanding Instructions *with* ABC Bulletin *and* Revised Alabama Immigration Law Guidance for School Boards.
- Supplemental E-Verify Memorandum of Understanding (McKee Form)
- Alabama Department of Revenue – Sales and Use Tax Division – Application for Sales and Use Tax Certificate of Exemption (ST: EX-01)
- Alabama Department of Real Property Management Division of Construction Management Permit Fee & Re-Inspection Fee Calculation Worksheet

## **GENERAL CONDITIONS**

- Pre-Construction Conference Checklist (DCM Form B-8)
- Detail Of Project Sign (DCM Form C-15)
- Application and Certificate for Payment (DCM Form C-10)
- Schedule Of Values, (DCM Form C-10SOV, Attachment to DCM Form C-10)
- Inventory Of Stored Materials, (DCM Form C-10SM, Attachment to DCM Form C-10)
- Progress Schedule and Report (DCM Form C-11,)
- Change Order Checklist, (DCM Form B-12, For Use With DCM Form C-12)
- Contract Change Order (DCM Form C-12 (fully locally-funded K-12 Schools)
- Change Order Justification (DCM Form B-11) Attachment to DCM Form C-12
- Change Order Proposal Recap Sheet (Lathan Mckee Form, LM 0825)
- General Contractor's Roofing Guarantee (DCM Form C-9)
- Certificate of Substantial Completion (DCM Form C-13 & 13A)
- Final Payment Checklist (DCM Form B-13)
- Contractor's Affidavit of Payment of Debts and Claims (DCM Form C-18)
- Contractor's Affidavit of Release of Liens (DCM Form C-19)
- Consent of Surety to Final Payment (DCM Form C-20)
- Form of Advertisement for Completion (DCM Form C-14)
- Fire Alarm Contractor's Permit Application
- Certificate of Asbestos Free Building Materials (McKee Form)

## **TECHNICAL SPECIFICATIONS**

<b>DIVISION 01</b>	<b>GENERAL REQUIREMENTS</b>
01000	Alternates
01010	Scope of Work
01011	Contingency Allowances
01250	Contract Modification Procedures
01290	Payment Procedures
01320	Construction Progress Documentation
01322	Photographic Documentation
01330	Submittal Requirements
01500	Temporary Facilities and Controls
01600	Product Requirements
01700	Execution Requirements
01770	Closeout Procedures
01781	Project Record Documents

Site Improvements and Interior Alterations to  
Fairhope High School for the  
Baldwin County Schools  
Fairhope, Alabama

TABLE OF CONTENTS  
Page 2 of 5  
**Revised 04.17.26-Addendum #3**

01782 Operation and Maintenance Data  
01820 Demonstration and Training

**DIVISION 02 SITE WORK**

02070 Selective Demolition  
02200 Earthwork  
02201 Soils Report  
02282 Termite Control  
02513 Asphaltic Concrete Paving  
02514 Portland Concrete Paving  
02660 Water Distribution  
02720 Storm Sewers  
02730 Sanitary Sewers  
**02810 Sodding and Topsoil**  
02830 Temporary Fencing and Gates

**DIVISION 03 CONCRETE**

03310 Cast-In-Place Concrete  
03950 Concrete Sealer

**DIVISION 04 MASONRY**

04200 Unit Masonry  
04720 Architectural Cast Stone

**DIVISION 05 METAL**

05310 Steel Decking  
05400 Cold Formed Metal Trusses  
05500 Miscellaneous Steel and Metal Fabrications  
05515 Ladders  
05540 Metal Studs

**DIVISION 06 CARPENTRY**

06100 Rough Carpentry  
06241 Solid Surface Fabrications

**DIVISION 07 MOISTURE PROTECTION**

07115 Bituminous Damp-proofing  
07200 Insulation

Site Improvements and Interior Alterations to  
Fairhope High School for the  
Baldwin County Schools  
Fairhope, Alabama

TABLE OF CONTENTS  
Page 3 of 5  
**Revised 04.17.26-Addendum #3**

07240	Exterior Insulation and Finish System
07500	Membrane Roofing
07510	Membrane Roof Insulation
07600	Flashing and Sheet Metal
07900	Joint Sealers

**DIVISION 08 DOORS, WINDOWS AND GLASS**

08100	Steel Doors and Steel Frames
08211	Wood Doors
08220	Fiberglass Reinforced Plastic (FRP) Doors
08330	Coiling Doors
08380	Traffic Doors (Kitchen)
08410	Aluminum Storefront (Exterior Windows)
08700	Finish Hardware
08800	Glazing

**DIVISION 09 FINISHES**

09250	Gypsum Drywall
09290	Glass Fiber Reinforced Cement Column Covers
<b>09301</b>	<b>Porcelain Tile</b>
09500	Linear Metal Ceiling/Soffit System
09510	Acoustical Ceilings
09650	Rubber Base
09651	Luxury Vinyl Tile (LVT)
09672	Resinous Flooring
09680	Carpet
09900	Painting

**DIVISION 10 SPECIALTIES**

10160	Toilet Partitions
10200	Louvers
10410	Identifying Devices
10440	Fire Extinguishers and Accessories
10500	Lockers
10800	Toilet Accessories

**DIVISION 11 EQUIPMENT**

11400	Food Service Equipment
-------	------------------------

**DIVISION 12 FURNISHINGS**  
12304 Laminate Clad Casework

**DIVISION 13 SPECIAL CONSTRUCTION**  
13120 Pre-Engineered Metal Building  
13670 Extruded Aluminum Walkway Cover

**DIVISION 14 CONVEYING SYSTEM**  
Not Applicable

**DIVISION 15 MECHANICAL**  
15100 General Requirements for Mechanical Work  
15200 System Test, Adjusting and Balancing  
15400 Plumbing  
15510 Fire Protection System  
15800 Heating, Ventilation and Air Conditioning  
15995 Energy Management Control System and Direct Digital Controls

**DIVISION 16 ELECTRICAL**  
16100 Electrical  
16110 Lighting Controls  
16200 Surge Suppression Device  
16300 Low Voltage Dry Transformers  
16720 Fire Detection and Alarm Systems  
16730 GPS Wireless Clock Systems  
16820 Intercom/Sound  
16950 Communications

**END OF TABLE OF CONTENTS**

## **SECTION 01000 - ALTERNATES**

### **PART 1 - GENERAL**

#### **1.1 RELATED DOCUMENTS**

- A. Drawings and general provisions of the Contract including General and Supplementary Conditions and Division 1 Specification sections apply to work of this section.

#### **1.2 DESCRIPTION OF REQUIREMENTS**

- A. Definition: An Alternate is an amount proposed by bidders and stated on the Proposal Form that will be added to or deducted from Base Bid amount if the Owner decides to accept a corresponding change in either scope of work or in products, materials, equipment, systems or installation methods described in Contract Documents.
- B. Coordination: Coordinate related work and modify or adjust adjacent work as required to ensure that work affected by each accepted Alternate is complete and fully integrated into the project.
- C. Notification: Immediately following award of Contract, prepare and distribute to each party involved notification of the status of each Alternate. Indicate whether Alternates have been accepted, rejected or deferred for consideration at a later date. Include a complete description of negotiated modifications to Alternates, if any.
- D. Schedule: A "Schedule of Alternates" is included at the end of this section. Specification section referenced in the Schedule contain requirements for materials and methods necessary to achieve the work described under each Alternate.
- E. Include as part of each Alternate, miscellaneous devices, appurtenances and similar items incidental to or required for a complete installation whether or not mentioned as part of the Alternate.

#### **1.3 SCHEDULE OF ALTERNATES**

- A. This project has No Bid Alternates.

**PART 2 - NOT APPLICABLE**

**PART 3 - NOT APPLICABLE**

**END OF SECTION**

## SECTION 02810 - SODDING AND TOPSOIL

### PART 1 - GENERAL

#### 1.1 RELATED DOCUMENTS

- A. Drawings and general provisions of the contract including General and Supplementary Conditions and Division 1 Specification Sections apply to work of this section.

### PART 2 - PRODUCTS

#### 2.1 MATERIALS

- A. Sod:
  - 1. Provide strongly rooted **419 Bermuda Sod**.
  - 2. Sod shall be not less than 2 years old and free of weeds and undesirable native grasses.
  - 3. Only provide sod capable of growth and development when planted (viable, not dormant).
  - 4. Provide machine cut sod of a uniform minimum soil thickness of 5/8 inch, plus thickness of top growth and thatch. Sod pieces to be consistent in size and shape.

### PART 3 - EXECUTION

#### 3.1 GENERAL REQUIREMENTS

- A. Sodding shall be restricted to those as instructed or recommended by the local Cooperative Extension Agent except when special instructions to the contrary are issued in writing by the Architect.
  - 1. The Contractor shall furnish, in writing to the Architect, those recommendations of the Extension Agent before proceeding with any operations.
  - 2. Grassing also shall comply with State of Alabama Highway Department specifications, latest Edition.
  - 3. Contractor shall water and maintain newly grassed areas until acceptable stand of grass is established and approved by the Architect.
- B. Preparation of Subgrade Soil:
  - 1. The subgrade soil in those areas to be sodded whether shown or not shown on the plans shall be loosened to a minimum depth of 3 inches and graded to remove all ridges and depressions so that it will be, after settlement everywhere parallel to and at the proper level to provide finished grades specified.
  - 2. All stones over 1" in dimension, sticks, rubbish and other extraneous matter shall be removed during this operation.
- C. Topsoil:
  - 1. Contractor shall furnish and spread layer of topsoil over all areas.

Topsoil shall be spread in loose layers to provide finished grades specified and shall have an equal depth of not less than 4" over the site after natural settlement and light rolling.
- D. All areas shall be carefully graded and raked to accurate specified grades and uniform slopes following topsoil spreading. The surface, when finished and settled shall conform to required grades and shall be free from hollows and other inequalities, from stones over 1" in diameter, sticks and other debris, and shall be satisfactory to the Architect.
- E. Initial fertilization of sodded area prior to sodding and following preparation, commercial fertilizer 4-10-10 or 4-12-12 shall be applied on all grass areas at the uniform rate of 20 pounds per 1,000 square feet each.



### 3.2 SODDING

- A. Prepare all areas to receive sod.
- B. **The Contractor shall fully sod all graded and disturbed areas, including the Contractors staging area and all areas disturbed by vehicular construction traffic, whether shown on plans or not.**

### 3.3 TOPSOIL

- A. General:
  - 1. Provide topsoil of natural, friable, fertile, fine loamy, soil possessing the characteristics of representative top soils in the vicinity which produces a heavy growth; free from subsoil, weeds, litter, clods, stiff clay, stones, stumps, roots, trash, toxic substances or any other material which may be harmful to plant growth or hinder planting operations.
  - 2. The topsoil shall not be in a muddy or frozen condition. Topsoil shall be that material stripped and stockpiled, or as required to provide 4" of coverage.
  - 3. The topsoil shall have a pH range of 5.9 to 7.0.
  - 4. Limestone or aluminum sulfate (or acceptable substitute) may be used to adjust the pH of the topsoil to an acceptable level.

**END OF SECTION**

## SECTION 09301 - PORCELAIN TILE

### PART 1 - GENERAL

#### 1.1 RELATED DOCUMENTS

- A. Drawings and general provisions of Contract including General and Supplementary Conditions and Division 1 Specification sections apply to work of this section.

#### 1.2 DESCRIPTION OF WORK

- A. Definition: Tile includes ceramic surfacing units made from clay or other ceramic materials.
- B. Extent of tile work is indicated on drawings and schedules.
- C. Types of tile work in this section include the following:
  - 1. Wall Tile.
  - 2. Floor Tile.
  - 3. Wainscot Accent Tile.
  - 4. Wainscot Tile Cap.
  - 5. Base.
  - 6. Stone Thresholds.
- D. Portland cement plaster scratch coat on wall surfaces indicated to receive tile is work of this section.
- E. Sealing expansion and other joints in tile work with elastomeric joint sealers is work of this section.

#### 1.3 QUALITY ASSURANCE

- A. Source of Materials: Provide materials obtained from one source for each type and color of tile, grout, and setting materials.
- B. Mock-Up: Contractor shall provide mock-up panels for evaluation of materials, surface preparation techniques and application workmanship.
  - 1. Mock-up panel shall be no less than 4'-0" x 4'-0" panel as follows:
    - a. One (1) panel per room, per surface. (i.e. 1 panel for wall surface and 1 panel for floor surface for each room of different selection).
    - b. Mock-up panels shall be marked identifying room location and product manufacturer, type, style, size and color information.
    - c. Do not proceed with work until materials, workmanship, color, and sheen are approved by Architect.
    - d. Provide additional mock-up panels as required to produce acceptable work.

#### 1.4 SUBMITTALS

- A. Product Data: Submit manufacturer's technical information and installation instructions for materials required, except bulk materials.
- B. Samples for Selection Purposes: Submit manufacturer's color charts consisting of actual tiles or sections of tile showing full range of colors, textures and patterns available for each type of tile indicated. Include samples of grout and accessories involving color selection.

#### 1.5 PRODUCT HANDLING

- A. Deliver and store packaged materials in original containers with seals unbroken and labels intact until time of use. Prevent damage or contamination to materials by water, freezing, foreign matter or other causes.

## 1.6 PROJECT CONDITIONS

- A. Maintain environmental conditions and protect work during and after installation to comply with referenced standards and manufacturer's printed recommendations.
- B. Vent temporary heaters to exterior to prevent damage to tile work from carbon dioxide buildup.
- C. Maintain temperatures at not less than 50 degrees F in tiled areas during installation and for 7 days after completion, unless higher temperatures required by referenced installation standard or manufacturer's instructions.

## PART 2 - PRODUCTS

### 2.1 MANUFACTURERS

- A. The following manufacturers' products have been used to establish minimum standards for materials, workmanship and function:
  - 1. Porcelain Tile:
    - a. StonePeak (Basis of Design)
    - b. American Olean Tile Co.
    - c. Marazzi
- B. Equal products of other manufacturers may be used in the work, provided such products have been approved by the Architect, not less than Ten (10) days prior to scheduled bid opening.

### 2.2 PRODUCTS, GENERAL

- A. ANSI Standard for Ceramic Tile: Comply with ANSI A137.1 "American National Standard Specifications for Ceramic Tile" for types and grades of tile indicated.
  - 1. Furnish tile complying with "Standard Grade" requirements unless otherwise indicated.
- B. ANSI Standard for Tile Installation Materials: Comply with ANSI standard referenced with installation products and materials indicated.
- C. Colors, Textures and Patterns: For tile and other products requiring selection of colors, surface textures or other appearance characteristics, provide products to match characteristics indicated or, if not otherwise indicated, as selected by Architect from manufacturer's standards.
  - 1. Provide tile trim and accessories which match color and finish of adjoining flat tile.
- D. Mounting: Where factory-mounted tile is required provide back- or edge-mounted tile assemblies as standard with manufacturer unless another mounting method is indicated.
  - 1. Where tile is indicated for installation on exteriors or in wet areas, do not use back or edge-mounted tile assemblies unless tile manufacturer specifies that this type of mounting is suitable for these kinds of use and has been successfully used on other projects.

### 2.3 TILE PRODUCTS

- A. Provide tile complying with the following requirements:
  - 1. Manufacturer/Series:
    - a. **StonePeak "Simply Modern" Collection.**
  - 2. Type:
    - a. Porcelain
  - 3. Wearing Surface for Floors:
    - a. "stable, firm and slip resistant", (exceeds 0.60 on the ASTM C-1028 test, wet and dry).
  - 4. Nominal Thickness:
    - a. 3/8"

5. Nominal Facial Dimensions as follows:
  - a. Floor Tile
    1. **12" x 24" Floor Tile** - "Simply Modern" Series, Unglazed, with 1/4" grout joints.
  - b. Wall Tile
    1. **12" x 24" Wall Tile** – "Simply Modern" Series, Unglazed, with 1/4" grout joints.
    2. **4" x 12" "Adamas" Series Wall Tile Accent Band – 3 layers high located 6'-0" AFF.** Glazed, with 1/8" grout joints.
  - c. Base:
    1. **6" x 12" Coved Base** – "Schluter Dilex" Series.
  - d. Wainscot Cap:
    1. **3" x 12" Bullnose** – "Simply Modern" Series.
6. Face: Plain with cushion edges.
- B. Trim Units: Provide tile trim units to match characteristics of adjoining flat tile and to comply with following requirements:
  1. Size:
    - a. As indicated, coordinated with sizes and coursing of adjoining flat tile, where applicable.
  2. Shapes:
    - a. Selected from manufacturer's standard shapes.
  3. External Corners for Portland Cement Mortar Installations:
    - a. Bullnose shape with a radius of not less than 3/4" unless otherwise indicated.
  4. Internal Corners:
    - a. Field-buttet square corners, except use internal cove and cap angle pieces designed to member with stretcher shapes.

## **2.4 STONE THRESHOLDS**

- A. General: Provide stone which is uniform in color and finish, fabricated to sizes and profiles indicated or required to provide transition between tile surfaces and adjoining finished floor surfaces.
- B. Marble Thresholds: Provide marble thresholds complying with ASTM C 503 requirements for exterior use and abrasion resistant for uses subject to heavy foot traffic.
  1. Provide white, bonded marble complying with MIA Group "A" requirements for soundness.

## **2.5 SETTING MATERIALS**

- A. Portland Cement Mortar Installation Materials: Provide materials to comply with ANSI A108.1 as required for installation method designated, unless otherwise indicated.

## **2.6 GROUTING MATERIALS – FLOOR & WALL**

- A. High Performance Epoxy grout that offers color uniformity, durability and stain resistance with extraordinary ease of use.
  1. Laticrete "Spectralock Pro Grout".
  2. Color to be selected by architect after the bid date from manufacturer standards
- B. Epoxy grout is to be installed per manufacturer's instructions.

## **2.7 MISCELLANEOUS MATERIALS**

- A. Single-Component Sealants: ASTM C 920, Type S, Grade NS, use NT (for use in joints in non-traffic areas).
- B. Two-Component Sealants: ASTM C 920, Type M, Grade P, Class 25, use T (for use in joints subject to pedestrian traffic).
- C. Tile Cleaner: Product specifically acceptable to manufacturer of tile and grout manufacturer for application indicated and as recommended by National Tile Promotion Federation, 112 North Alfred St., Alexandria, VA 22134 or Ceramic Tile Institute, 700 N. Virgil Ave., Los Angeles, CA 90029.

## **2.8 TILE BACKING PANELS**

- A. Fiber-Cement Backer Board: ASTM C1288, in maximum lengths available to minimize end-to-end butt joints.
  - 1. Manufacturers: Subject to compliance with requirements, provide products by one of the following:
    - a. CertainTeed Corporation.
    - b. Custom Building Products.
    - c. James Hardie Building Products, Inc.
  - 2. Thickness: 1/2 inch (12.7 mm) unless otherwise indicated on drawings.
- B. Install panels and treat joints in accordance with ANSI A108.11, APA guidelines, and manufacturer's written instructions for type of application indicated

## **2.9 WATERPROOF MEMBRANE**

- A. General: Manufacturer's standard product that complies with ANSI A118.10 and is recommended by the manufacturer for the application indicated. Include reinforcement and accessories recommended by manufacturer.
- B. Polyethylene Sheet: Polyethylene faced on both sides with fleece webbing; 0.008-inch (0.2-mm) nominal thickness.
  - 1. Manufacturers: Subject to compliance with requirements, provide products by one of the following:
    - a. Schluter Systems L.P.
    - b. Equal products of other manufacturers may be used in the work, provided such products have been approved by the Architect, not less than Ten (10) days prior to scheduled bid opening.
- C. Install waterproof membrane to comply with ANSI A108.13 and manufacturer's written instructions to produce waterproof membrane of uniform thickness that is bonded securely to substrate.
  - 1. Allow waterproof membrane to cure and verify by testing that it is watertight before installing tile or setting materials over it.

## **PART 3 - EXECUTION**

### **3.1 INSPECTION**

- A. Examine surfaces to receive tile work and conditions under which tile will be installed. Do not proceed with tile work until surfaces and conditions comply with requirements indicated in referenced tile installation standard.

### **3.2 PRE-INSTALLATION CONFERENCE**

- A. A pre-installation conference is required before any tiling materials are installed. This conference shall be conducted by a representative of the Architect and attended by the General Contractor

and Tile Contractor. Provide at least 72 hours advance notice to participants prior to convening pre-installation conference.

- B. The pre-installation conference is intended to clarify demolition and application requirements for work to be completed before tiling operations can begin. This would include a detailed review of the specifications, plans, finish schedules and approved shop drawings, submittal data, samples and mock-ups. If this pre-installation conference cannot be satisfactorily concluded without further inspection and investigation by any of the parties present, it shall be reconvened at the earliest possible time to avoid delay of the work. In no case should the work proceed without inspection of all tiling areas and substantial agreement on all requirements.
- C. The following are to be accomplished during the conference:
  - 1. To review all requirements listed in the specifications and resolve any questions or conflicts that may arise.
  - 2. To establish trade-related job schedules.
  - 3. To establish tiling schedule and work methods that will prevent progress of other trades.
  - 4. Require that all surface preparations and conditions be complete prior to installing tile work.
  - 5. To establish those areas on the job site that will be designated as work and storage areas for tiling operations.
  - 6. To establish acceptable methods of protecting the finished tile surfaces if any trades must travel across or work on, above or around any areas of the finished tile work.
- D. The Architect shall prepare a written report indicating actions taken and decisions made at this pre-installation conference. This report shall be made a part of the project record and copies furnished to the General Contractor and the Owner.

### **3.3 INSTALLATION, GENERAL**

- A. ANSI Tile Installation Standard: Comply with applicable parts of ANSI 108 series of tile installation standards included under "American National Standard Specifications for the Installation of Ceramic Tile".
- B. TCA Installation Guidelines: TCA "Handbook for Ceramic Tile Installation"; comply with TCA installation methods indicated or, if not otherwise indicated, as applicable to installation conditions shown.
- C. Setting beds:
  - 1. Floor tile: Thinset.
  - 2. Wall tile: Thinset.
- D. Extend tile work into recesses and under or behind equipment and fixtures, to form a complete covering without interruptions, except as otherwise shown. Terminate work neatly at obstructions, edges and corners without disrupting pattern or joint alignments.
- E. Accurately form intersections and returns. Perform cutting and drilling of tile without marring visible surfaces. Carefully grind cut edges of tile abutting trim, finish or built-in items for straight aligned joints. Fit tile closely to electrical outlets, piping, fixtures and other penetrations so that plates, collars, or covers overlap tile.
- F. Jointing Pattern: Unless otherwise shown, lay tile in grid pattern. Align joints when adjoining tiles on floor, base, walls and trim are same size. Layout tile work and center tile fields in both directions in each space or on each wall area. Adjust to minimize tile cutting. Provide uniform joint widths, unless otherwise shown.
  - 1. For tile mounted in sheets make joints between tile sheets same width as joints within tile sheets so that extent of each sheet is not apparent in finished work.
- G. Lay out tile wainscots to next full tile beyond dimensions indicated.
- H. Expansion Joints: Locate expansion joints and other sealant filled joints, including control, contraction and isolation joints, where indicated, or if not indicated, at spacing and locations

recommended in TCA "Handbook for Ceramic Tile Installation", and approved by Architect.

1. Prepare joints and apply sealants to comply with requirements of referenced standards and sealant manufacturer.

I. Grout tile to comply with referenced installation standards, using grout materials indicated.

### **3.4 FLOOR INSTALLATION METHODS**

A. Porcelain Tile: Install tile to comply with requirements indicated below for setting bed methods, TCA installation methods related to types of subfloor construction, and grout types:

1. Concrete Subfloors, Interior: TCA F113 with isolation membrane equal to Nobleseal CIS.

B. Grout:

1. High Performance Epoxy grout is to be installed per manufacturer's instructions.

C. Stone Thresholds: Install stone thresholds at locations indicated; set in same type of setting bed as abutting field tile unless otherwise indicated.

D. Metal Edge Strips: Install at locations indicated or where exposed edge of tile flooring meets carpet, wood or other flooring which finishes flush with top of tile.

### **3.5 WALL TILE INSTALLATION METHODS**

A. Install types of tile designated for wall application to comply with requirements indicated below for setting bed methods, TCA installation methods related to subsurface wall conditions, and grout types:

1. Solid Backing, Interior: TCA W221 in wet areas and W213 or W223 25

a. applicable in other areas.

B. Grout:

1. High Performance Epoxy grout is to be installed per manufacturer's instructions.

### **3.6 CLEANING AND PROTECTION**

A. Cleaning: Upon completion of placement and grouting, clean all ceramic tile surfaces so they are free of foreign matter.

1. Unglazed tile shall be cleaned with non-acid solutions only recommended by tile and grout manufacturer's printed instructions, but no sooner than 14 days after installation. Protect metal surfaces, cast iron and vitreous plumbing fixtures from effects of tile cleaning. Flush surface with clean water after cleaning.

B. Finished Tile Work: Leave finished installation clean and free of cracked, chipped, broken, unbonded, or otherwise defective tile work.

C. Protection: When recommended by tile manufacturer, apply a protective coat of neutral protective cleaner to completed tile walls and floors. Protect installed tile work with kraft paper or other heavy covering during construction period to prevent staining, damage and wear.



D. Prohibit foot and wheel traffic from using tiled floors for at least 7 days after grouting is completed. Before final inspection, remove protective coverings and rinse neutral cleaner from tile surfaces.

### **3.7 EXTRA STOCK**

A. Deliver stock of maintenance materials to Owner. Furnish maintenance materials from same manufactured lot as materials installed and enclosed in protective packaging with appropriate identifying labels.

1. Tile Flooring: Furnish not less than one box for each type, color, pattern and size installed.


**END OF SECTION**

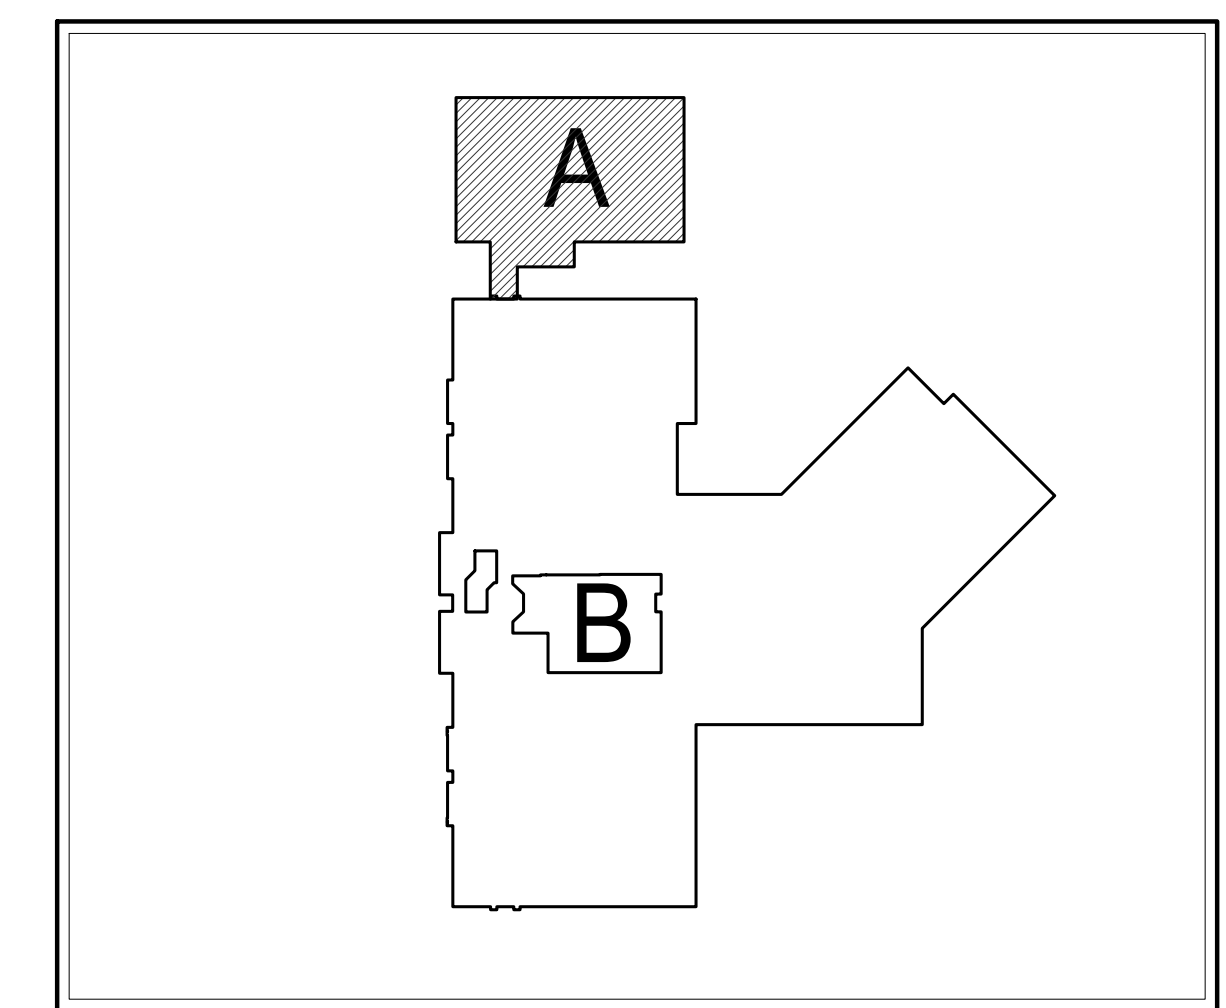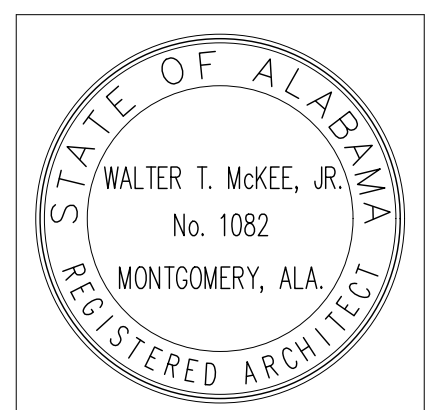

KEY PLAN  
SCALE: NTS

SYMBOL	DESCRIPTION
	SMOKE (TIGHT)-RESISTANT PARTITION - SEE PARTITION TYPE
	2-HOUR RATED FIRE WALL - UL-F - U905 SEE DETAIL 101.1
	PRIMARY BUILDING EXIT
	TRAVEL DISTANCE NEAREST TO EXIT
	HANDICAP ACCESSIBLE
	FIRE EXTINGUISHER LOCATION (SEE DETAIL AX.X)
	FIRE SEPARATION DISTANCE (TABLE 705.8)
	EXIT WIDTH REQUIRED
	EXIT WIDTH PROVIDED
	ACTUAL OCCUPANT LOAD SERVED
	TOTAL EGRESS CAPACITY
	RATED DOOR ASSEMBLY (SECTION 716) (TABLE 716.1.2)
	UNPROTECTED, SPRINKLERED (% OF OPENINGS ALLOWED) (TABLE 705.9)
	(UP, S) 25% (UP, S) NO LIMIT

CODE REVIEW	
CODE:	2021 INTERNATIONAL BUILDING CODE
OCCUPANCY TYPE (SECTION 303):	GROUP E, EDUCATIONAL (303.1.3)
SPRINKLERED (SECTION 903):	YES
NUMBER OF STORIES (TABLE 504.3):	1
CONSTRUCTION TYPE (SECTION 602):	TYPE II-B
TYPE II-B, REQUIRES THE FOLLOWING FIRE RESISTANCE (TABLE 601):	
STRUCTURAL FRAME:	0 HOUR
EXTERIOR BEARING WALLS:	0 HOUR
INTERIOR BEARING WALLS:	0 HOUR
EXTERIOR NONBEARING WALLS:	0 HOUR
INTERIOR NONBEARING WALLS:	0 HOUR
FLOOR CONSTRUCTION:	0 HOUR
ROOF CONSTRUCTION:	0 HOUR
OTHER REQUIREMENTS:	
FIRE WALL RATING (TABLE 706.4):	2 HOURS IN TYPE II CONSTRUCTION
PER IBC 706.5, EXCEPTION 1, FIRE WALLS MAY TERMINATE AT THE INTERIOR FACE OF THE EXTERIOR WALL VENEER.	
OCCUPANCY SEPARATION (TABLE 508.4):	NOT REQUIRED PER IBC 303.1.3
INCIDENTAL USE AREAS (TABLE 509.1):	LAUNDRY (112 SF) - SPRINKLERED LAUNDRY SPACE OVER 100 SQ. FT. REQUIRES A SMOKE-RESISTANT SEPARATION FROM OTHER BUILDING SPACES (509.4.2).
FIRE-RESISTANT CORRIDORS (TABLE 1020.2):	CORRIDORS IN SPRINKLERED GROUP "E" OCCUPANCY SHALL NOT BE RATED.
STAIRS & SHAFT ENCLOSURES (707 & TABLE 707.3.10):	NOT LESS THAN 508.4 IF APPLICABLE; NONE
EXIT ACCESS TRAVEL DISTANCE IS MAXIMUM 260 FEET FOR SPRINKLERED (TABLE 1017.2)	


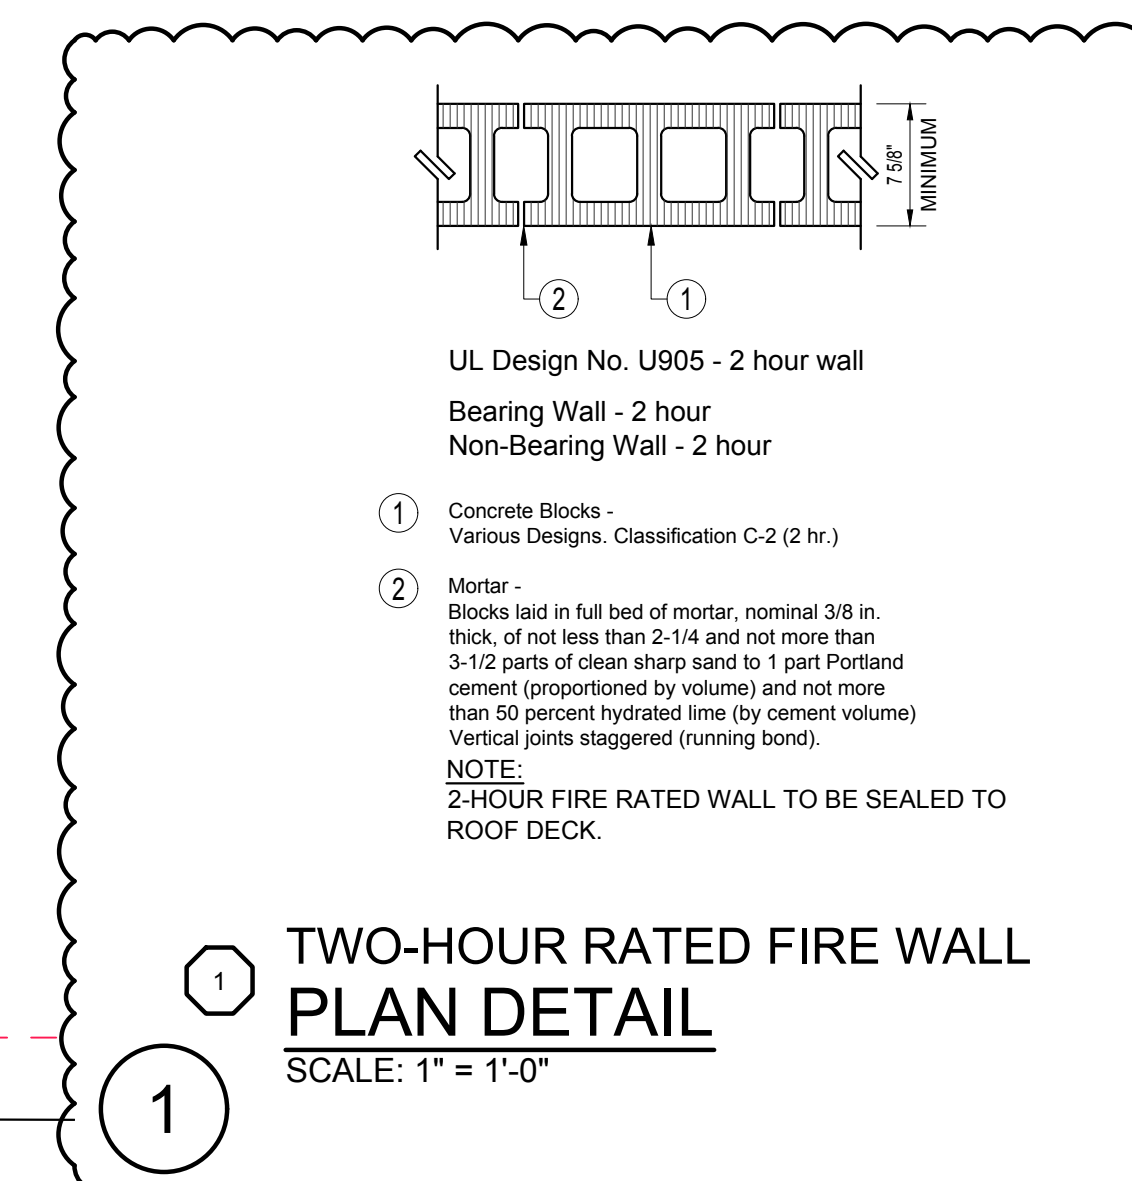


CAFETERIA PLUMBING CALCULATIONS	
2021 INTERNATIONAL PLUMBING CODE REQUIREMENTS: ASSEMBLY GROUP A-2 CAFETERIA (DAY-TO-DAY USE - TABLES AND CHAIRS SEATING)	
PLUMBING REQUIRED TOTAL:	
642 ÷ 20 = 662 OCCUPANTS -	
TOILETS (TABLE 2902.1)	
MEN (331) 1 PER 75 - 4.4 (5 REQUIRED)	
WOMEN (331) 1 PER 75 - 4.4 (5 REQUIRED)	
LAVATORIES (TABLE 2902.1)	
MEN (331) 1 PER 200 - 1.65 (2 REQUIRED)	
WOMEN (331) 1 PER 200 - 1.65 (2 REQUIRED)	
DRINKING FOUNTAINS (TABLE 2902.1), 1 PER 500 = 662/500 = 1.32	
2 REQUIRED	
SERVICE SINK (TABLE 2902.1):	
1 REQUIRED	
PLUMBING PROVIDED TOTAL	
TOILETS (TABLE 2902.1)	
MEN - 5 PROVIDED (3 wc / 2 urinals) UP TO 3 URINALS ALLOWED BY IPC 424.2	
WOMEN - 5 PROVIDED	
UNISEX - 2 PROVIDED	
LAVATORIES (TABLE 2902.1)	
MEN'S - 3 PROVIDED	
WOMEN'S - 3 PROVIDED	
UNISEX - 2 PROVIDED	
DRINKING FOUNTAINS (TABLE 2902.1)	
2 PROVIDED	
SERVICE SINK (TABLE 2902.1):	
1 PROVIDED	

EXIT CALCULATIONS	
TOTAL BUILDING AREA - NEW BUILDING ADDITION	
OCCUPANCY TYPE (SECTION 303):	GROUP A-2 ASSEMBLY CONSTRUCTION TYPE (SECTION 602): II-B SPRINKLERED
ALLOWABLE AREA:	38,000 SQ FT (TABLE 508.2)
ACTUAL AREA - 19,603 SQ FT CAFETERIA-KITCHEN ADDITION	
127,904 SQ FT EXISTING CLASSROOM BUILDING (CONNECTED)	
THE ADDITION WILL BE A 19,603 SQ FT SEPARATE BUILDING USING THE NEW FIRE WALL.	
ALLOWABLE HEIGHT (TABLE 504.3) ALLOWABLE # OF STORIES (TABLE 504.4)	
ALLOWABLE HEIGHT: 75 FEET	
ALLOWABLE NO. OF STORIES: 3	
ACTUAL BUILDING HEIGHT: 36 FEET	
ACTUAL NO. OF STORIES: 1	
OCCUPANT LOAD	
OCCUPANT LOAD TOTAL (1004 & TABLE 1004.5) =	
OCCUPANT LOAD - KITCHEN:	
20 PERSONS (2 EXITS REQUIRED, 2 EXITS PROVIDED)	
OCCUPANT LOAD - DINING:	
1418 PERSONS (4 EXITS REQUIRED, 4 EXITS PROVIDED)	
TOTAL CALCULATED OCCUPANT LOAD FOR EXITING - 1438	
EXIT REQUIREMENTS	
EXIT ACCESS (TABLE 1006.2.1 & TABLE 1006.3.3)	
NO. OF EXITS REQUIRED: 4	
OF EXITS FURNISHED: 6	
MEANS OF EGRESS WIDTH (1005.3)	
SEE PLAN FOR EXIT WIDTHS	
MINIMUM CORRIDOR WIDTH (TABLE 1020.3) 72"	

CODE PLAN - CAFETERIA/KITCHEN BUILDING  
SCALE: 1/8" = 1'-0"



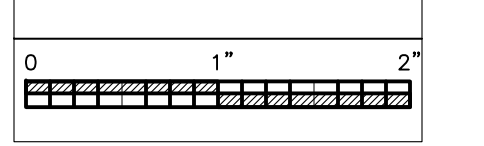
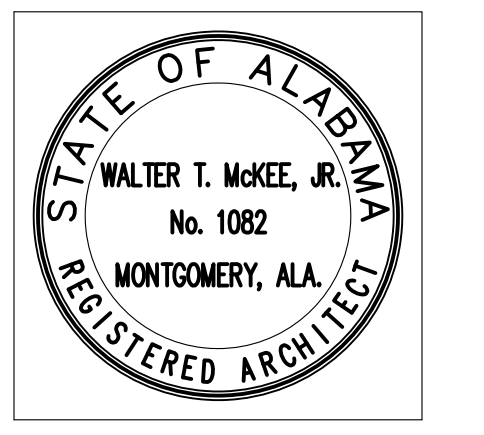


**WASTE SYMBOLS**

- FS-1 = FLOOR SINK, 8" X 8" SQUARE, WITH FULL TOP GRATE
- FS-2 = FLOOR SINK, 8" X 8" SQUARE, WITH HALF GRATE
- FS-3 = FLOOR SINK, 8" X 8" SQUARE, 10" DEEP, WITH HALF GRATE
- FS-4 = FLOOR SINK, 8" X 8" SQUARE, 10" DEEP, NO GRATE
- FD-1 = FLOOR DRAIN, WITH TYPE "A" STRAINER 5" TOP
- FT-1 = FLOOR TROUGH DRAIN W/4" TRAPPED CONNECTION INTO BOTTOM OUTLET. PROVIDE FLOOR RECESS TO ACCOMMODATE FLOOR TROUGH SIZE
- DW-1 = DIRECT WASTE, 1 1/2"
- IDW-1 = IN DIRECT WASTE, 1 1/2"
- FIELD CONNECTIONS


**FLOOR WASTE AND SPECIAL CONDITIONS NOTES**

1. ALL DRAINS DEDICATED FOR EQUIPMENT, INCLUDING FLOOR TROUGHS, MUST BE FLUSH WITH PLANE OF SURROUNDING FLOOR.
2. GENERAL PURPOSE FLOOR DRAINS, INCLUDING FLOOR SINKS, IN AREAS OF HIGH TRAFFIC MUST BE FLUSH WITH PLANE OF SURROUNDING FLOOR.
3. GENERAL PURPOSE FLOOR DRAINS, INCLUDING FLOOR SINKS, LOCATIONS MUST BE VERIFIED BY MECHANICAL CONTRACTOR/ENGINEER FOR ALL CODE REQUIREMENTS.

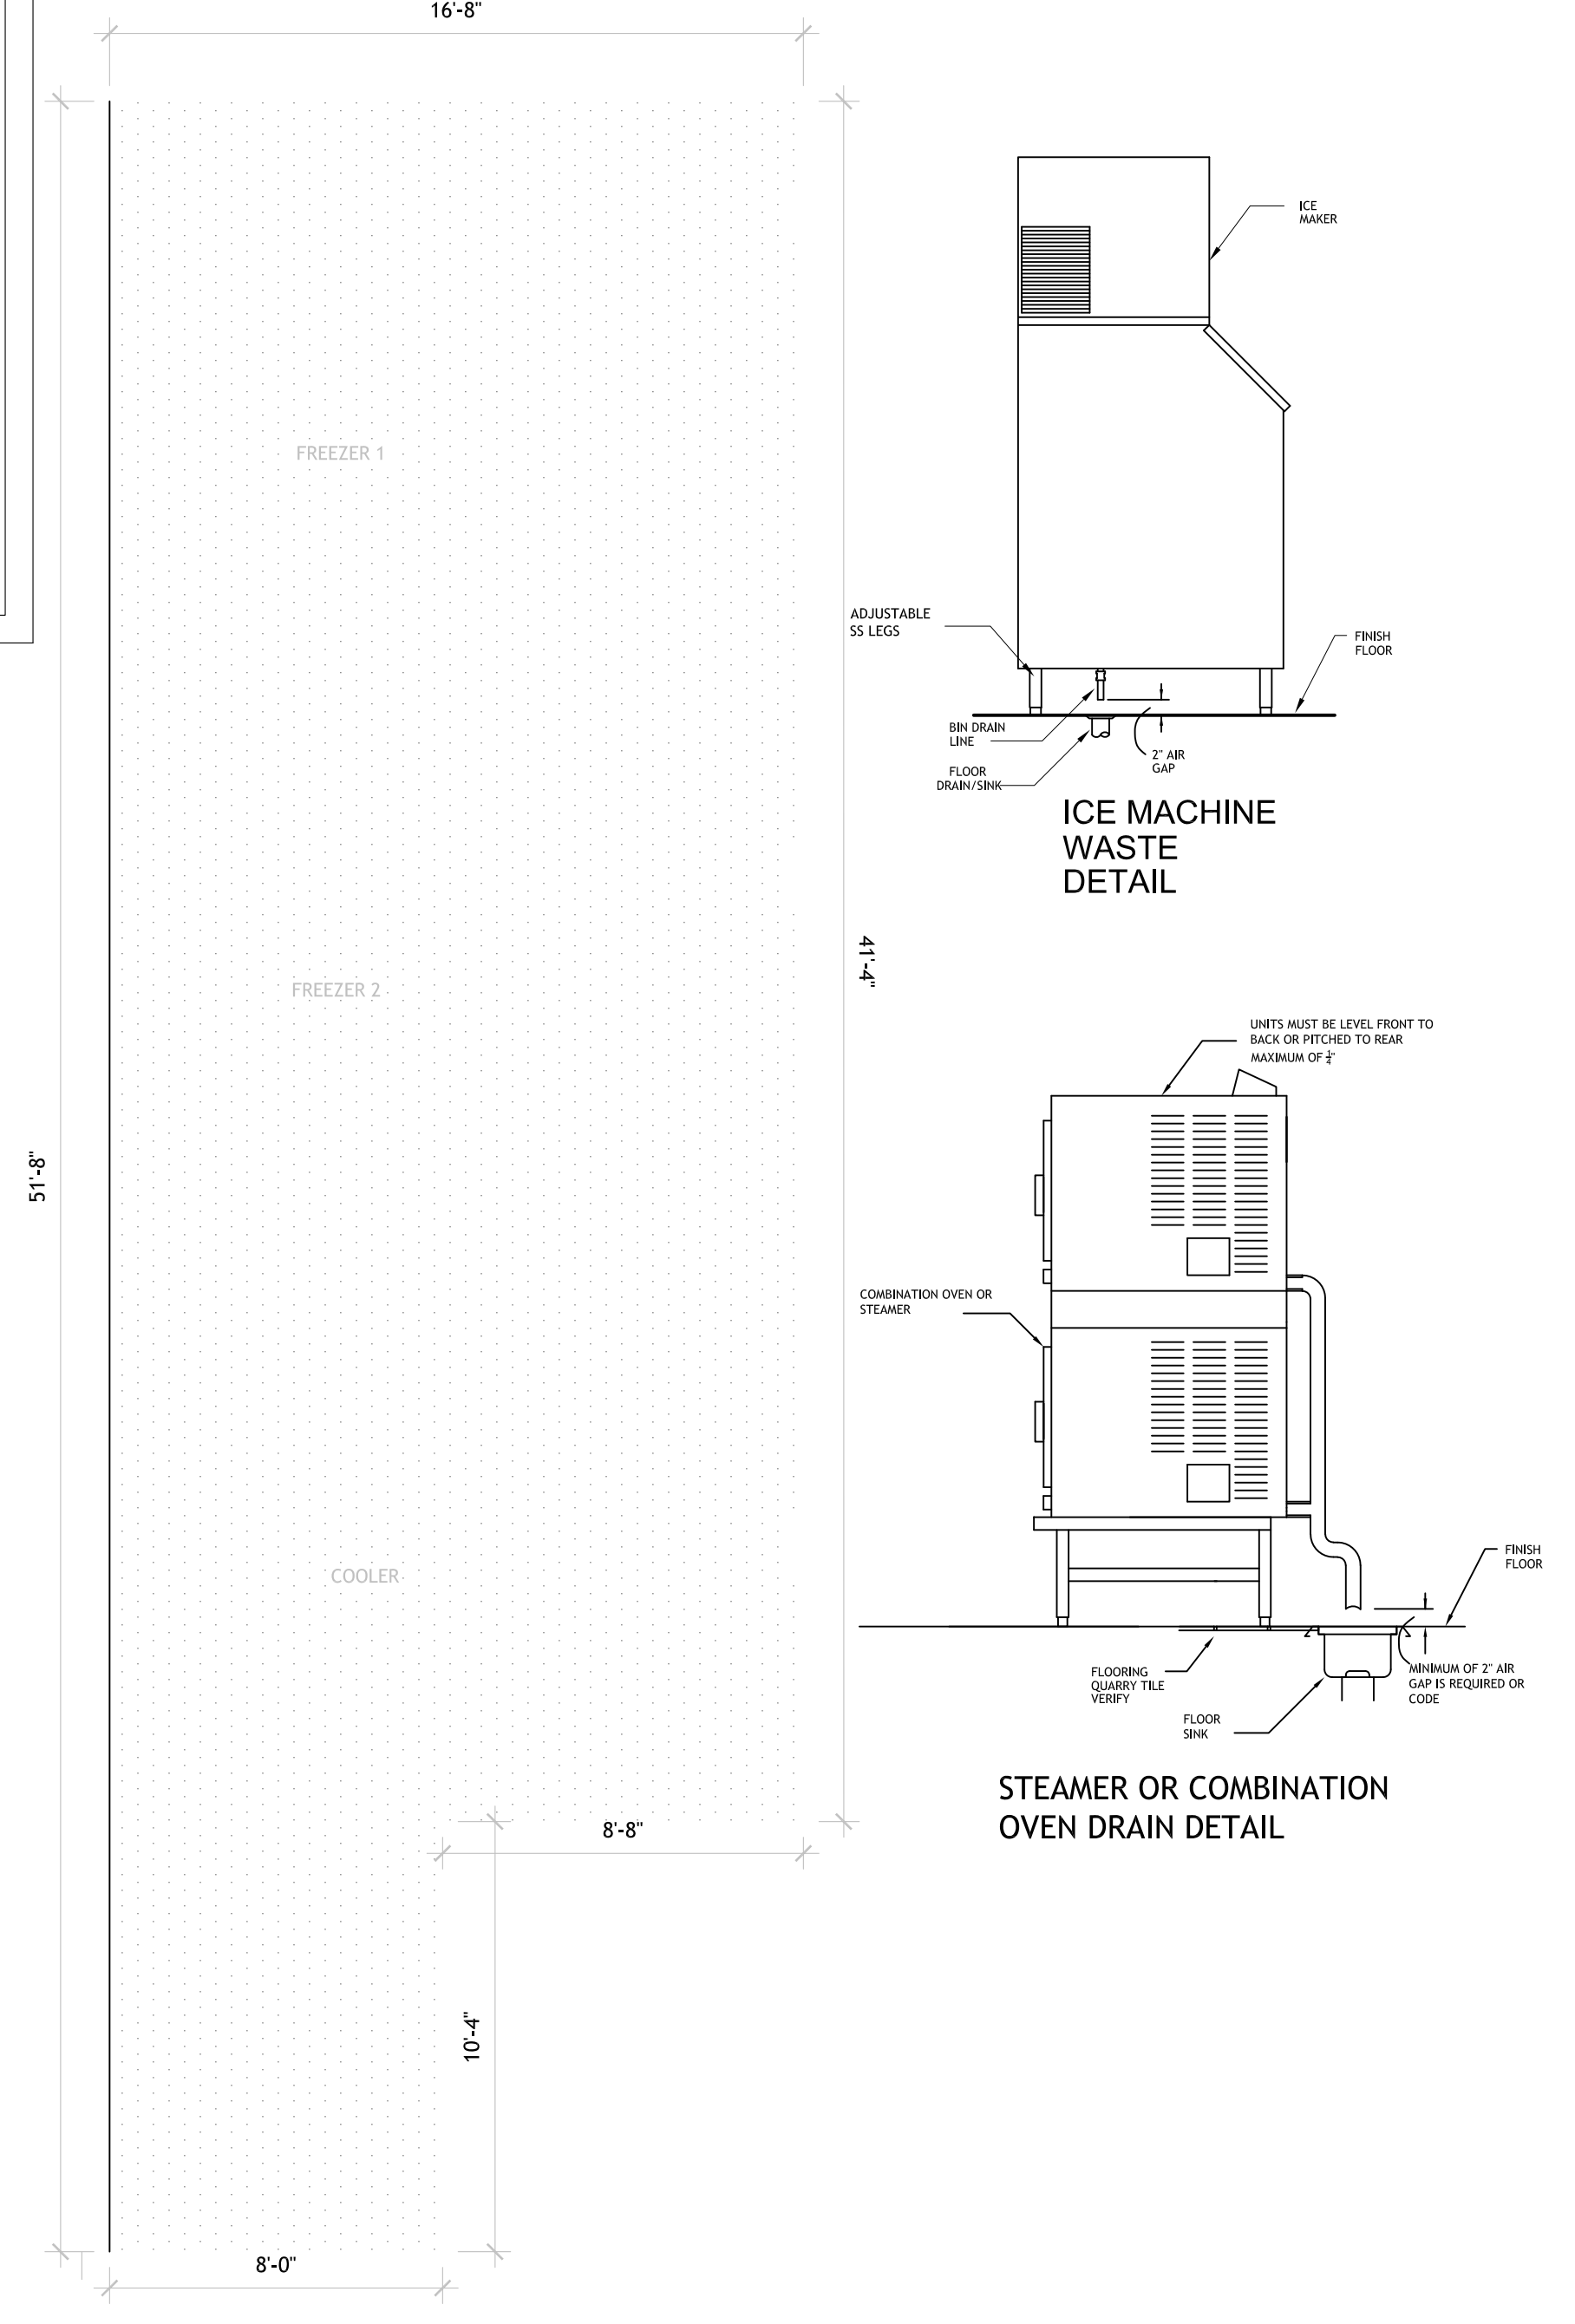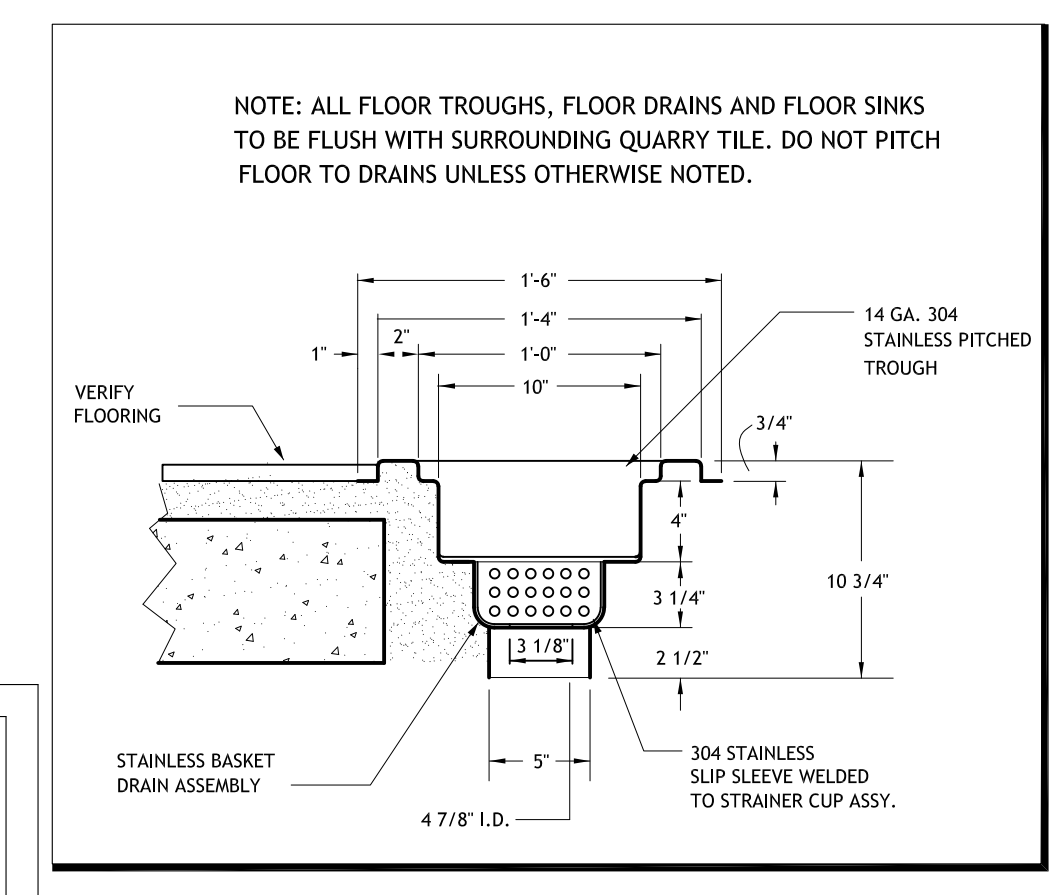


**RECESS FOR WALKINS  
FSC TO VERIFY**

**1 FOOD SERVICE WASTE  
FS-200 1/4" = 1'-0"**

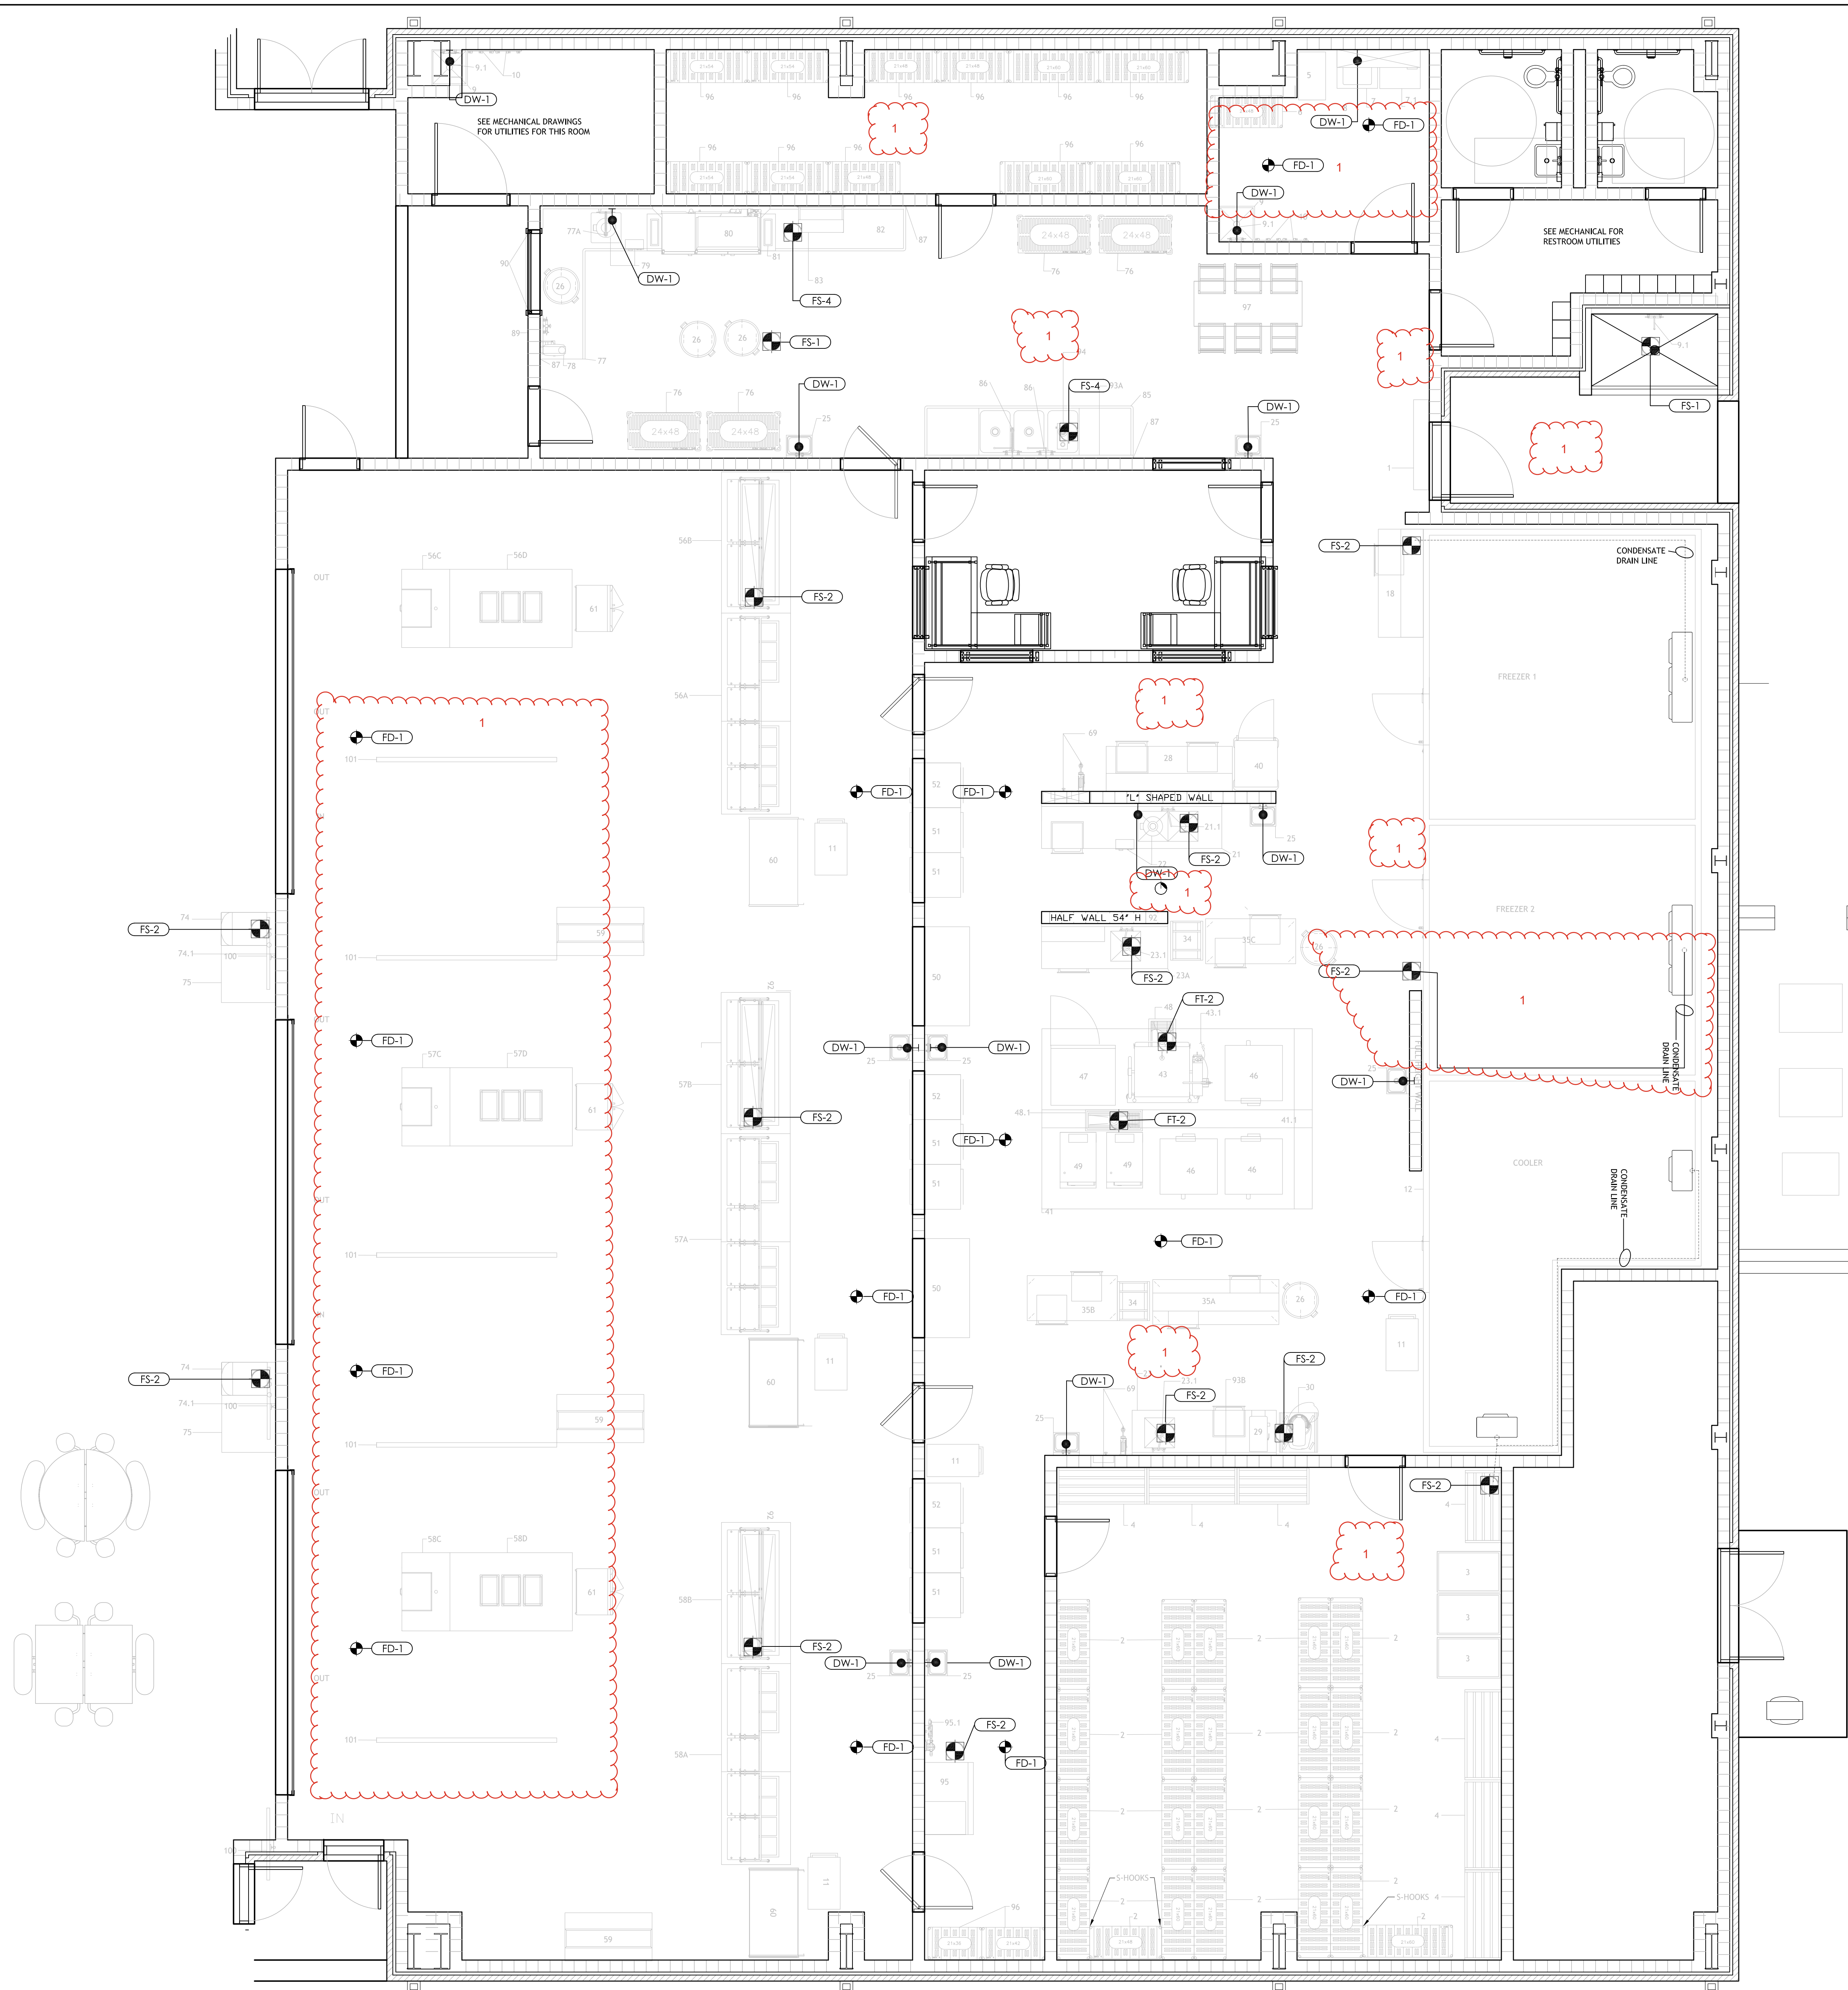



SHEET TITLE: OVERALL SANITARY NEW WORK PLAN

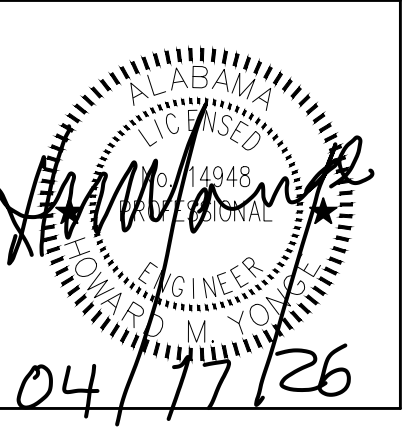

PROJ. MGR.:	H.M. YONGE
DRAWN:	D. B.
DATE:	03/25/26
REVISIONS	
#1	04/17/26 DCM COMMENTS


JOB NO.	25-160B
SHEET NO.	P1.0

**SANITARY WASTE GENERAL NOTES:**

1. CONTRACTOR SHALL REFER TO ARCHITECTURAL PLANS FOR LOCATIONS AND RATINGS OF FIRE-RATED WALLS AND SHALL PROVIDE UL APPROVED SLEEVES FOR ALL PIPING PENETRATIONS THROUGH RATED PARTITIONS AND FLOORS.
2. UNDERGROUND SANITARY WASTE AND VENT PIPING SHALL BE SMOKE TESTED PRIOR TO INSTALLATION OF PLUMBING FIXTURES.
3. OFFSET PIPING WITHIN CEILING SPACE AS REQUIRED TO LOCATE PIPE RISERS AND DROPS WITHIN WALLS AS SHOWN ON PLANS.
4. PROVIDE ALL FLOOR DRAINS, FLOOR SINKS, AND TRENCH DRAINS WITH TRAP PRIMER PIPING FROM A SELF-CONTAINED TRAP PRIMER DISTRIBUTION UNIT WITH 1/2" ISOLATION VALVE. MAXIMUM OF FOUR FIXTURES PER TRAP PRIMER UNIT. UNIT TO BE MOUNTED PER MANUFACTURER'S RECOMMENDATIONS.
5. ALL HORIZONTAL PORTIONS OF THE SANITARY WASTE PIPING SERVING FOR CONDENSATE DISPOSAL SHALL BE INSULATED WITH 1" THICK SECTIONAL FIBERGLASS INSULATION WITH AN "ASU" JACKET. INSULATION SHALL BE INSTALLED PER MANUFACTURER'S RECOMMENDATIONS. CONDENSATE DRAIN TRAP SHALL ALSO BE INSULATED.
6. PLUMBING DEVICES LOCATED IN WALLS, FLOORS, OR CEILINGS MUST BE FULLY SERVICE ACCESSIBLE. PRIOR TO INSTALLATION, PLUMBING CONTRACTOR SHALL COORDINATE LOCATION OF ACCESS PANELS WITH ARCHITECT AND OTHER CONTRACTORS WHOSE WORK MAY BE AFFECTED.
7. PLUMBING CONTRACTOR SHALL COORDINATE WITH THE MECHANICAL CONTRACTOR ALL VTRS AND ANY OTHER ROOF PENETRATIONS WITH ROOFTOP MECHANICAL EQUIPMENT AND OUTSIDE AIR INTAKES. A MINIMUM DISTANCE OF 12 FEET SHALL BE MAINTAINED BETWEEN ALL OUTSIDE AIR INTAKES AND VTRS PER 2021 IMC.
8. ALL PIPING PENETRATIONS OF FIRE-RATED BARRIERS SHALL BE SUFFICIENTLY PROTECTED TO MEET CURRENT CODE.


**SANITARY WASTE KEYNOTES:**

- 1 PROVIDE DRAIN WITH TRAPGUARD (OR EQUAL) AS A TRAP PRIMER ALTERNATE.
- 2 CLEANOUT TO BE COMPLETELY SERVICE ACCESSIBLE.
- 3 DRAIN FOR CONDENSATE DISPOSAL FROM HVAC EQUIPMENT. COORDINATE FINAL LOCATION OF DRAIN WITH HVAC CONTRACTOR. PLUMBING CONTRACTOR SHALL PROVIDE A SUFFICIENTLY SIZED AIR GAP FITTING AT DRAIN TO ACCOMMODATE HVAC EQUIPMENT AND AUXILIARY FAN CONDENSATE DRAINS.

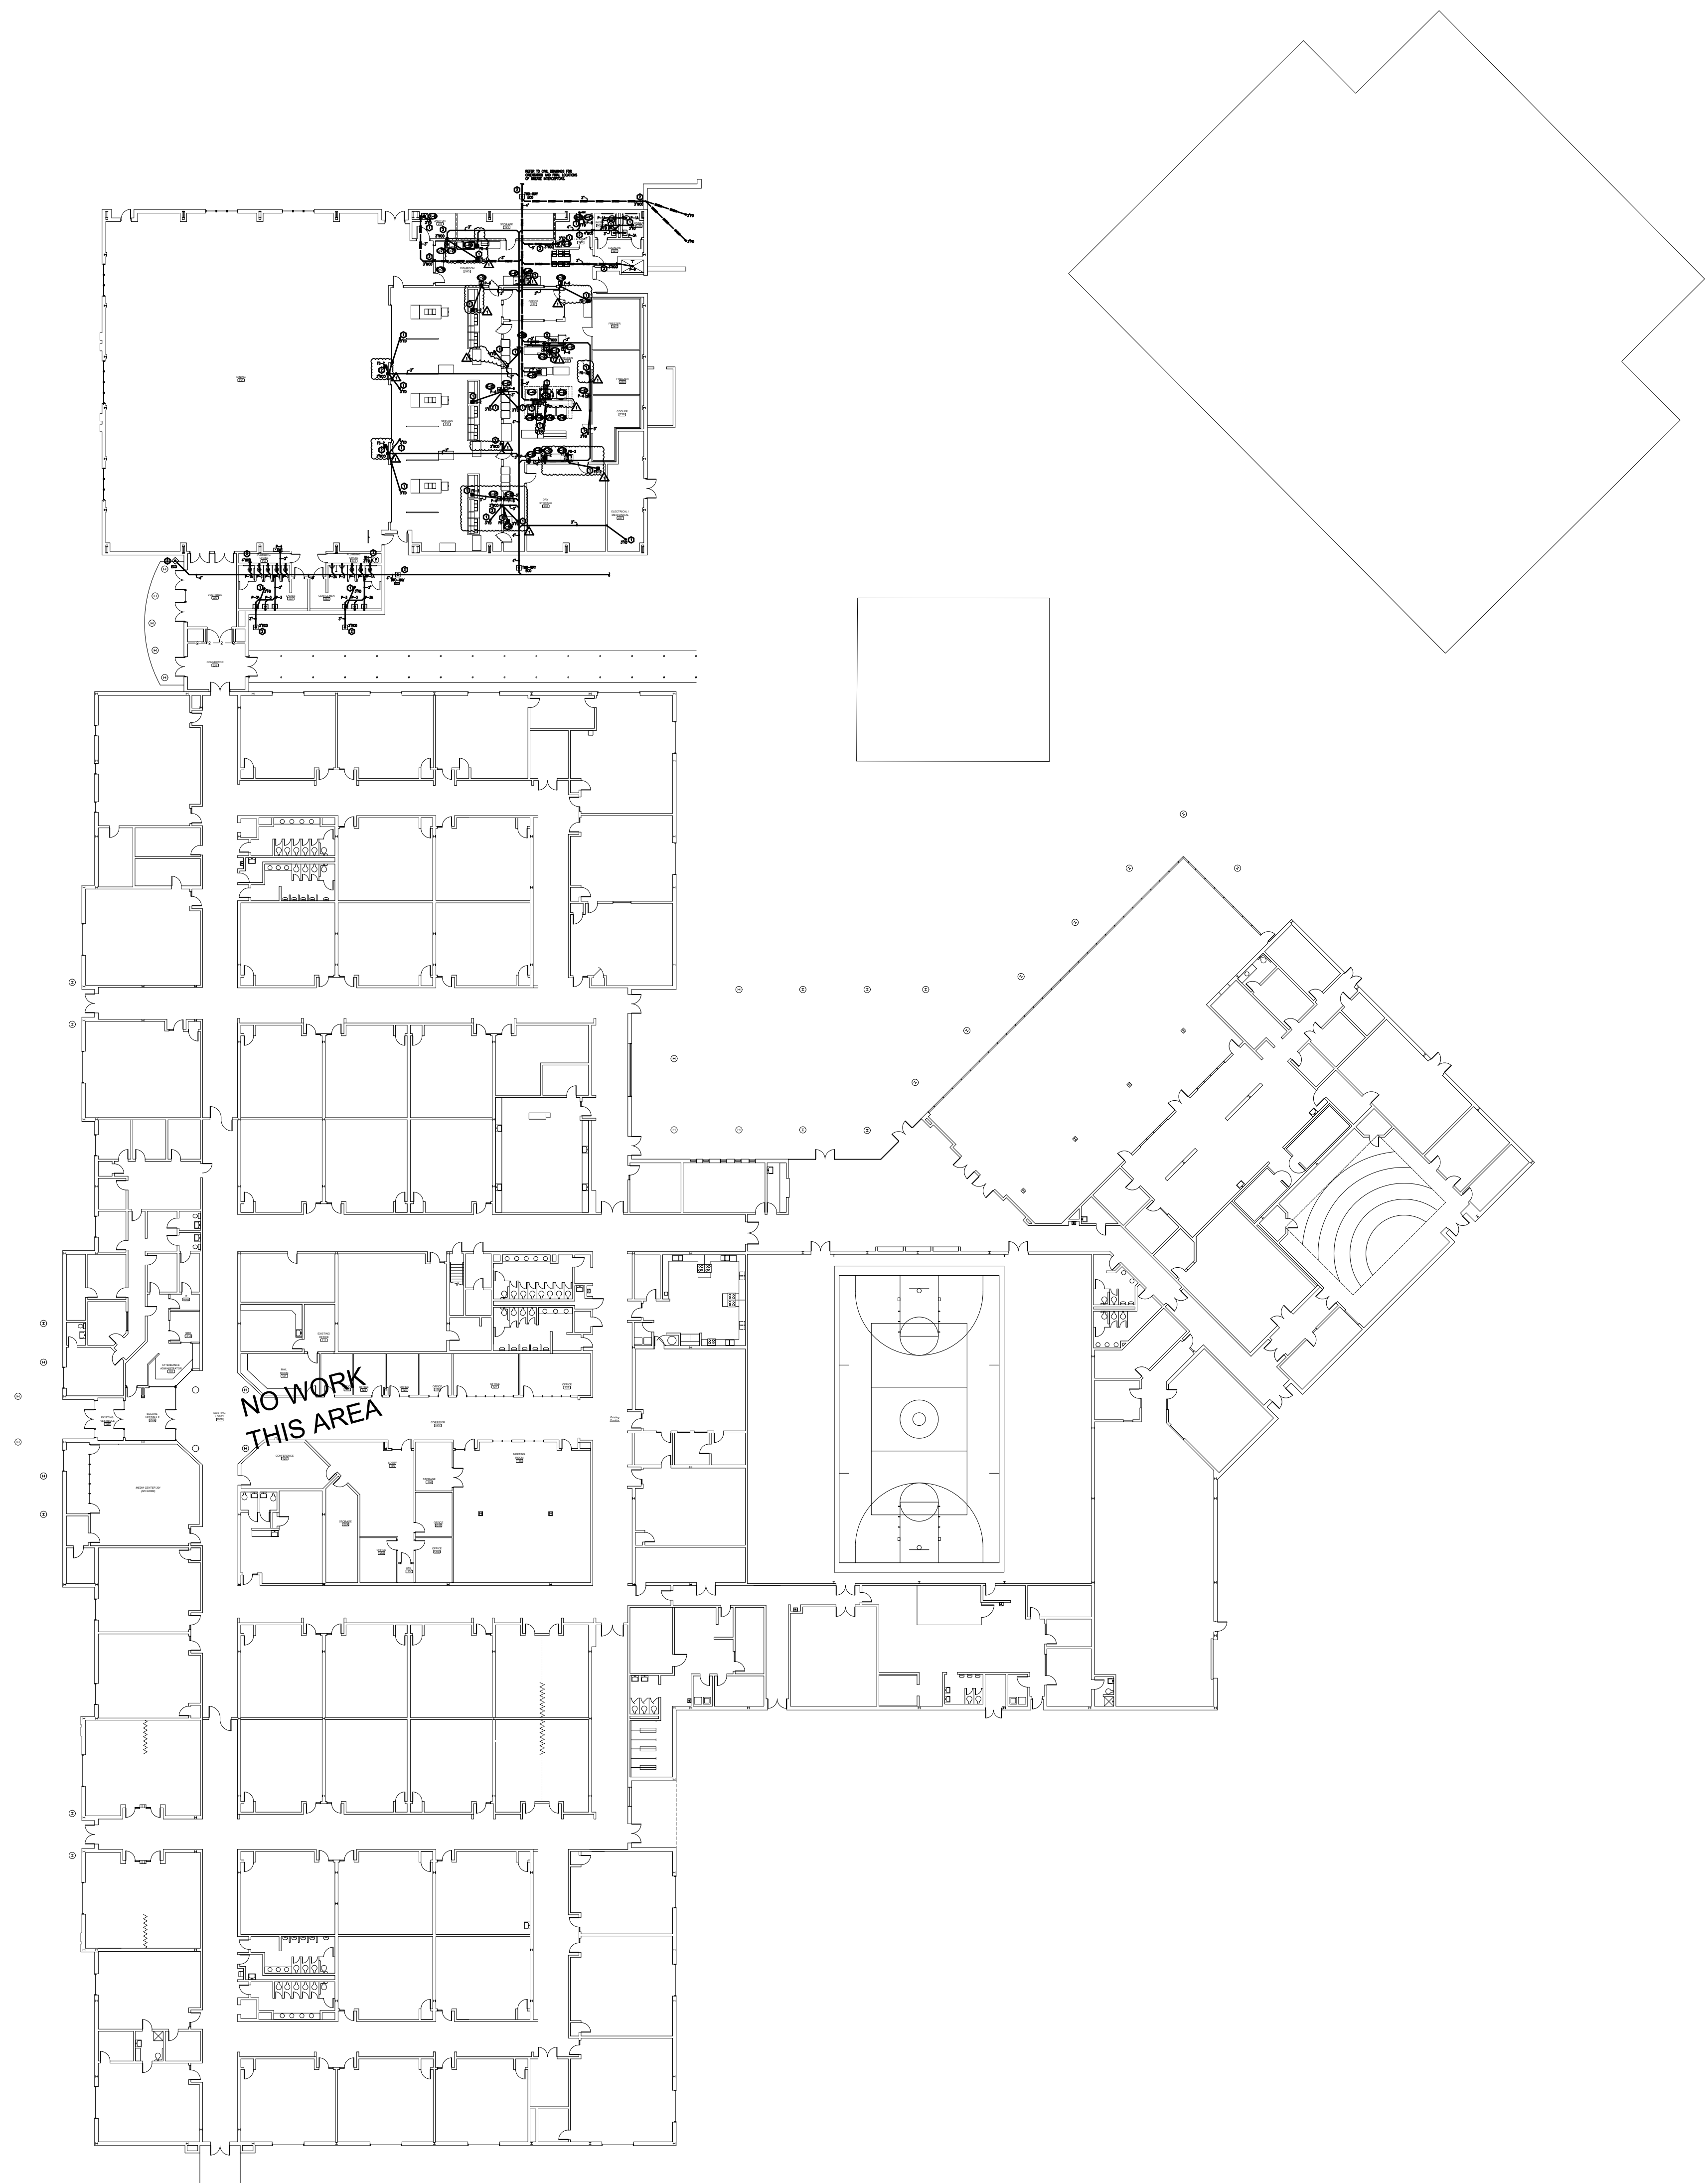

**OVERALL SANITARY NEW WORK PLAN**  
SCALE: 1" = 30'-0"


**H.M. YONGE & ASSOCIATES, INC.**  
CONSULTING ENGINEERS • EST. 1988  
51 EAST GREGORY STREET PENSACOLA, FLORIDA 32502  
253 ST. ANTHONY STREET MOBILE, ALABAMA 36603  
PHONE: (904)834-2061 PHONE: (251)950-7466

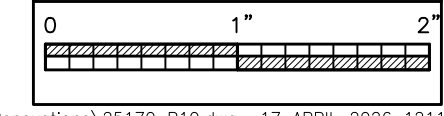



SITE IMPROVEMENTS AND  
INTERIOR ALTERATIONS TO  
FAIRHOPE HIGH SCHOOL  
ONE PIRATE DRIVE  
FAIRHOPE, ALABAMA 36529  
BALDWIN COUNTY PUBLIC SCHOOLS

SHEET TITLE: SANITARY NEW WORK PLAN -  
CAFETERIA-KITCHEN BUILDING

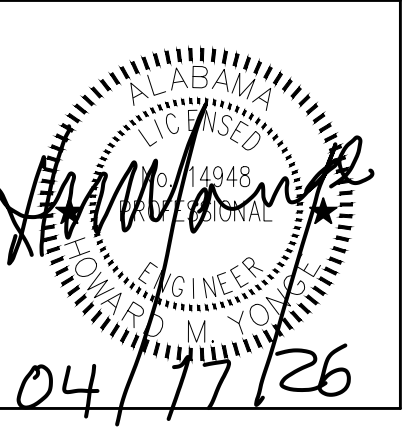

PROJ. MGR.:	H.M. YONGE
DRAWN:	D. B.
DATE:	03/25/26
REVISIONS	
#1	04/17/26 DCM COMMENTS


JOB NO.	25-160B
SHEET NO.	P1.1

**SANITARY WASTE GENERAL NOTES:**

- CONTRACTOR SHALL REFER TO ARCHITECTURAL PLANS FOR LOCATIONS AND RATINGS OF FIRE-RATED WALLS AND SHALL PROVIDE UL APPROVED SLEEVES FOR ALL PIPING PENETRATIONS THROUGH RATED PARTITIONS AND FLOORS.
- UNDERGROUND SANITARY WASTE AND VENT PIPING SHALL BE SMOKE TESTED PRIOR TO INSTALLATION OF PLUMBING FIXTURES.
- OFFSET PIPING WITHIN CEILING SPACE AS REQUIRED TO LOCATE PIPE RISERS AND DROPS WITHIN WALLS AS SHOWN ON PLANS.
- PROVIDE ALL FLOOR DRAINS, FLOOR SINKS, AND TRENCH DRAINS WITH TRAP PRIMER PIPING FROM A SELF-CONTAINED TRAP PRIMER DISTRIBUTION UNIT WITH 1/2" ISOLATION VALVE. MAXIMUM OF FOUR FIXTURES PER TRAP PRIMER UNIT. UNIT TO BE MOUNTED PER MANUFACTURER'S RECOMMENDATIONS.
- ALL HORIZONTAL PORTIONS OF THE SANITARY WASTE PIPING SERVING FOR CONDENSATE DISPOSAL SHALL BE INSULATED WITH 1" THICK SECTIONAL FIBERGLASS INSULATION WITH AN "ASJ" JACKET. INSULATION SHALL BE INSTALLED PER MANUFACTURER'S RECOMMENDATIONS. CONDENSATE DRAIN TRAP SHALL ALSO BE INSULATED.
- PLUMBING DEVICES LOCATED IN WALLS, FLOORS, OR CEILINGS MUST BE FULLY SERVICE ACCESSIBLE. PRIOR TO INSTALLATION, PLUMBING CONTRACTOR SHALL COORDINATE LOCATION OF ACCESS PANELS WITH ARCHITECT AND OTHER CONTRACTORS WHOSE WORK MAY BE AFFECTED.
- PLUMBING CONTRACTOR SHALL COORDINATE WITH THE MECHANICAL CONTRACTOR ALL VTRS AND ANY OTHER ROOF PENETRATIONS WITH ROOFTOP MECHANICAL EQUIPMENT AND OUTSIDE AIR INTAKES. A MINIMUM DISTANCE OF 12 FEET SHALL BE MAINTAINED BETWEEN ALL OUTSIDE AIR INTAKES AND VTRS PER 2021 IMC.
- ALL PIPING PENETRATIONS OF FIRE-RATED BARRIERS SHALL BE SUFFICIENTLY PROTECTED TO MEET CURRENT CODE.
- ALL FLOOR SINKS AND FLOOR TROUGHS SHALL BE SET NO HIGHER THAN FLUSH WITH FINISHED FLOOR.


**SANITARY WASTE KEYNOTES:**

- PROVIDE DRAIN WITH TRAPGUARD (OR EQUAL) AS A TRAP PRIMER ALTERNATE.
- CLEANOUT TO BE COMPLETELY SERVICE ACCESSIBLE.
- DRAIN FOR CONDENSATE DISPOSAL FROM HVAC EQUIPMENT. COORDINATE FINAL LOCATION OF DRAIN WITH HVAC CONTRACTOR. PLUMBING CONTRACTOR SHALL PROVIDE A SUFFICIENTLY SIZED AIR CAP FITTING AT DRAIN TO ACCOMMODATE HVAC EQUIPMENT AND AUXILIARY PAN CONDENSATE DRAINS.

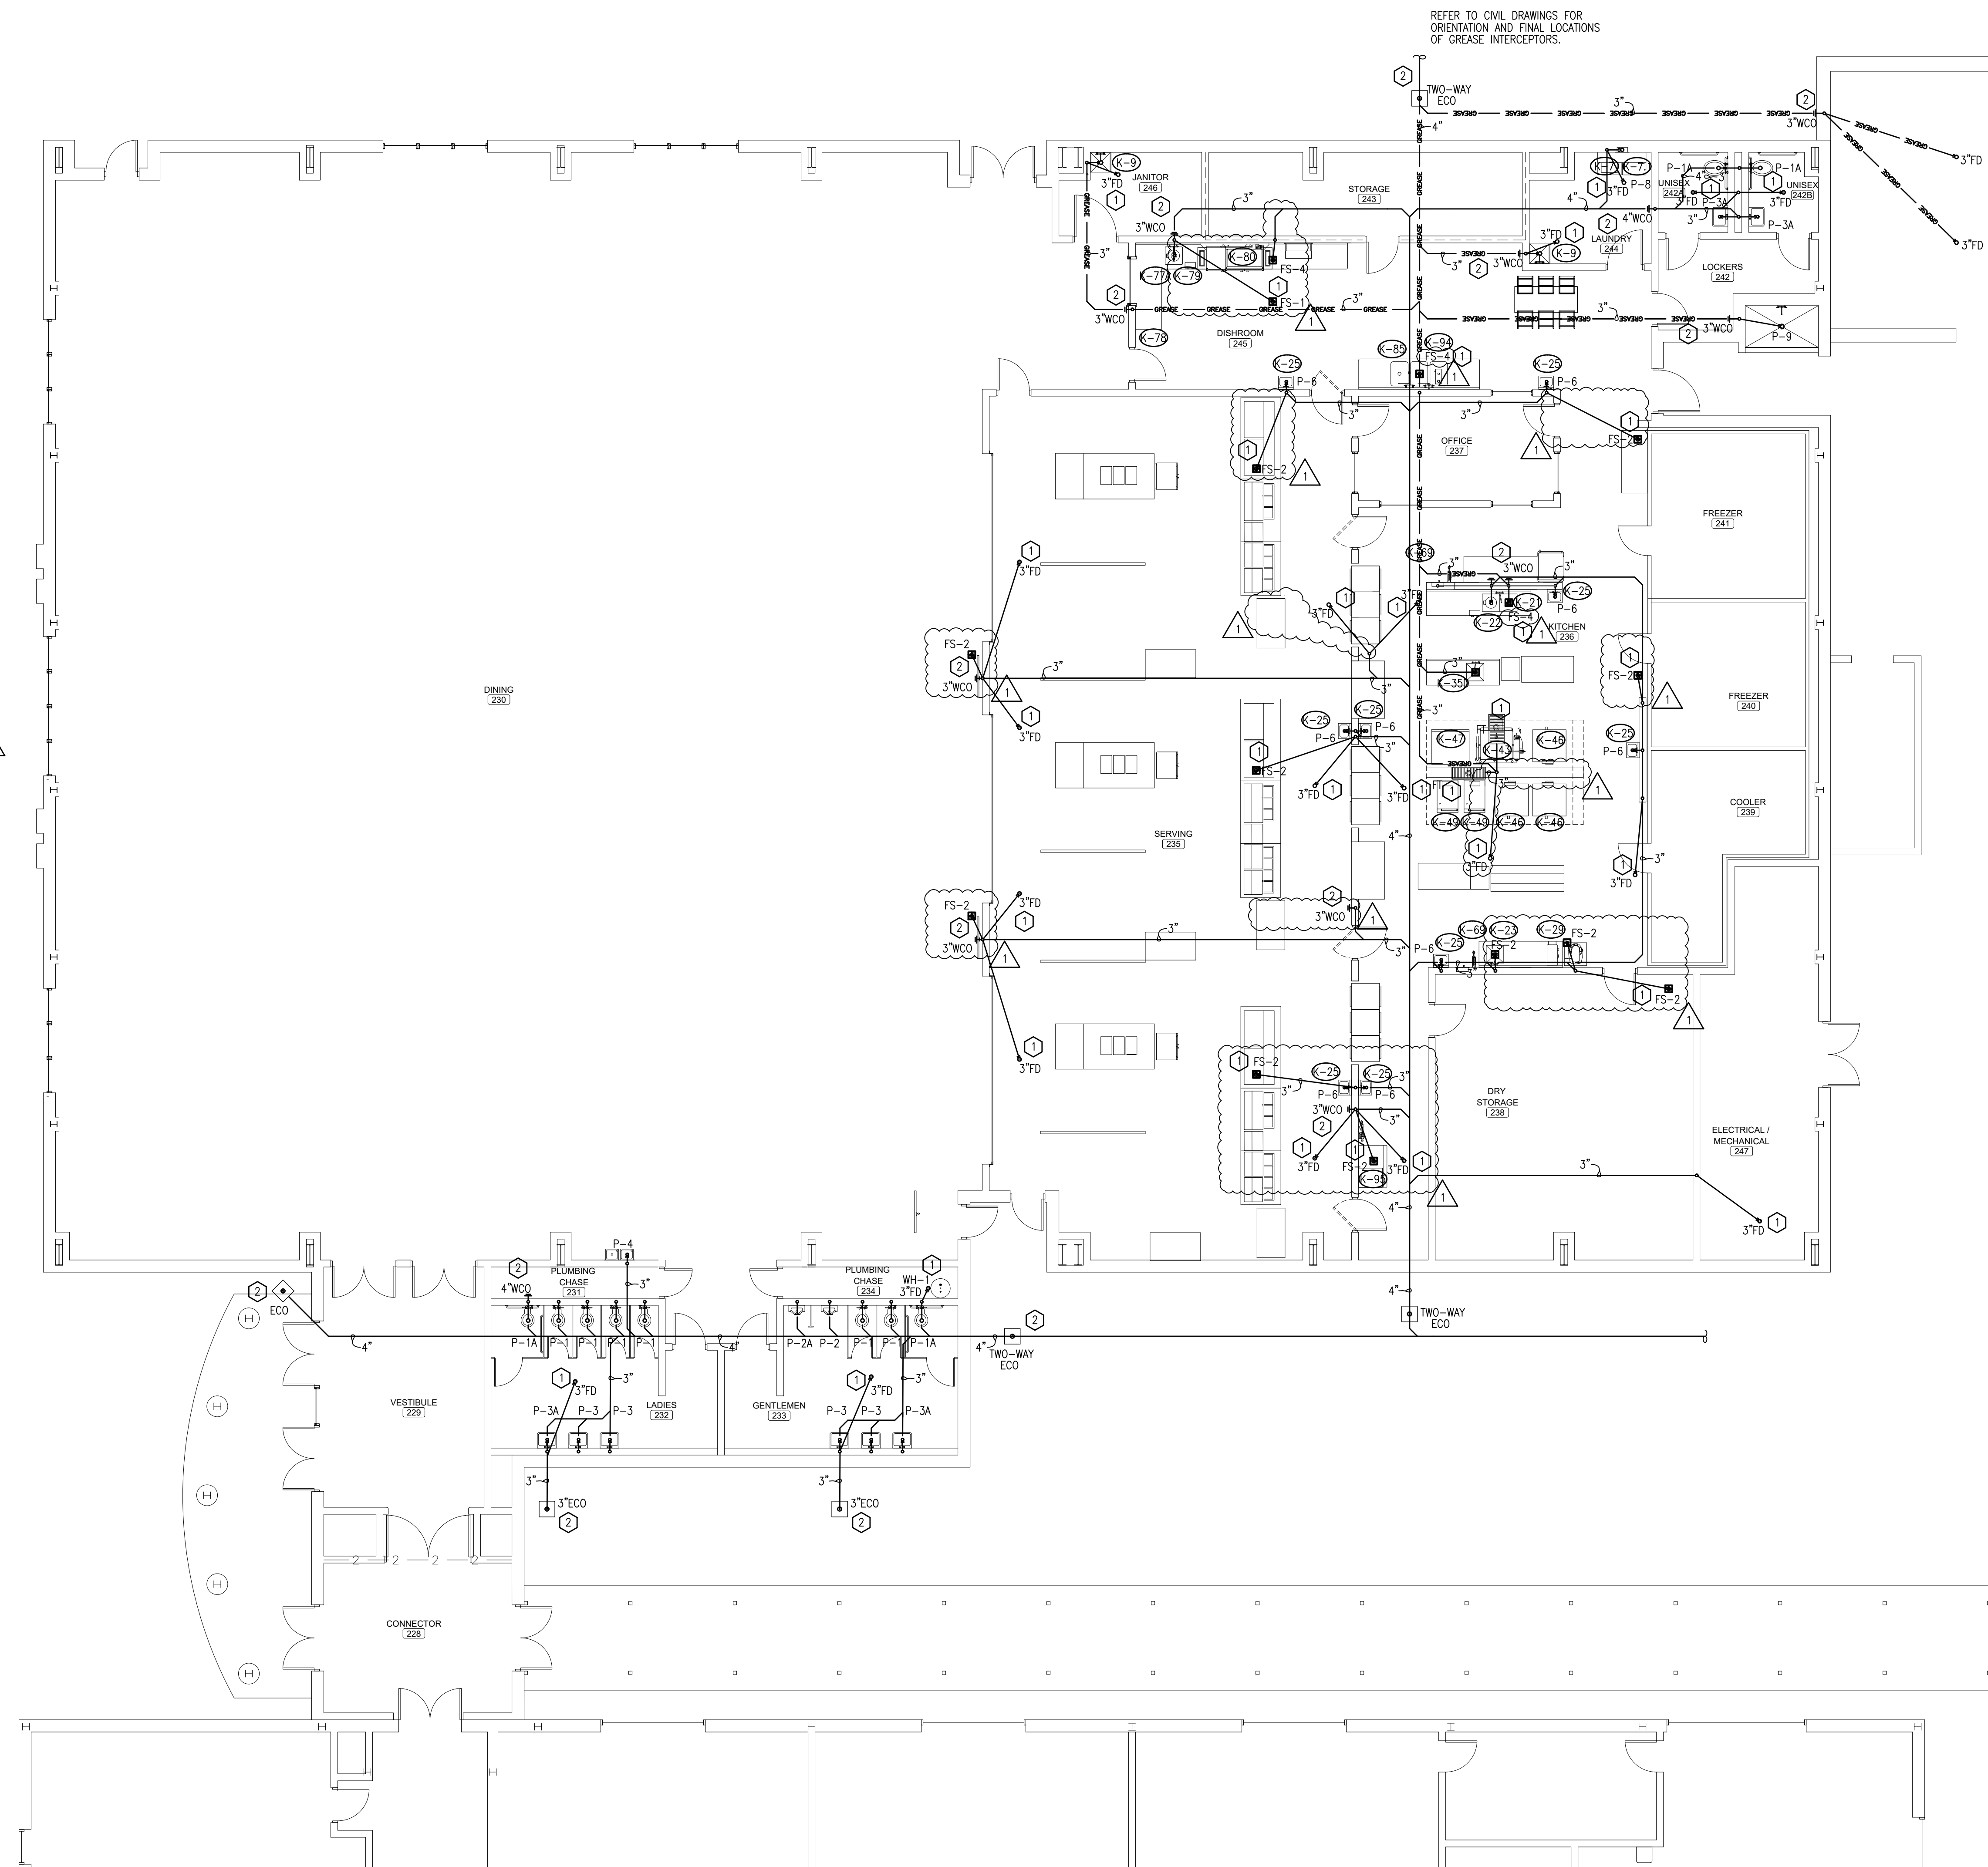

**SANITARY NEW WORK PLAN -  
CAFETERIA-KITCHEN BUILDING**  
SCALE: 1/8" = 1'-0"

**H.M. YONGE & ASSOCIATES, INC.**  
CONSULTING ENGINEERS • EST. 1988  
51 EAST GREGORY STREET PENSACOLA, FLORIDA 32502  
253 ST. ANTHONY STREET MOBILE, ALABAMA 36603  
PHONE: (904)834-2061 PHONE: (251)950-7466

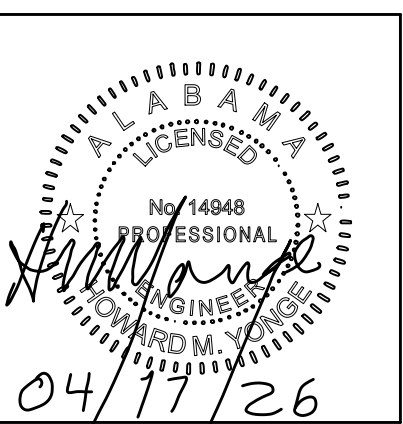


PROJ. MGR.:	H.M. YONGE
DRAWN:	D. B.
DATE:	03/25/26
REVISIONS	
#1	04/17/26 DCM COMMENTS

JOB NO. 25-160B

SHEET NO:

**P2.1**

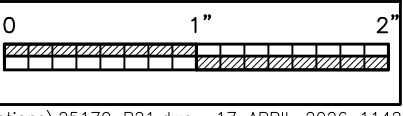


**DOMESTIC WATER GENERAL NOTES:**

- CONTRACTOR SHALL REFER TO ARCHITECTURAL PLANS FOR LOCATIONS AND RATINGS OF FIRE-RATED WALLS AND SHALL PROVIDE UL APPROVED SLEEVES FOR ALL PIPING PENETRATIONS THROUGH RATED PARTITIONS AND FLOORS.
- OFFSET PIPING WITHIN CEILING SPACE AS REQUIRED TO LOCATE PIPE RISERS AND DROPS WITHIN WALLS AS SHOWN ON PLANS.
- ALL FIXTURES MUST BE PROVIDED WITH STOPS. THOSE STOPS MUST BE FULLY ACCESSIBLE.
- SINKS LOCATED IN PUBLIC AREAS MUST BE INSTALLED IN ACCORDANCE WITH ADA REQUIREMENTS.
- PROVIDE ALL FLOOR DRAINS, FLOOR SINKS, AND TRENCH DRAINS WITH TRAP PRIMER PIPING FROM A SELF-CONTAINED TRAP PRIMER DISTRIBUTION UNIT WITH 1/2" ISOLATION VALVE. MAXIMUM OF FOUR FIXTURES PER TRAP PRIMER UNIT. UNIT TO BE MOUNTED PER MANUFACTURER'S RECOMMENDATIONS.
- PLUMBING DEVICES LOCATED IN WALLS, FLOORS, OR CEILINGS MUST BE FULLY SERVICE ACCESSIBLE PRIOR TO INSTALLATION. PLUMBING CONTRACTOR SHALL COORDINATE LOCATION OF ACCESS PANELS WITH ARCHITECT AND OTHER CONTRACTORS WHOSE WORK MAY BE AFFECTED.
- PLUMBING CONTRACTOR SHALL COORDINATE WITH THE MECHANICAL CONTRACTOR ALL VIT'S AND ANY OTHER ROOF PENETRATIONS WITH ROOFTOP MECHANICAL EQUIPMENT AND OUTSIDE AIR INTAKES. A MINIMUM DISTANCE OF 12 FEET SHALL BE MAINTAINED BETWEEN ALL OUTSIDE AIR INTAKES AND VIT'S PER 2015 IMC.
- ALL PIPING PENETRATIONS OF FIRE-RATED BARRIERS SHALL BE SUFFICIENTLY PROTECTED TO MEET CURRENT CODE.

**DOMESTIC WATER KEYNOTES:**

- EXTEND TRAP PRIMER PIPING FROM FLOOR DRAIN UP INSIDE WALL FOR CONNECTION TO A SELF-CONTAINED TRAP PRIMER DISTRIBUTION UNIT.
- CONNECTIONS TO UTILITY DISTRIBUTION SYSTEM, UDS, CONNECTIONS SHALL INCLUDE FOR DOMESTIC COLD WATER, FOR DOMESTIC HOT WATER, AND FOR NATURAL GAS. REFER TO MANUFACTURER'S DATA FOR FURTHER INFORMATION.
- UNITS SHALL BE PROVIDED WITH BACKFLOW PROTECTION COMPLYING TO 2021 IPC 608.3.
- FOR SHUTOFF OF NATURAL GAS TO KITCHEN APPLIANCES BY AIR CONDITIONING REFRIGERANT MONITOR. REFERENCE HVAC PLANS.

ANY EXPOSED UTILITY LINES, PLUMBING LINES, AND DRAIN LINES BEHIND THE EQUIPMENT UNDER THE HOOD SHALL BE INSTALLED SUCH THAT THEY DO NOT OBSTRUCT EFFORTS TO CLEAN FLOORS, WALLS, OR THE HOOD. ANY HORIZONTAL LINES IN THIS AREA SHALL BE A MINIMUM OF 1'-6" ABOVE THE FINISHED FLOOR TO ELIMINATE THEIR CAUSING ANY OBSTRUCTION TO CLEANING EFFORTS.

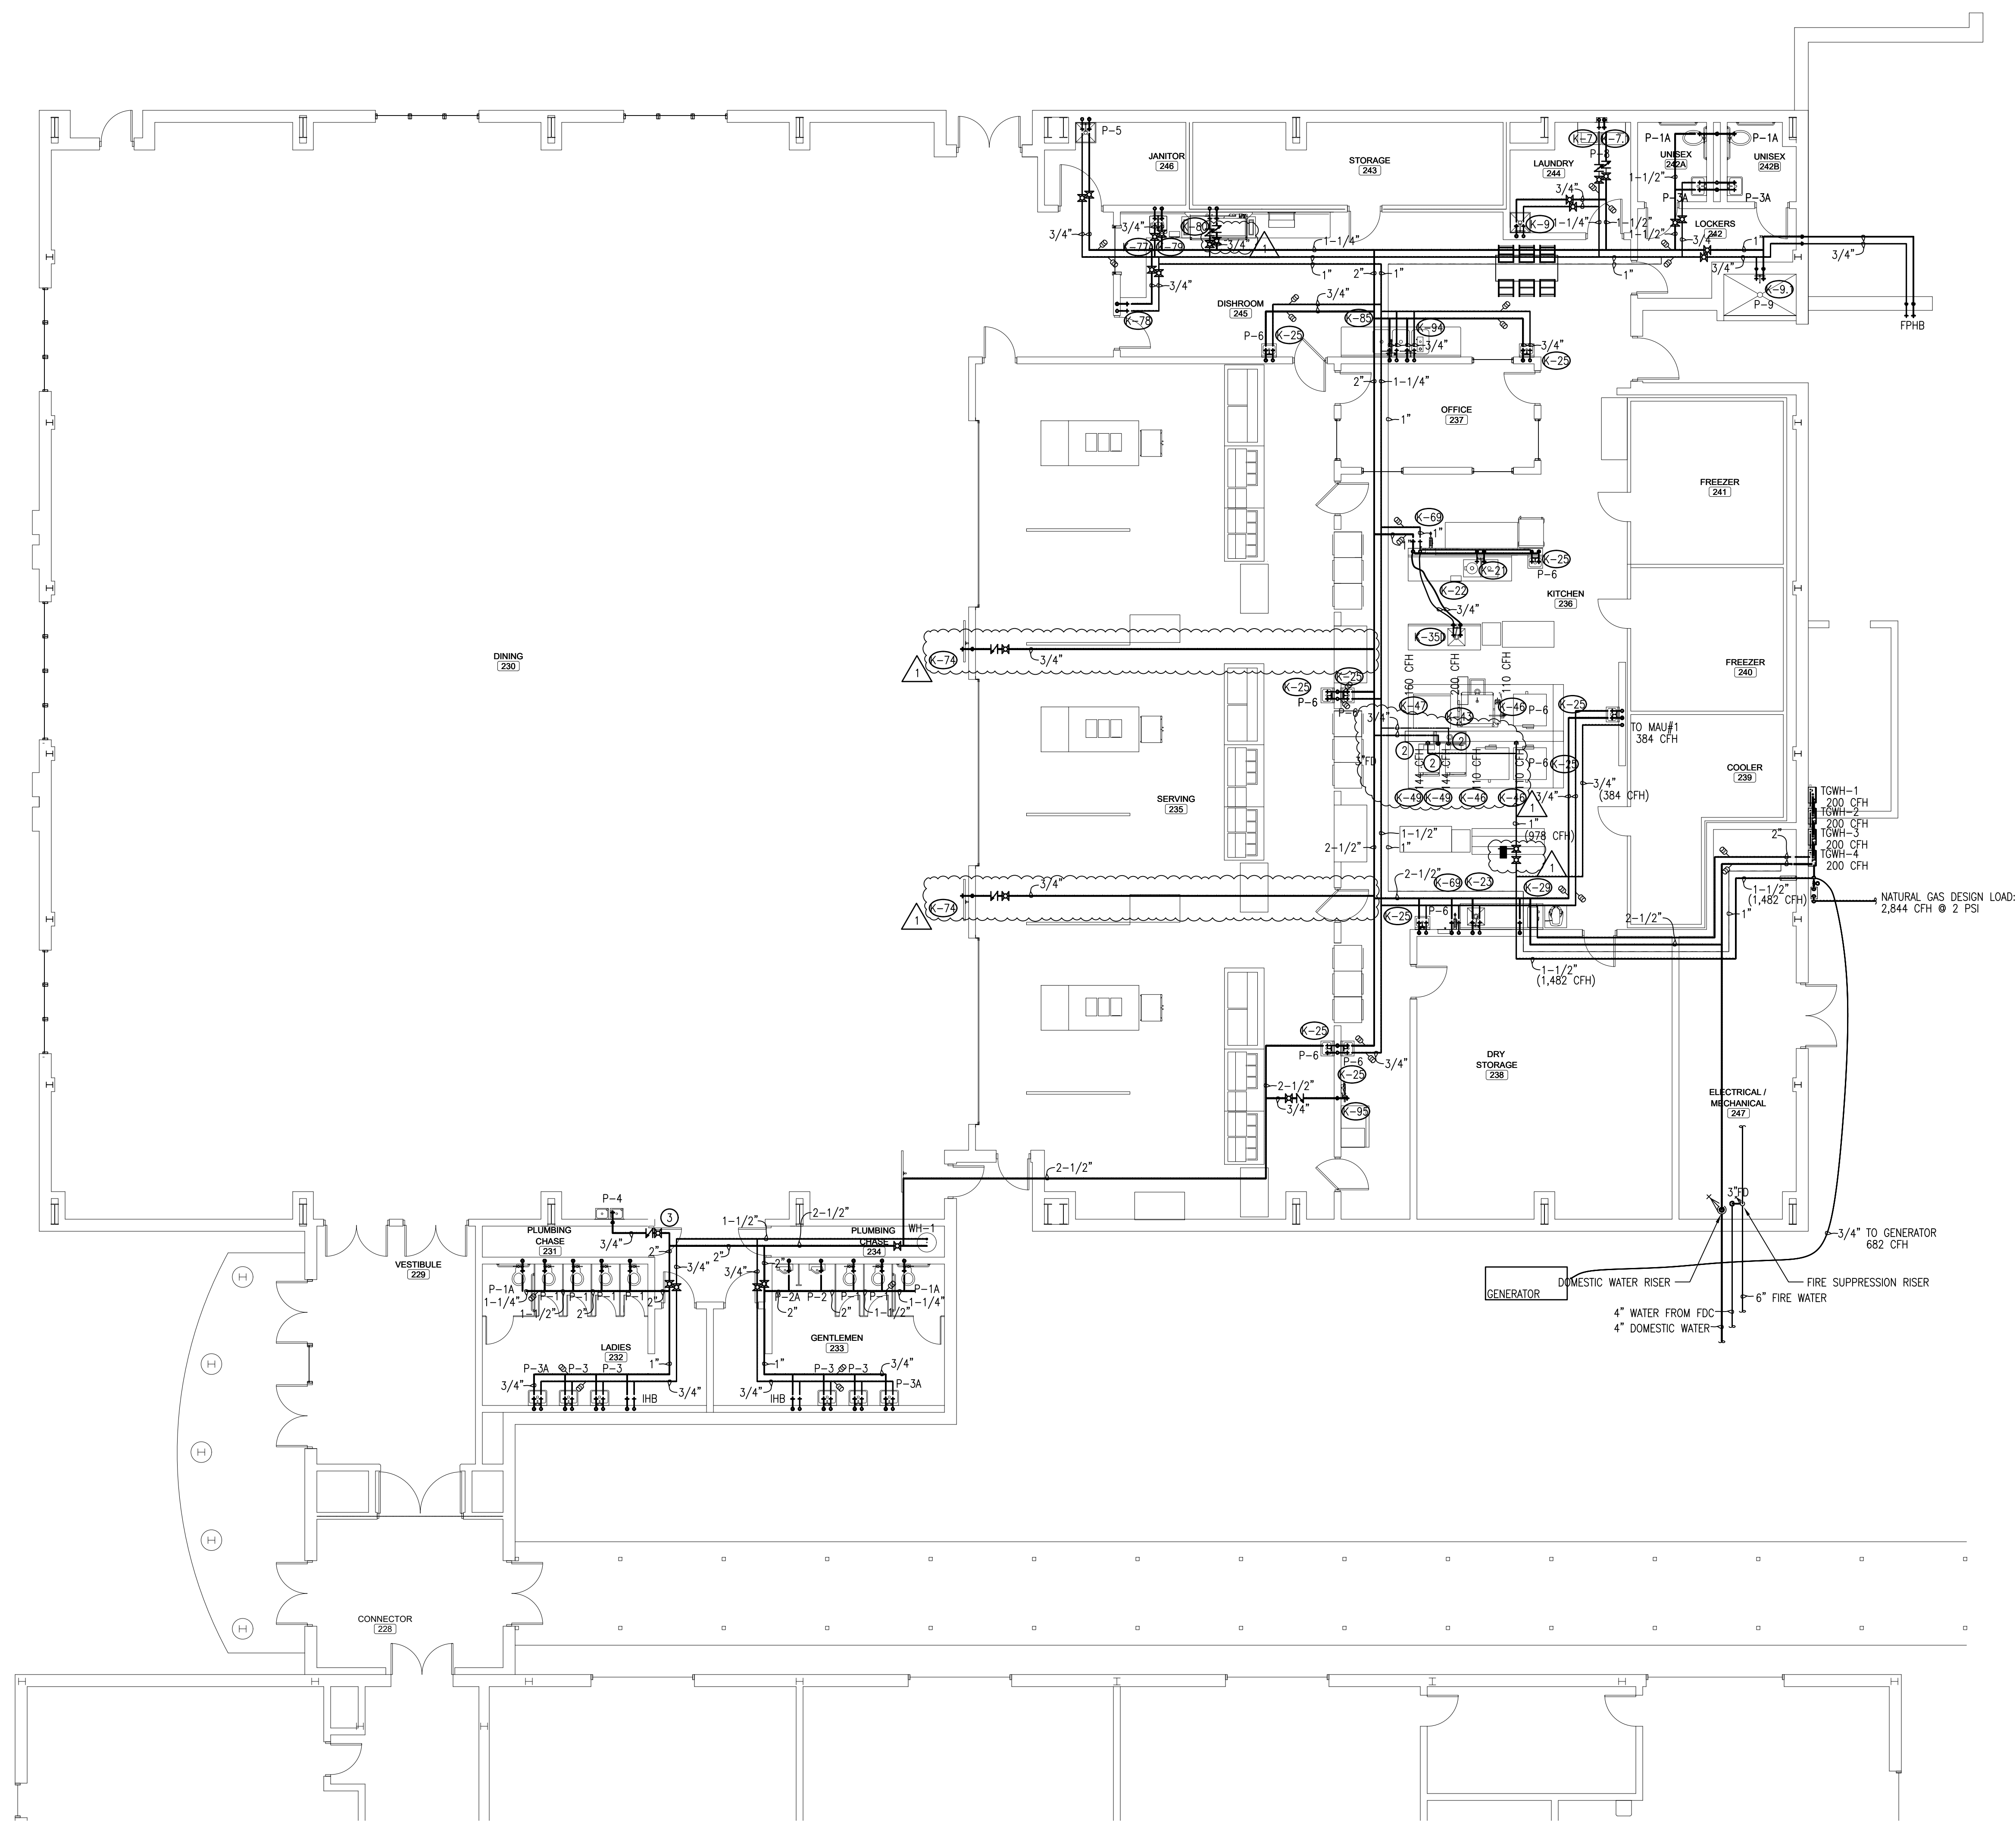

**DOMESTIC WATER NEW WORK PLAN -  
CAFETERIA-KITCHEN BUILDING**  
SCALE: 1/8" = 1'-0"

**H.M. YONGE & ASSOCIATES, INC.**  
CONSULTING ENGINEERS • EST. 1988  
51 EAST GREGORY STREET PENSACOLA, FLORIDA 32502  
253 ST. ANTHONY STREET MOBILE, ALABAMA 36603  
PHONE: 904-934-2061 PHONE: 251-950-7468



**SITE IMPROVEMENTS AND  
INTERIOR ALTERATIONS TO  
FAIRHOPE HIGH SCHOOL**  
ONE PIRATE DRIVE,  
FAIRHOPE, ALABAMA 36530  
BALDWIN COUNTY PUBLIC SCHOOLS

**KITCHEN EQUIPMENT LISTING**


- (K-7) CLOTHES WASHER
- (C-7) CLOTHES DRYER
- (K-9) MOP SINK
- (C-9) SERVICE FAUCETS
- (C-2) DOUBLE SINK
- (C-2) DISPOSAL
- (C-2) SINK
- (C-2) HAND SINK
- (C-2) WASTE RECEPTICAL
- (C-2) HOT WATER DISPENSER
- (C-3) WORK TABLE WITH SINK
- (C-4) UTILITY DISTRIBUTION SYSTEM
- (C-4) GAS BRAISING PAN
- (C-4) GAS CONVECTION DOUBLE STACK OVEN
- (C-4) GAS COMBINATION DOUBLE STACK OVEN
- (C-4) FLOOR TROUGH
- (C-4) GAS STEAMER
- (C-6) HOSE REEL
- (C-7) ICE MACHINE
- (C-7) PRE-RINSE FAUCET
- (C-7) HOSE REEL
- (C-7) DISPOSAL
- (C-8) DISHWASHER
- (C-8) TRIPLE SINK
- (C-8) SINK HEATER
- (C-9) ICE MACHINE

**SANITARY WASTE GENERAL NOTES:**


1. CONTRACTOR SHALL REFER TO ARCHITECTURAL PLANS FOR LOCATIONS AND RATINGS OF FIRE-RATED WALLS AND SHALL PROVIDE UL APPROVED SLEEVES FOR ALL PIPING PENETRATIONS THROUGH RATED PARTITIONS AND FLOORS.
2. UNDERGROUND SANITARY WASTE AND VENT PIPING SHALL BE SMOKE TESTED PRIOR TO INSTALLATION OF PLUMBING FIXTURES.
3. OFFSET PIPING WITHIN CEILING SPACE AS REQUIRED TO LOCATE PIPE RISERS AND DROPS WITHIN WALLS AS SHOWN ON PLANS.
4. PROVIDE ALL FLOOR DRAINS, FLOOR SINKS, AND TRENCH DRAINS WITH TRAP PRIMER PIPING FROM A SELF-CONTAINED TRAP PRIMER DISTRIBUTION UNIT WITH 1/2" ISOLATION VALVE. MAXIMUM OF FOUR FIXTURES PER TRAP PRIMER UNIT. UNIT TO BE MOUNTED PER MANUFACTURER'S RECOMMENDATIONS.
5. ALL HORIZONTAL PORTIONS OF THE SANITARY WASTE PIPING SERVING FOR CONDENSATE DISPOSAL SHALL BE INSULATED WITH 1" THICK SECTIONAL FIBERGLASS INSULATION WITH AN "ASJ" JACKET. INSULATION SHALL BE INSTALLED PER MANUFACTURER'S RECOMMENDATIONS. CONDENSATE DRAIN TRAP SHALL ALSO BE INSULATED.
6. PLUMBING DEVICES LOCATED IN WALLS, FLOORS, OR CEILINGS MUST BE FULLY SERVICE ACCESSIBLE. PRIOR TO INSTALLATION, PLUMBING CONTRACTOR SHALL COORDINATE LOCATION OF ACCESS PANELS WITH ARCHITECT AND OTHER CONTRACTORS WHOSE WORK MAY BE AFFECTED.
7. PLUMBING CONTRACTOR SHALL COORDINATE WITH THE MECHANICAL CONTRACTOR ALL VTRS AND ANY OTHER ROOF PENETRATIONS WITH ROOFTOP MECHANICAL EQUIPMENT AND OUTSIDE AIR INTAKES. A MINIMUM DISTANCE OF 12 FEET SHALL BE MAINTAINED BETWEEN ALL OUTSIDE AIR INTAKES AND VTRS PER 2021 IMC.
8. ALL PIPING PENETRATIONS OF FIRE-RATED BARRIERS SHALL BE SUFFICIENTLY PROTECTED TO MEET CURRENT CODE.
9. ALL FLOOR SINKS AND FLOOR TROUGHS SHALL BE SET NO HIGHER THAN FLUSH WITH FINISHED FLOOR.

**SANITARY WASTE KEYNOTES:**

- 1 PROVIDE DRAIN WITH TRAPGUARD (OR EQUAL) AS A TRAP PRIMER ALTERNATE.
- 2 CLEANOUT TO BE COMPLETELY SERVICE ACCESSIBLE.
- 3 DRAIN FOR CONDENSATE DISPOSAL FROM HVAC EQUIPMENT. COORDINATE FINAL LOCATION OF DRAIN WITH HVAC CONTRACTOR. PLUMBING CONTRACTOR SHALL PROVIDE A SUFFICIENTLY SIZED AIR GAP FITTING AT DRAIN TO ACCOMMODATE HVAC EQUIPMENT AND AUXILIARY PAN CONDENSATE DRAINS.

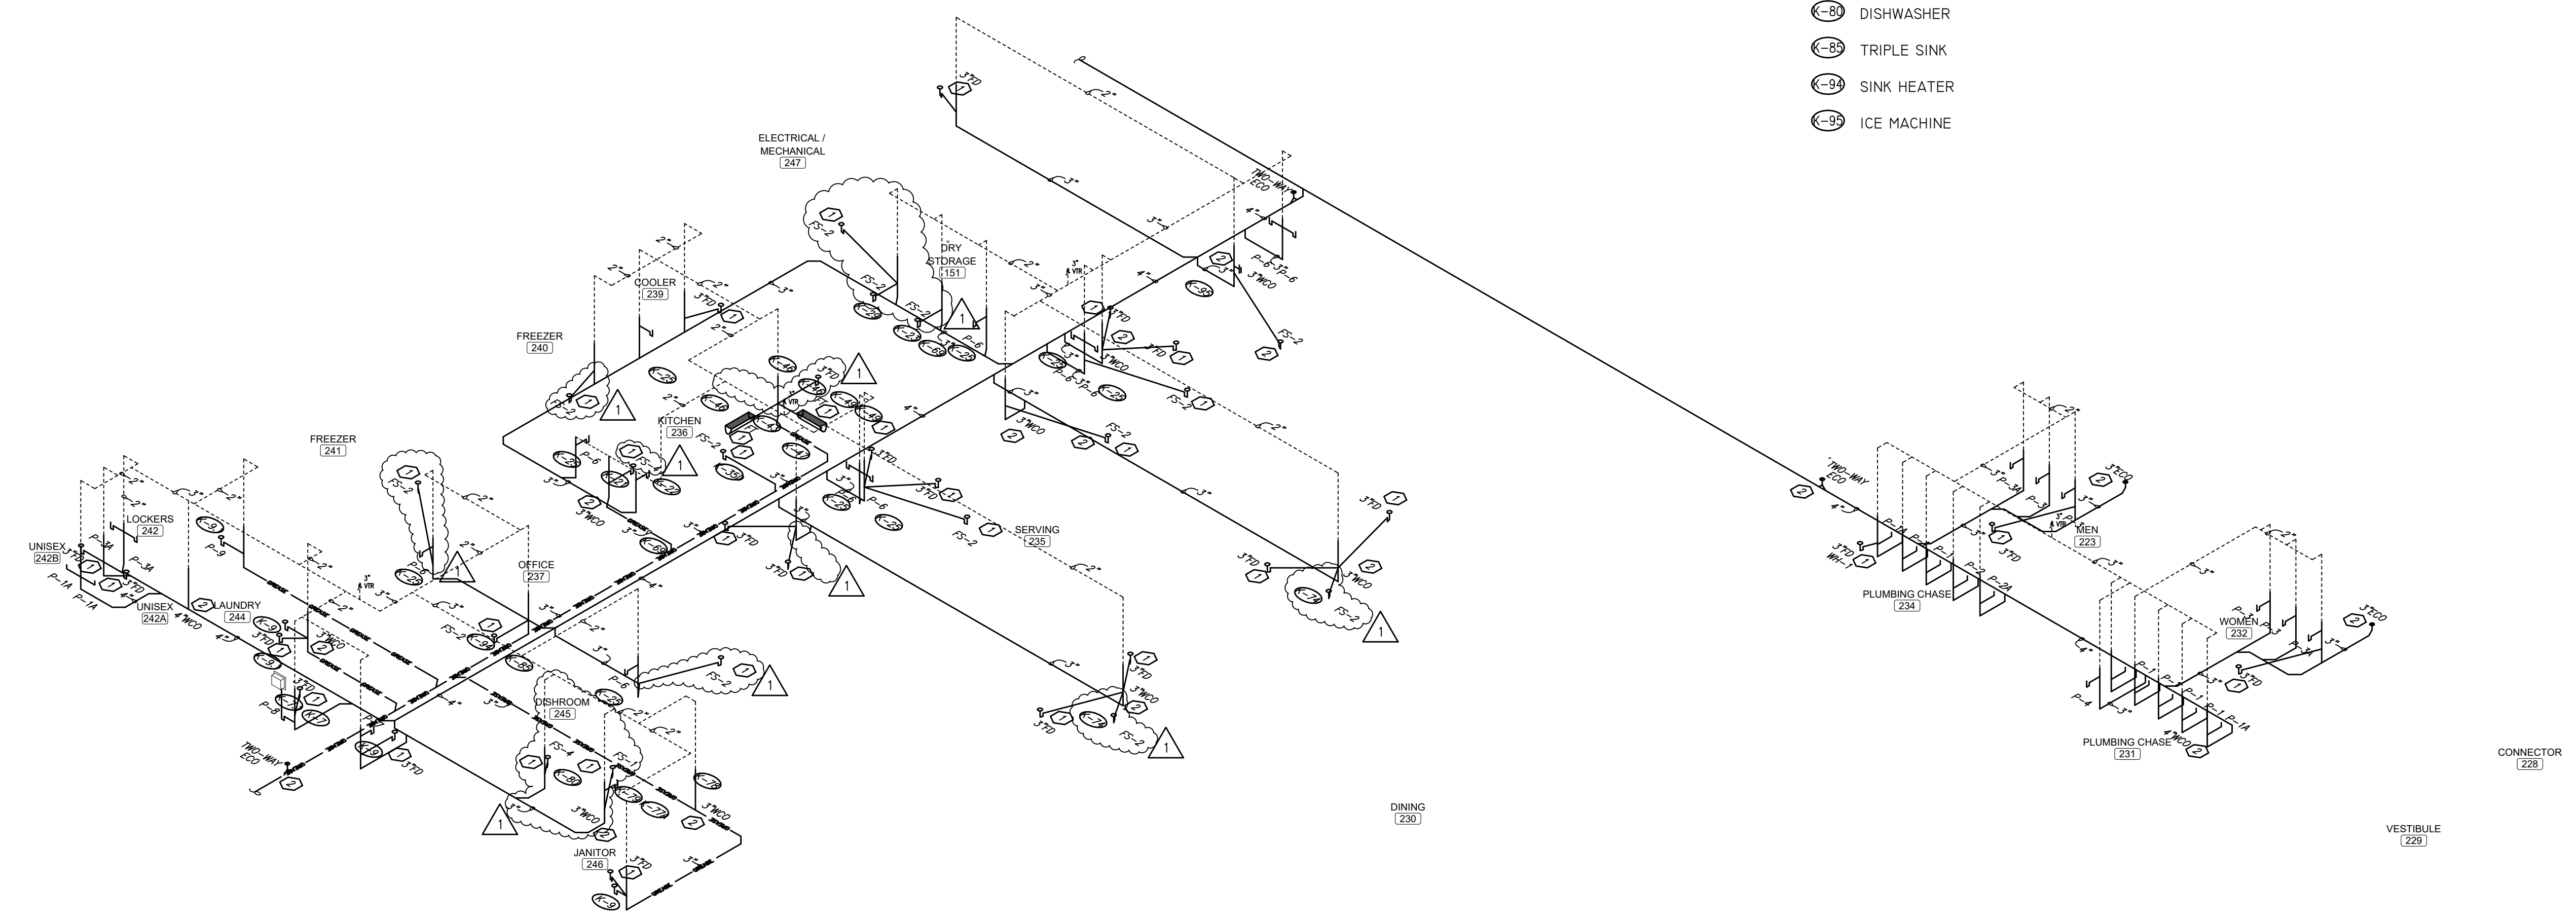

SHEET TITLE: **SANITARY WASTE RISER DIAGRAM -  
CAFETERIA-KITCHEN BUILDING**

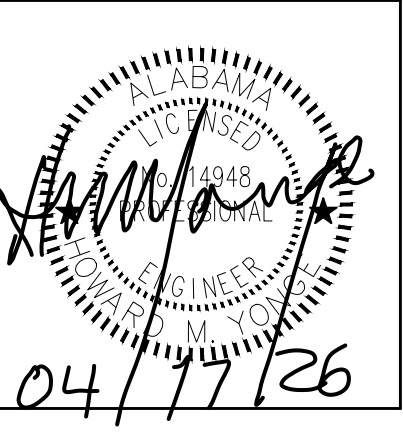

PROJ. MGR.:	H.M. YONGE
DRAWN:	D. B.
DATE:	03/25/26
REVISIONS	
#1	04/17/26 DCM COMMENTS

JOB NO. **25-160B**

SHEET NO:

**P3.1**

**H.M. YONGE & ASSOCIATES, INC.**  
CONSULTING ENGINEERS • EST. 1988  
51 EAST GREGORY STREET PENSACOLA, FLORIDA 32502 PHONE: (904)834-0061  
253 ST. ANTHONY STREET MOBILE, ALABAMA 36603 PHONE: (251)950-7466


**SANITARY WASTE RISER DIAGRAM -  
CAFETERIA-KITCHEN BUILDING**  
SCALE: NONE



**SITE IMPROVEMENTS AND  
INTERIOR ALTERATIONS TO  
FAIRHOPE HIGH SCHOOL**  
ONE PIRATE DRIVE  
FAIRHOPE, ALABAMA 36530  
BALDWIN COUNTY PUBLIC SCHOOLS

DOMESTIC WATER RISER  
DIAGRAMS -  
CAFETERIA-KITCHEN  
BUILDING

SHEET TITLE:

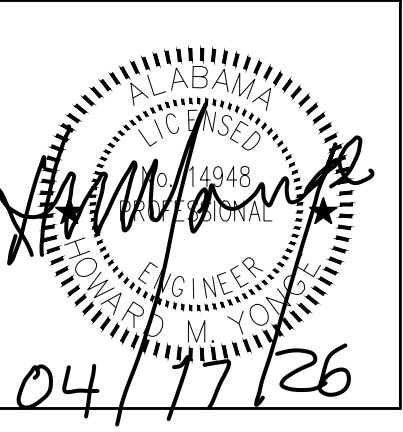


PROJ. MGR.:	H.M. YONGE
DRAWN:	D. B.
DATE:	03/25/26
REVISIONS	
#1	04/17/26 DCM COMMENTS

JOB NO. **25-160B**

SHEET NO:

**P3.2**

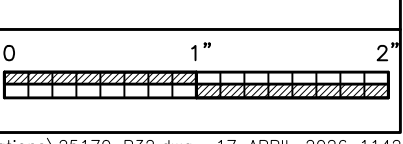

**KITCHEN EQUIPMENT LISTING**

- (C-1) CLOTHES WASHER
- (C-7) CLOTHES DRYER
- (C-3) MOP SINK
- (C-8) SERVICE FAUCETS
- (C-2) DOUBLE SINK
- (C-22) DISPOSAL
- (C-2) SINK
- (C-22) HAND SINK
- (C-25) HOT WATER DISPENSER
- (C-35) WORK TABLE WITH SINK
- (C-14) GAS BRAISING PAN
- (C-14) GAS CONVECTION DOUBLE OVEN
- (C-14) GAS COMBINATION DOUBLE OVEN
- (C-16) GAS STEAMER
- (C-65) HOSE REEL
- (C-74) ICE MACHINE
- (C-74) FAUCET
- (C-79) HOSE REEL
- (C-79) DISPOSAL
- (C-39) DISHWASHER
- (C-39) TRIPLE SINK
- (C-39) SINK HEATER
- (C-39) ICE MACHINE


**DOMESTIC WATER GENERAL NOTES:**

- CONTRACTOR SHALL REFER TO ARCHITECTURAL PLANS FOR LOCATIONS AND RATINGS OF FIRE-RATED WALLS AND SHALL PROVIDE UL-APPROVED SLEEVES FOR ALL PIPING PENETRATIONS THROUGH RATED PARTITIONS AND FLOORS.
- OFFSET PIPING WITHIN CEILING SPACE AS REQUIRED TO LOCATE PIPE RISERS AND DROPS WITHIN WALLS AS SHOWN ON PLANS.
- ALL FIXTURES MUST BE PROVIDED WITH STOPS. THOSE STOPS MUST BE FULLY ACCESSIBLE.
- SINKS LOCATED IN PUBLIC AREAS MUST BE INSTALLED IN ACCORDANCE WITH ADA REQUIREMENTS.
- PROVIDE ALL FLOOR DRAINS, FLOOR SINKS, AND TRENCH DRAINS WITH TRAP PRIMER PIPING FROM A SELF-CONTAINED TRAP PRIMER DISTRIBUTION UNIT WITH 1/2" ISOLATION VALVE. MAXIMUM OF FOUR FIXTURES PER TRAP PRIMER UNIT. UNIT TO BE MOUNTED PER MANUFACTURER'S RECOMMENDATIONS.
- PLUMBING DEVICES LOCATED IN WALLS, FLOORS, OR CEILINGS MUST BE FULLY SERVICE ACCESSIBLE. PRIOR TO INSTALLATION, PLUMBING CONTRACTOR SHALL COORDINATE LOCATION OF ACCESS PANELS WITH ARCHITECT AND OTHER CONTRACTORS WHOSE WORK MAY BE AFFECTED.
- PLUMBING CONTRACTOR SHALL COORDINATE WITH THE MECHANICAL CONTRACTOR ALL VTR'S AND ANY OTHER ROOF PENETRATIONS WITH ROOFTOP MECHANICAL EQUIPMENT AND OUTSIDE AIR INTAKES. A MINIMUM DISTANCE OF 12 FEET SHALL BE MAINTAINED BETWEEN ALL OUTSIDE AIR INTAKES AND VTR'S PER 2015 IMC.
- ALL PIPING PENETRATIONS OF FIRE-RATED BARRIERS SHALL BE SUFFICIENTLY PROTECTED TO MEET CURRENT CODE.


**DOMESTIC WATER KEYNOTES:**

- EXTEND TRAP PRIMER PIPING FROM FLOOR DRAIN UP INSIDE WALL FOR CONNECTION TO A SELF-CONTAINED TRAP PRIMER DISTRIBUTION UNIT.
- CONNECTIONS TO UTILITY DISTRIBUTION SYSTEM, UDS, CONNECTIONS SHALL INCLUDE FOR DOMESTIC COLD WATER, FOR DOMESTIC HOT WATER, AND FOR NATURAL GAS. REFER TO MANUFACTURER'S DATA FOR FURTHER INFORMATION.
- UNITS SHALL BE PROVIDED WITH BACKFLOW PROTECTION COMPLYING TO 2021 IPC 608.3.
- FOR SHUTOFF OF NATURAL GAS TO KITCHEN APPLIANCES BY AIR CONDITIONING REFRIGERANT MONITOR. REFERENCE HVAC PLANS.

ANY EXPOSED UTILITY LINES, PLUMBING LINES, AND DRAIN LINES BEHIND THE EQUIPMENT UNDER THE HOOD SHALL BE INSTALLED SUCH THAT THEY DO NOT OBSTRUCT EFFORTS TO CLEAN FLOORS, WALLS, OR THE HOOD. ANY HORIZONTAL LINES IN THIS AREA SHALL BE A MINIMUM OF 1'-6" ABOVE THE FINISHED FLOOR TO ELIMINATE THEIR CAUSING ANY OBSTRUCTION TO CLEANING EFFORTS.

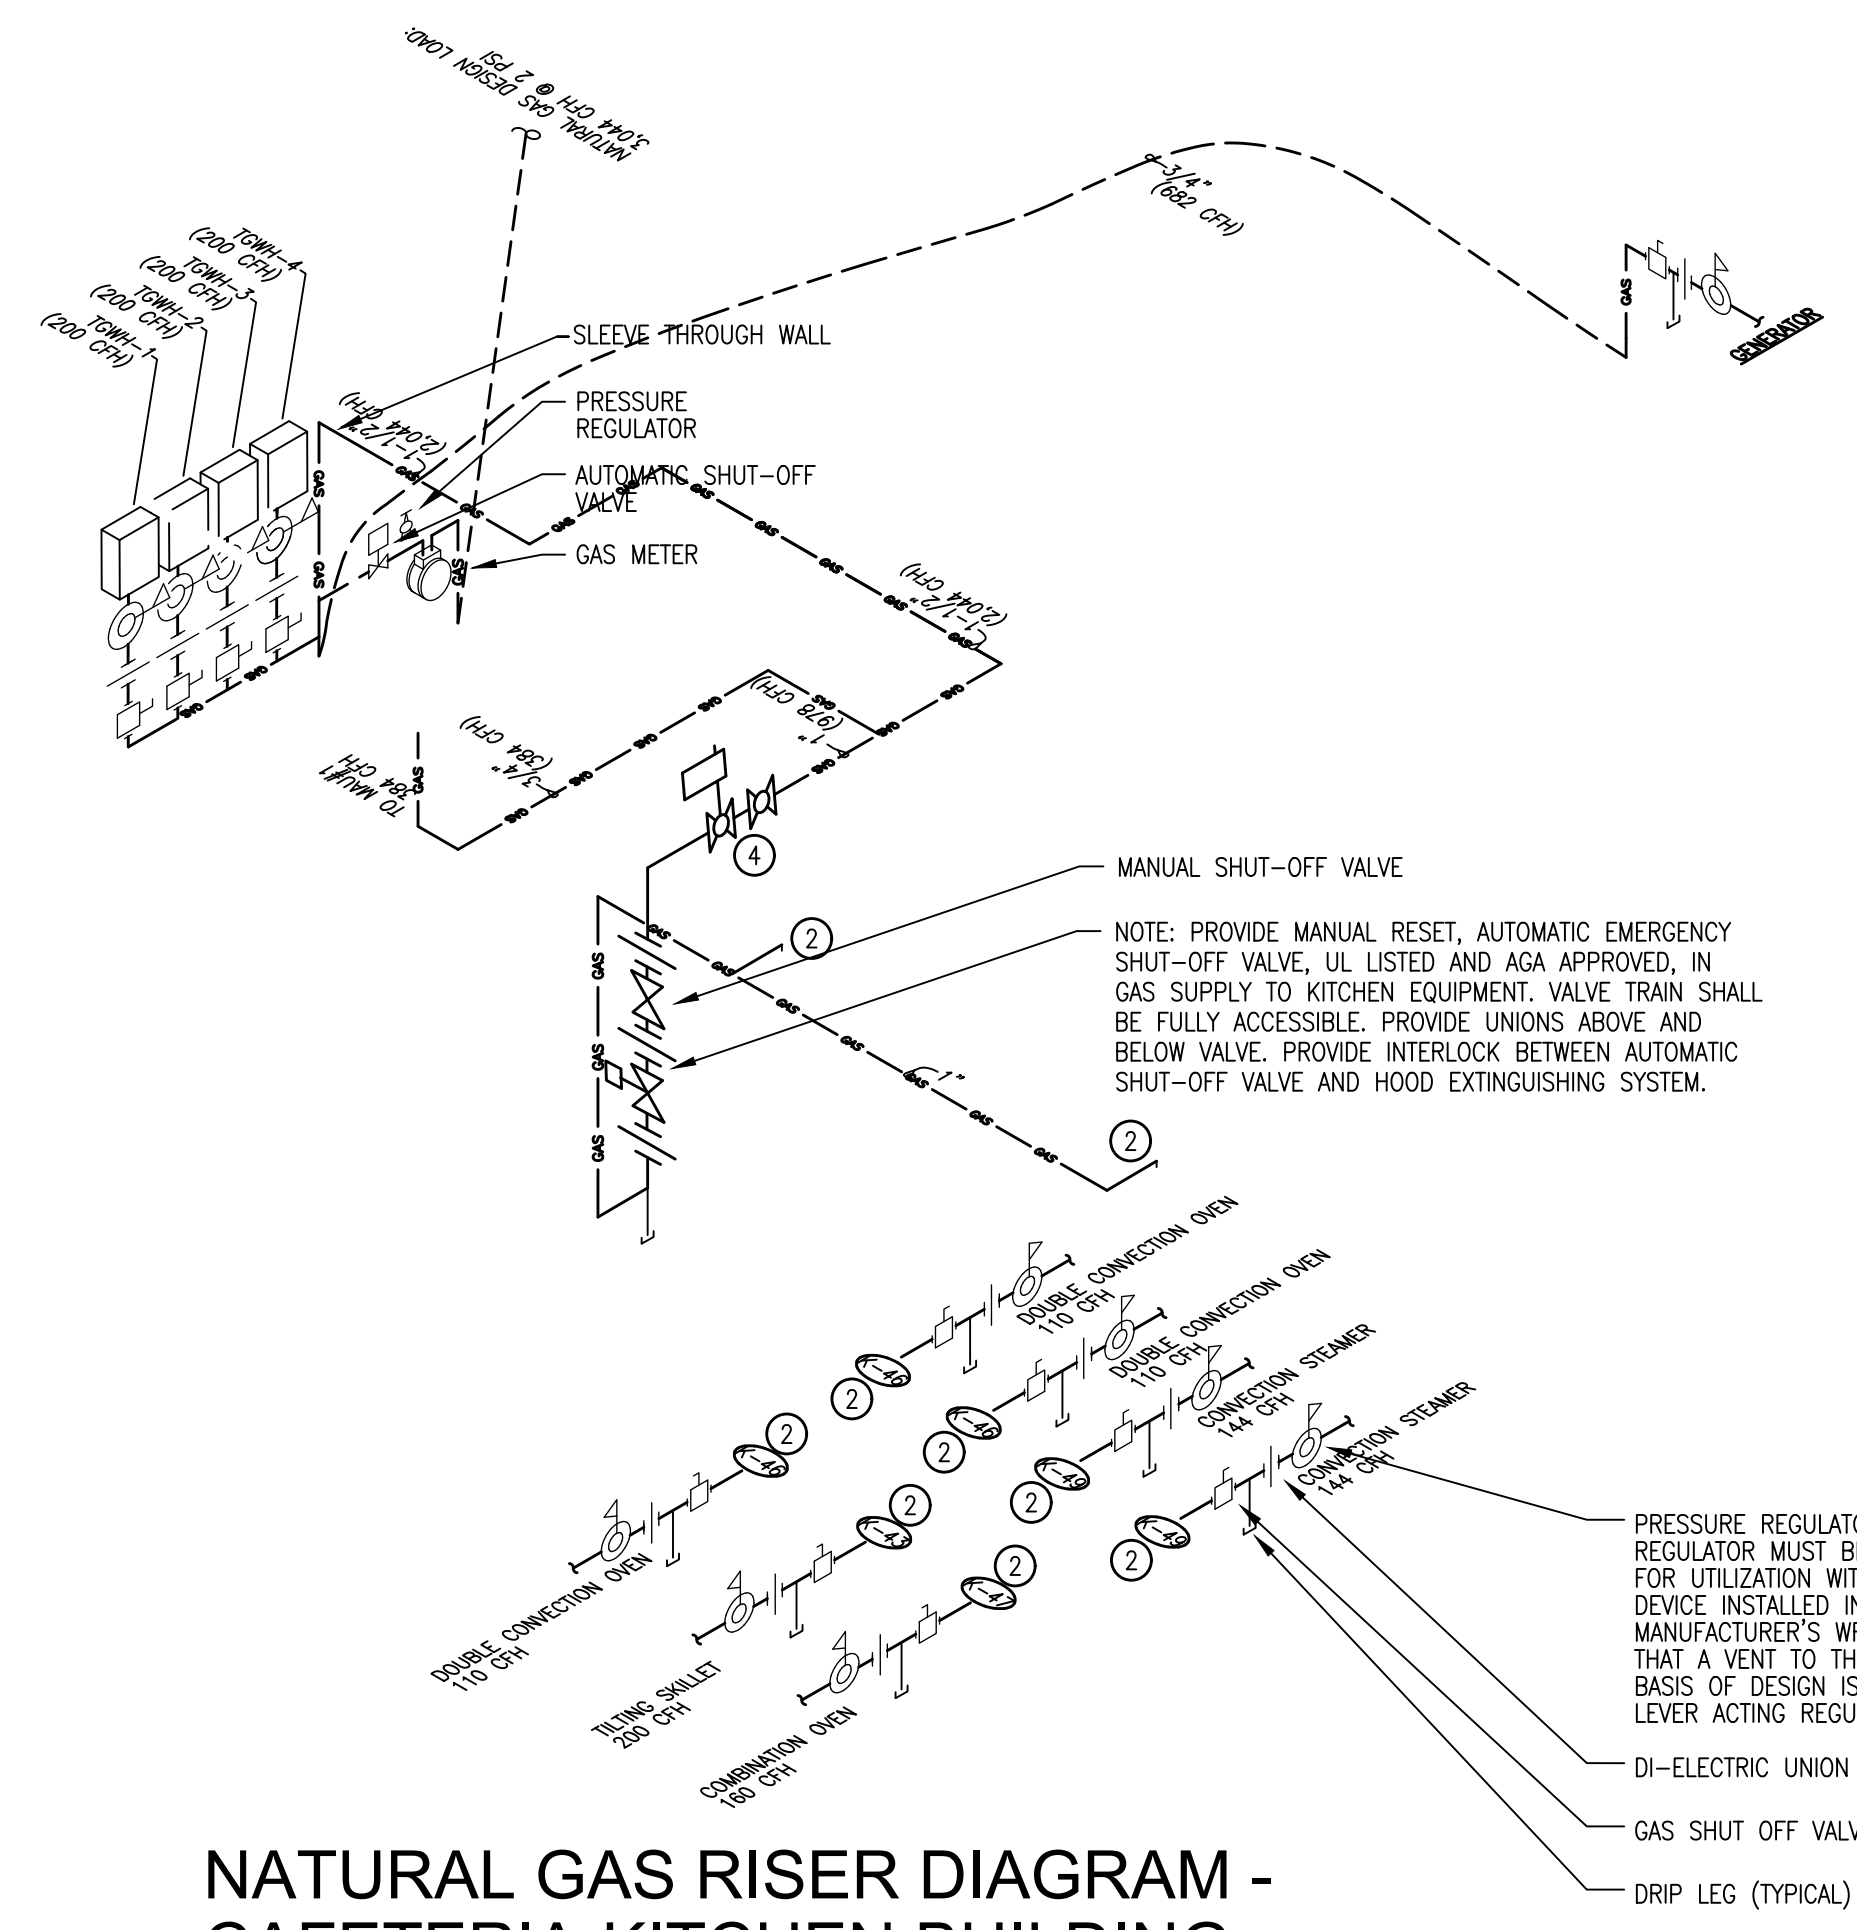

**NATURAL GAS RISER DIAGRAM -  
CAFETERIA-KITCHEN BUILDING**  
SCALE: NONE

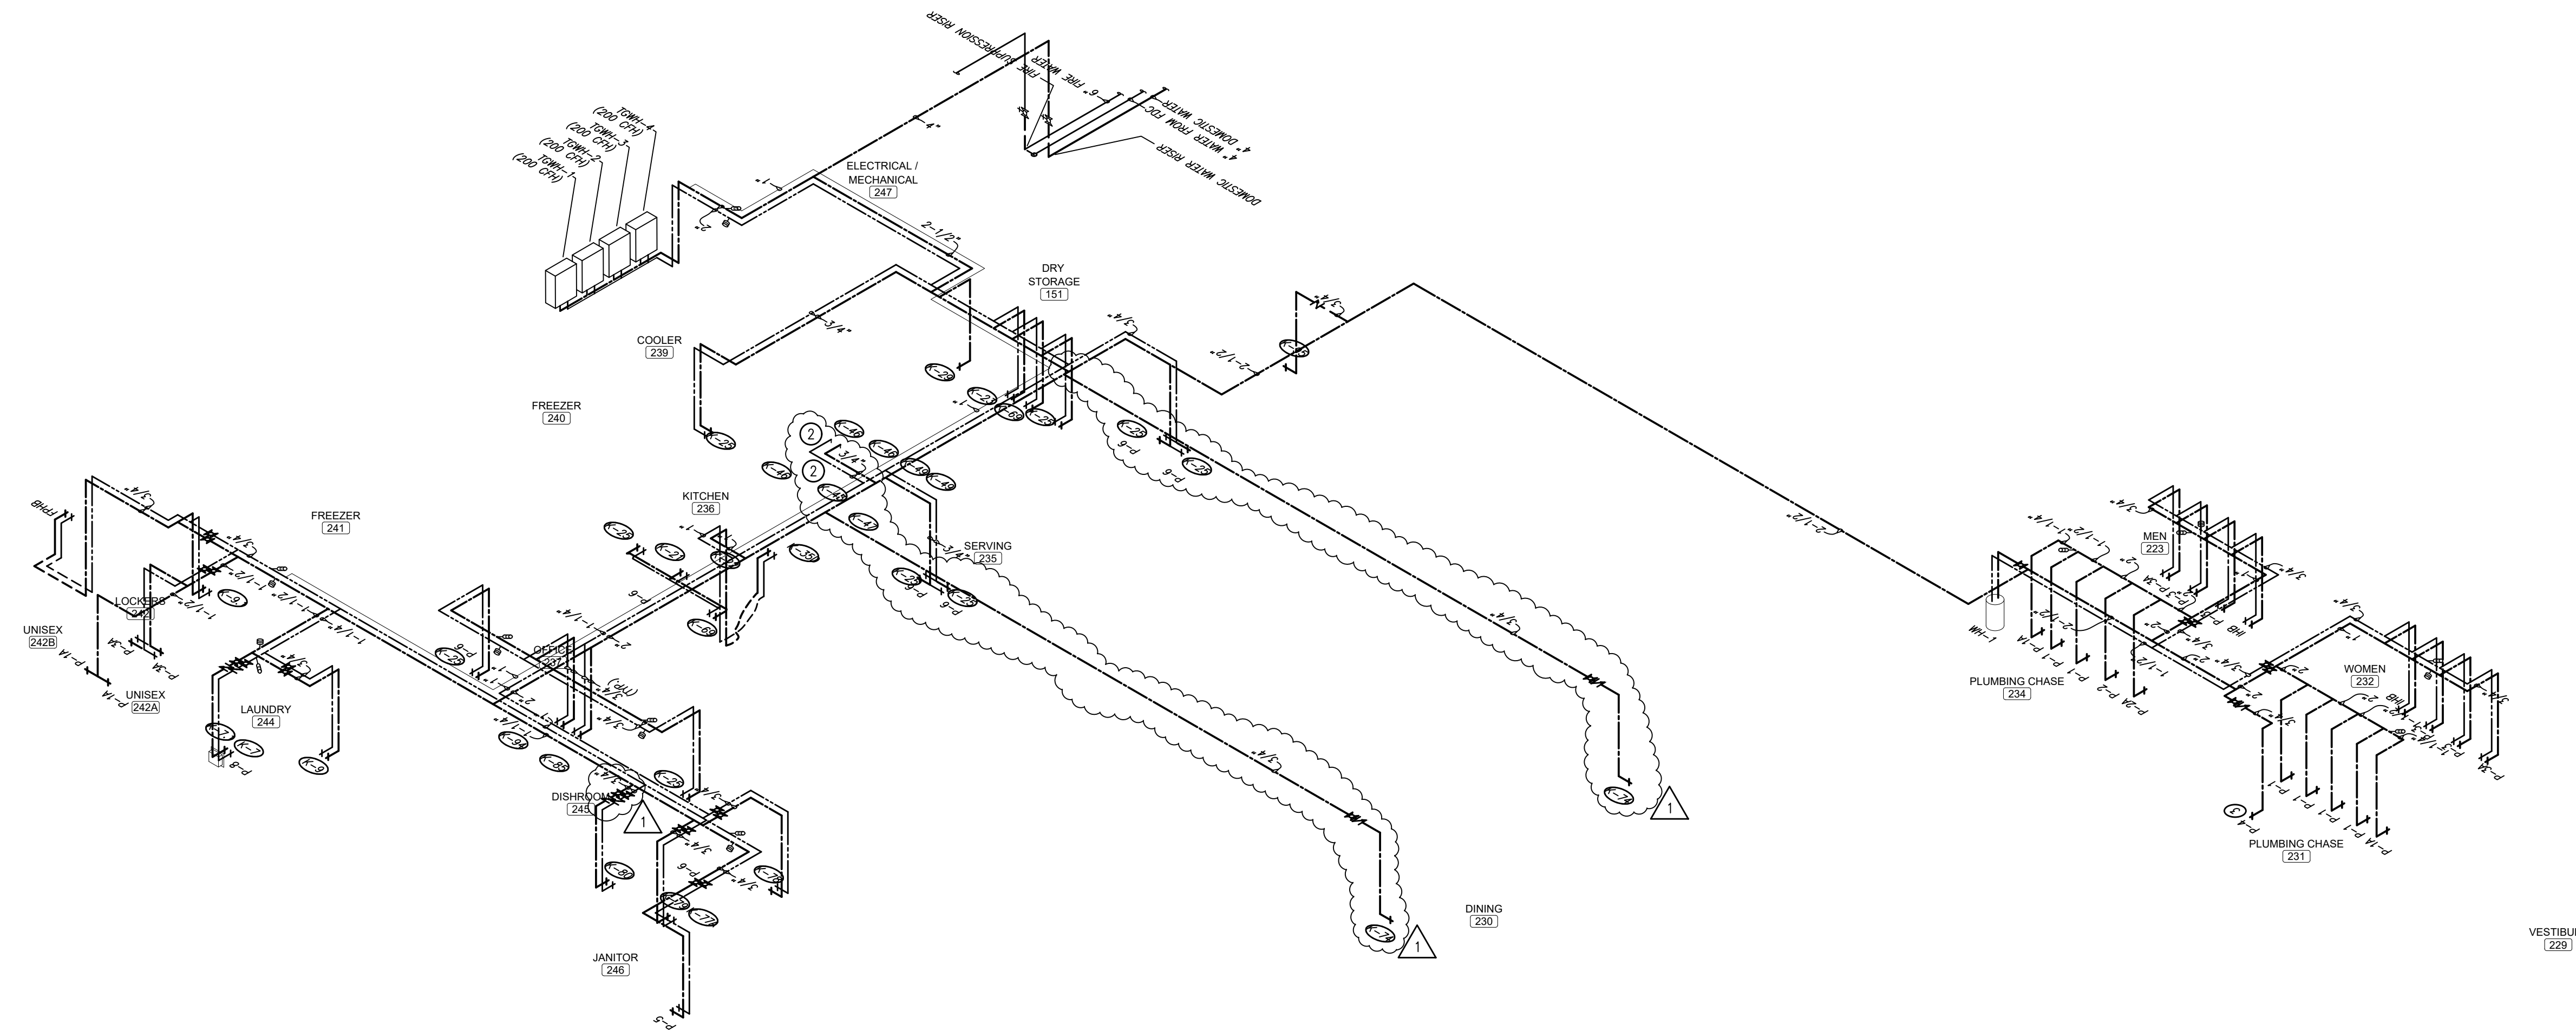

**DOMESTIC WATER RISER DIAGRAM -  
CAFETERIA-KITCHEN BUILDING**  
SCALE: NONE

**H.M. YONGE & ASSOCIATES, INC.**  
CONSULTING ENGINEERS • EST. 1988  
51 EAST GREGORY STREET PENSACOLA, FLORIDA 32502 PHONE: (904)384-3061  
253 ST. ANTHONY STREET MOBILE, ALABAMA 36603 PHONE: (205)950-7466


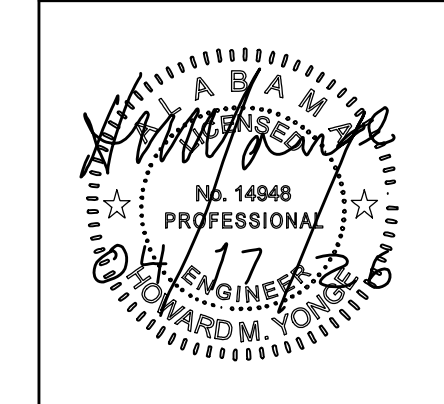


Table with project details: PROJ. MGR.: H.M. YONGE, DRAWN: A. HASKEW, DATE: 03/25/26, REVISIONS: #1 04/17/26 DCM COMMENTS

JOB NO. 25-160B

SHEET NO:

M1.1

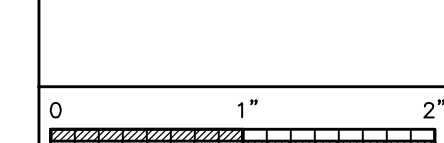

CONTROLS SCOPE OF WORK: CAFETERIA/KITCHEN

ENGINEERED COOLING SERVICES TO PROVIDE AND INSTALL A SIEMENS BACNET CONTROL SYSTEM AND EXTENSION TO EXISTING TRIDIUM N4 GRAPHICAL WORKSTATION FOR FAIRHOPE HIGH SCHOOL MEDIA CENTER AND CAFETERIA / KITCHEN IMPROVEMENTS

CAFETERIA / KITCHEN

- BACNET INTEGRATION TO TWO (2) PACKAGED DX ROOFTOP AIR HANDLING UNITS (RTU-1,2)
BACNET INTEGRATION TO UNITS; RTU VENDOR TO FACTORY PROVIDE ON-BOARD CONTROLLER WITH ALL REQUIRED CONTROL DEVICES AND BACNET CARD PER M3.0
ECS TO FIELD INSTALL RTU VENDOR PROVIDED ZONE SENSOR

BACNET INTEGRATION TO TWO (2) PACKAGED HEAT PUMP UNITS (RTU-3,4)

- BACNET INTEGRATION TO UNITS; UNIT VENDOR TO FACTORY PROVIDE ON-BOARD CONTROLLER WITH ALL REQUIRED CONTROL DEVICES AND BACNET CARD PER M3.0
ECS TO FIELD INSTALL THE RTU VENDOR PROVIDED ZONE SENSOR

EXHAUST FAN INTERLOCK

- EXHAUST FAN START/STOP AND STATUS (DEF#1)
EXTENSION OF EXISTING TRIDIUM N4 GRAPHICAL WORKSTATION:
ETHERNET SWITCH
MAP IN NEW BACNET DEVICES TO EXISTING TRIDIUM SUPERVISOR
PROVIDE REQUIRED DEVICE LICENSES FOR NEWLY INTEGRATED EQUIPMENT
UPDATE FLOOR PLAN GRAPHICS AND INDIVIDUAL SYSTEM GRAPHICS FOR ATUS, RTUS, EFS, ETC.
SET-UP REQUIRED SCHEDULES, ALARMS, TRENDS, REMOTE NOTIFICATION

TEST AND BALANCE SUPPORT


- AS-BUILT CONTROL DRAWINGS
ONE-YEAR WARRANTY ON NEW MATERIAL

EXCLUSIONS AND CLARIFICATIONS:

- DEMOLITION BY OTHERS
ECS TO CAREFULLY REMOVE PROPRIETARY TECS AND RETURN TO GCBE FOR SERVICE STOCK
IP DROP AT DDC CONTROLLER LOCATION BY GCBE
ALL EXISTING TO REMAIN HVAC MECHANICAL EQUIPMENT AND CONTROLS ARE ASSUMED OPERATIONAL
BI-POLAR IONIZATION DEVICE PROVIDED AND INSTALLED BY MECHANICAL CONTRACTOR
NO WORK ASSOCIATED WITH KITCHEN HOOD / MAKEUP AIR UNIT
NO WORK ASSOCIATED WITH BUILDING FIRE ALARM SIGNAL, SMOKE DETECTORS AND WIRING
ALL REQUIRED SMOKE, FIRE/SMOKE DAMPERS, ACTUATORS AND WIRING BY OTHERS
TEST & BALANCE BY OTHERS
NO PATCHING OR PAINTING INCLUDED
ALL REQUIRED MOTOR STARTERS AND DISCONNECTS BY OTHERS
H-O-A'S FOR HVAC EQUIPMENT BY OTHERS
ALL WELLS, PRESSURE TAPS, P/T'S, TEMPERATURE AND PRESSURE GAUGES BY MECHANICAL
FLOW CONTROL-BALANCING VALVES AND MANUAL VALVES BY MECHANICAL



HVAC NEW WORK KEY NOTES:


- 1 ROOF MOUNTED PACKAGED AIR CONDITIONING UNIT WITH FULL PERIMETER CURB. CURB SHALL BE AS PROVIDED BY EQUIPMENT MANUFACTURER. SECURE UNIT TO CURB AND CURB TO ROOF STRUCTURE WITH 3/16 INCH MECHANICAL FASTENERS SPACED 24 INCHES ON CENTER PER ITEM. EXTEND FROM UNIT FULL SIZE OF OPENING A CONDENSATE DRAIN LINE OVER TO NEAREST ROOF DRAIN. ROUTE DRAIN LINE ACROSS ROOF SUPPORTED EVERY 48 INCHES WITH A HIGH DENSITY POLYETHYLENE PIPE SUPPORT CURB. SECURE CURB TO ROOF STRUCTURE WITH MASTIC AS RECOMMENDED BY ROOFING CONTRACTOR. SECURE DRAIN LINE TO CURB WITH UNISTRUT TYPE CLAMP SYSTEM. OUTDOOR AIR INTAKE ASSEMBLY SHALL INCLUDE A MOTORIZED DAMPER AND A MANUAL VOLUME DAMPER. BALANCE MANUAL VOLUME DAMPER TO INDICATED AIR FLOW. INTERLOCK MOTORIZED DAMPER WITH TEMPERATURE CONTROLLER SUCH THAT DAMPER SHALL BE OPEN DURING OCCUPIED HOURS AND CLOSED OTHERWISE.
2 SUPPLY AND RETURN AIR DUCTWORK SHALL BE EXTENDED UP FROM FULL SIZE OF UNIT OPENING WITH TRANSITION TO INDICATED DUCT SIZE. ROUTE DUCT OVER TO EXTERIOR WALL TO TURN UP ON WALL TO PENETRATE EXTERIOR WALL ABOVE CAFETERIA CEILING ELEVATION. ADJUST FINAL POSITION TO ACCOMMODATE FIELD CONDITIONS. ROUTE DUCT GENERALLY AS INDICATED WITH OFFSETS TO AVOID OBSTRUCTIONS. EXTEND BRANCH DUCT FOR CONNECTION TO DESIGNATED AIR DEVICES. INCLUDE A MANUAL VOLUME DAMPER IN EACH BRANCH DUCT AND BALANCE TO INDICATED AIR FLOW. COORDINATE FINAL ELEVATIONS WITH ADJACENT DUCT SYSTEMS.
3 ROOF MOUNTED PACKAGED HEAT PUMP UNIT WITH FULL PERIMETER CURB. CURB SHALL BE AS PROVIDED BY EQUIPMENT MANUFACTURER. SECURE UNIT TO CURB AND CURB TO ROOF STRUCTURE WITH 3/16 INCH MECHANICAL FASTENERS SPACED 24 INCHES ON CENTER PER ITEM. EXTEND FROM UNIT FULL SIZE OF OPENING A CONDENSATE DRAIN LINE OVER TO NEAREST ROOF DRAIN. ROUTE DRAIN LINE ACROSS ROOF SUPPORTED EVERY 48 INCHES WITH A HIGH DENSITY POLYETHYLENE PIPE SUPPORT CURB. SECURE CURB TO ROOF STRUCTURE WITH MASTIC AS RECOMMENDED BY ROOFING CONTRACTOR. SECURE DRAIN LINE TO CURB WITH UNISTRUT TYPE CLAMP SYSTEM. OUTDOOR AIR INTAKE ASSEMBLY SHALL INCLUDE A MOTORIZED DAMPER AND A MANUAL VOLUME DAMPER. BALANCE MANUAL VOLUME DAMPER TO INDICATED AIR FLOW. INTERLOCK MOTORIZED DAMPER WITH TEMPERATURE CONTROLLER SUCH THAT DAMPER SHALL BE OPEN DURING OCCUPIED HOURS AND CLOSED OTHERWISE.
4 SUPPLY AND RETURN AIR DUCTWORK SHALL BE EXTENDED DOWN FROM FULL SIZE OF UNIT OPENING WITH TRANSITION TO INDICATED DUCT SIZE TO UNDERSIDE OF ROOF SUPPORT STRUCTURE ABOVE CEILING ELEVATION. ADJUST FINAL POSITION TO ACCOMMODATE FIELD CONDITIONS. ROUTE DUCT GENERALLY AS INDICATED WITH OFFSETS TO AVOID OBSTRUCTIONS. EXTEND BRANCH DUCT FOR CONNECTION TO DESIGNATED AIR DEVICES. INCLUDE A MANUAL VOLUME DAMPER IN EACH BRANCH DUCT AND BALANCE TO INDICATED AIR FLOW. COORDINATE FINAL ELEVATIONS WITH ADJACENT DUCT SYSTEMS.
5 WALL MOUNTED ZONE SENSOR PROVIDED BY UNIT MANUFACTURER, INSTALLED BY CONTROLS CONTRACTOR.
6 AIR PURIFICATION DEVICE (BI-POLAR TYPE) TO BE INSTALLED IN SUPPLY AIR DUCT OR ON AIR HANDLING UNIT PER MANUFACTURER'S INSTRUCTIONS. INTERLOCK DEVICE WITH AIR HANDLING UNIT SUCH THAT AS UNIT IS OPERATING THE DEVICE SHALL BE OPERATING. OTHERWISE, BOTH SHALL NOT BE OPERATING.
7 SMOKE DETECTOR MOUNTED IN SUPPLY AND RETURN AIR DUCTWORK. SMOKE DETECTOR IN RETURN AIR DUCT SHALL BE UP STREAM OF OUTDOOR AIR INTAKE. AS EITHER DETECTOR IS ACTIVATED, THE AIR HANDLING UNIT SHALL AUTOMATICALLY SHUT DOWN AND A SIGNAL SENT TO THE FIRE ALARM PANEL.
8 CEILING MOUNTED EXHAUST FAN WITH DISCHARGE DUCT ROUTED FOR CONNECTION TO EXHAUST AIR MANIFOLD. EXHAUST AIR MANIFOLD SHALL BE EXTENDED FOR TERMINATION ON EXTERIOR WALL WITH DISCHARGE AIR LOUVER. CONTROL OF EXHAUST FAN SHALL BE AS SCHEDULED.
9 WALL MOUNTED EXHAUST AIR LOUVER TO BE WEATHERPROOF AND HURRICANE RATED PER MIAMI-DADE STANDARDS. ADJUST FINAL LOCATION OF LOUVER TO ACCOMMODATE ARCHITECTURAL PLANS. EXHAUST AIR MANIFOLD TO BE EXTENDED TO EXTERIOR WALL FOR CONNECTION TO EXHAUST AIR PLENUM. PLENUM SHALL BE FULL SIZE OF LOUVER. ADJUST FINAL LENGTH OF PLENUM TO ACCOMMODATE DUCT CONNECTIONS. PLENUM AND EXHAUST DUCT SHALL BE INSULATED.
10 FLY FAN TO BE INSTALLED OVER FULL LENGTH OF DOOR. FAN CONTROL SHALL BE FROM DOOR SWITCH SUCH THAT AS DOOR IS OPEN FAN SHALL BE OPERATING AND OTHERWISE FAN SHALL NOT BE OPERATING.
11 TRANSFER AIR DUCT WITH TRANSFER GRILLES AT EACH END AND ONE TRANSFER GRILLE AT CENTER.
12 CLOTHES DRYER UNIT EXHAUST VENT TO BE EXTENDED FROM FULL SIZE OF DRYER VENT OPENING (VERIFY AS 4 INCHES). EXTEND EXHAUST VENT ADJACENT TO WALL TO TERMINATE ON WALL WITH FULL SIZE VENT CAP HAVING A BACK DRAFT DAMPER/FLAPPER.
13 ROOF MOUNTED DISHWASHER HOOD EXHAUST FAN. EXHAUST DUCT SHALL BE ROUTED TO ABOVE CEILING AND OVER TO PENETRATE ROOF TO CONNECT DUCT TO DEF#1. EXHAUST FAN SHALL BE MOUNTED ON FULL PERIMETER CURB. CONTROL OF FAN SHALL BE THROUGH THE BUILDING AUTOMATION SYSTEM SUCH THAT THE FAN SHALL OPERATE CONTINUOUSLY DURING OCCUPIED HOURS AND OTHERWISE NOT BE OPERATING.
14 MECHANICAL CONTRACTOR TO COORDINATE INSTALLATION AND OPERATIONAL REQUIREMENTS WITH KITCHEN COOKING HOOD MANUFACTURER. ADJUST EXHAUST AND MAKE-UP AIR FLOWS ACCORDINGLY. EXTEND EXHAUST DUCTS UP FROM HOOD FOR CONNECTION TO EXHAUST AIR MANIFOLD. ADJUST DUCT SIZING TO MAINTAIN 1500 FPM VELOCITY. TURN EXHAUST DUCT UP AND ROUTE OVER FOR CONNECTION TO ROOF MOUNTED EXHAUST FAN. INSTALL EXHAUST HOOD AND EXHAUST FAN PER REQUIREMENTS OF NFPA AND DETAIL.
15 MAKE-UP AIR UNIT FOR KITCHEN HOOD PLENUMS SHALL BE PRECONDITIONED 100% OUTDOOR AIR. UNIT SHALL BE PACKAGED AND ROOF MOUNTED WITH FULL PERIMETER CURB AS PROVIDED BY UNIT MANUFACTURER. ROOF CURB SHALL BE A MINIMUM OF 18 INCHES TALL TO ALLOW SUPPLY AIR DUCTWORK TO TRANSFER BEFORE PENETRATING ROOF. MECHANICAL CONTRACTOR TO COORDINATE WITH GENERAL CONTRACTOR TO ENSURE TOP ELEVATION OF UNIT IS NOT MORE THAN 46 INCHES ABOVE ROOF DECK. ADJUST CURB HEIGHT ACCOMMODATE FINAL ELEVATION. MAKE-UP AIR INTAKE HOOD SHALL BE 10' (MINIMUM) FROM ANY EXHAUST DISCHARGE.
16 MAKE-UP AIR DUCT SHALL BE ROUTED DOWN THROUGH ROOF JOISTS TO ABOVE CEILING WITH BRANCH DUCT CONNECTIONS BEING EXTENDED FOR CONNECTION TO DESIGNATED LOCATIONS ON KITCHEN HOOD PLENUM. INCLUDE A MANUAL VOLUME DAMPER IN EACH BRANCH DUCT AND BALANCE TO DESIGNATED AIR FLOW.
17 ROOF MOUNTED KITCHEN HOOD EXHAUST FAN MOUNTED ON ROOF CURB. ADJUST HEIGHT OF ROOF CURB SUCH THAT POINT OF DISCHARGE FROM FAN IS MINIMUM OF 42 INCHES ABOVE ROOF DECK. INSTALLATION OF FAN SHALL BE HINGED FOR MAINTENANCE ACCESS.
18 ROOF MOUNTED EQUIPMENT SHALL BE SECURED TO ROOF CURB AND ROOF CURB SECURED TO ROOF STRUCTURE WITH A MINIMUM OF ONE MECHANICAL FASTENER PER SIDE AND AS SPACE IS AVAILABLE EVERY 24 INCHES. MECHANICAL FASTENER SHALL BE 3/16" IN DIAMETER.
19 SMOKE DAMPER INSTALLED IN DUCTWORK IN WALL PENETRATION. INTERLOCK WITH SMOKE DETECTOR LOCATED IN LAUNDRY ROOM.
20 KITCHEN HOOD PULL STATION.
21 FIRE DAMPER INSTALLED IN DUCTWORK IN WALL PENETRATION. INCLUDE 12X12 ACCESS PANEL OR REMOVAL DUCT TO ALLOW ACCESS TO FIRE DAMPER.

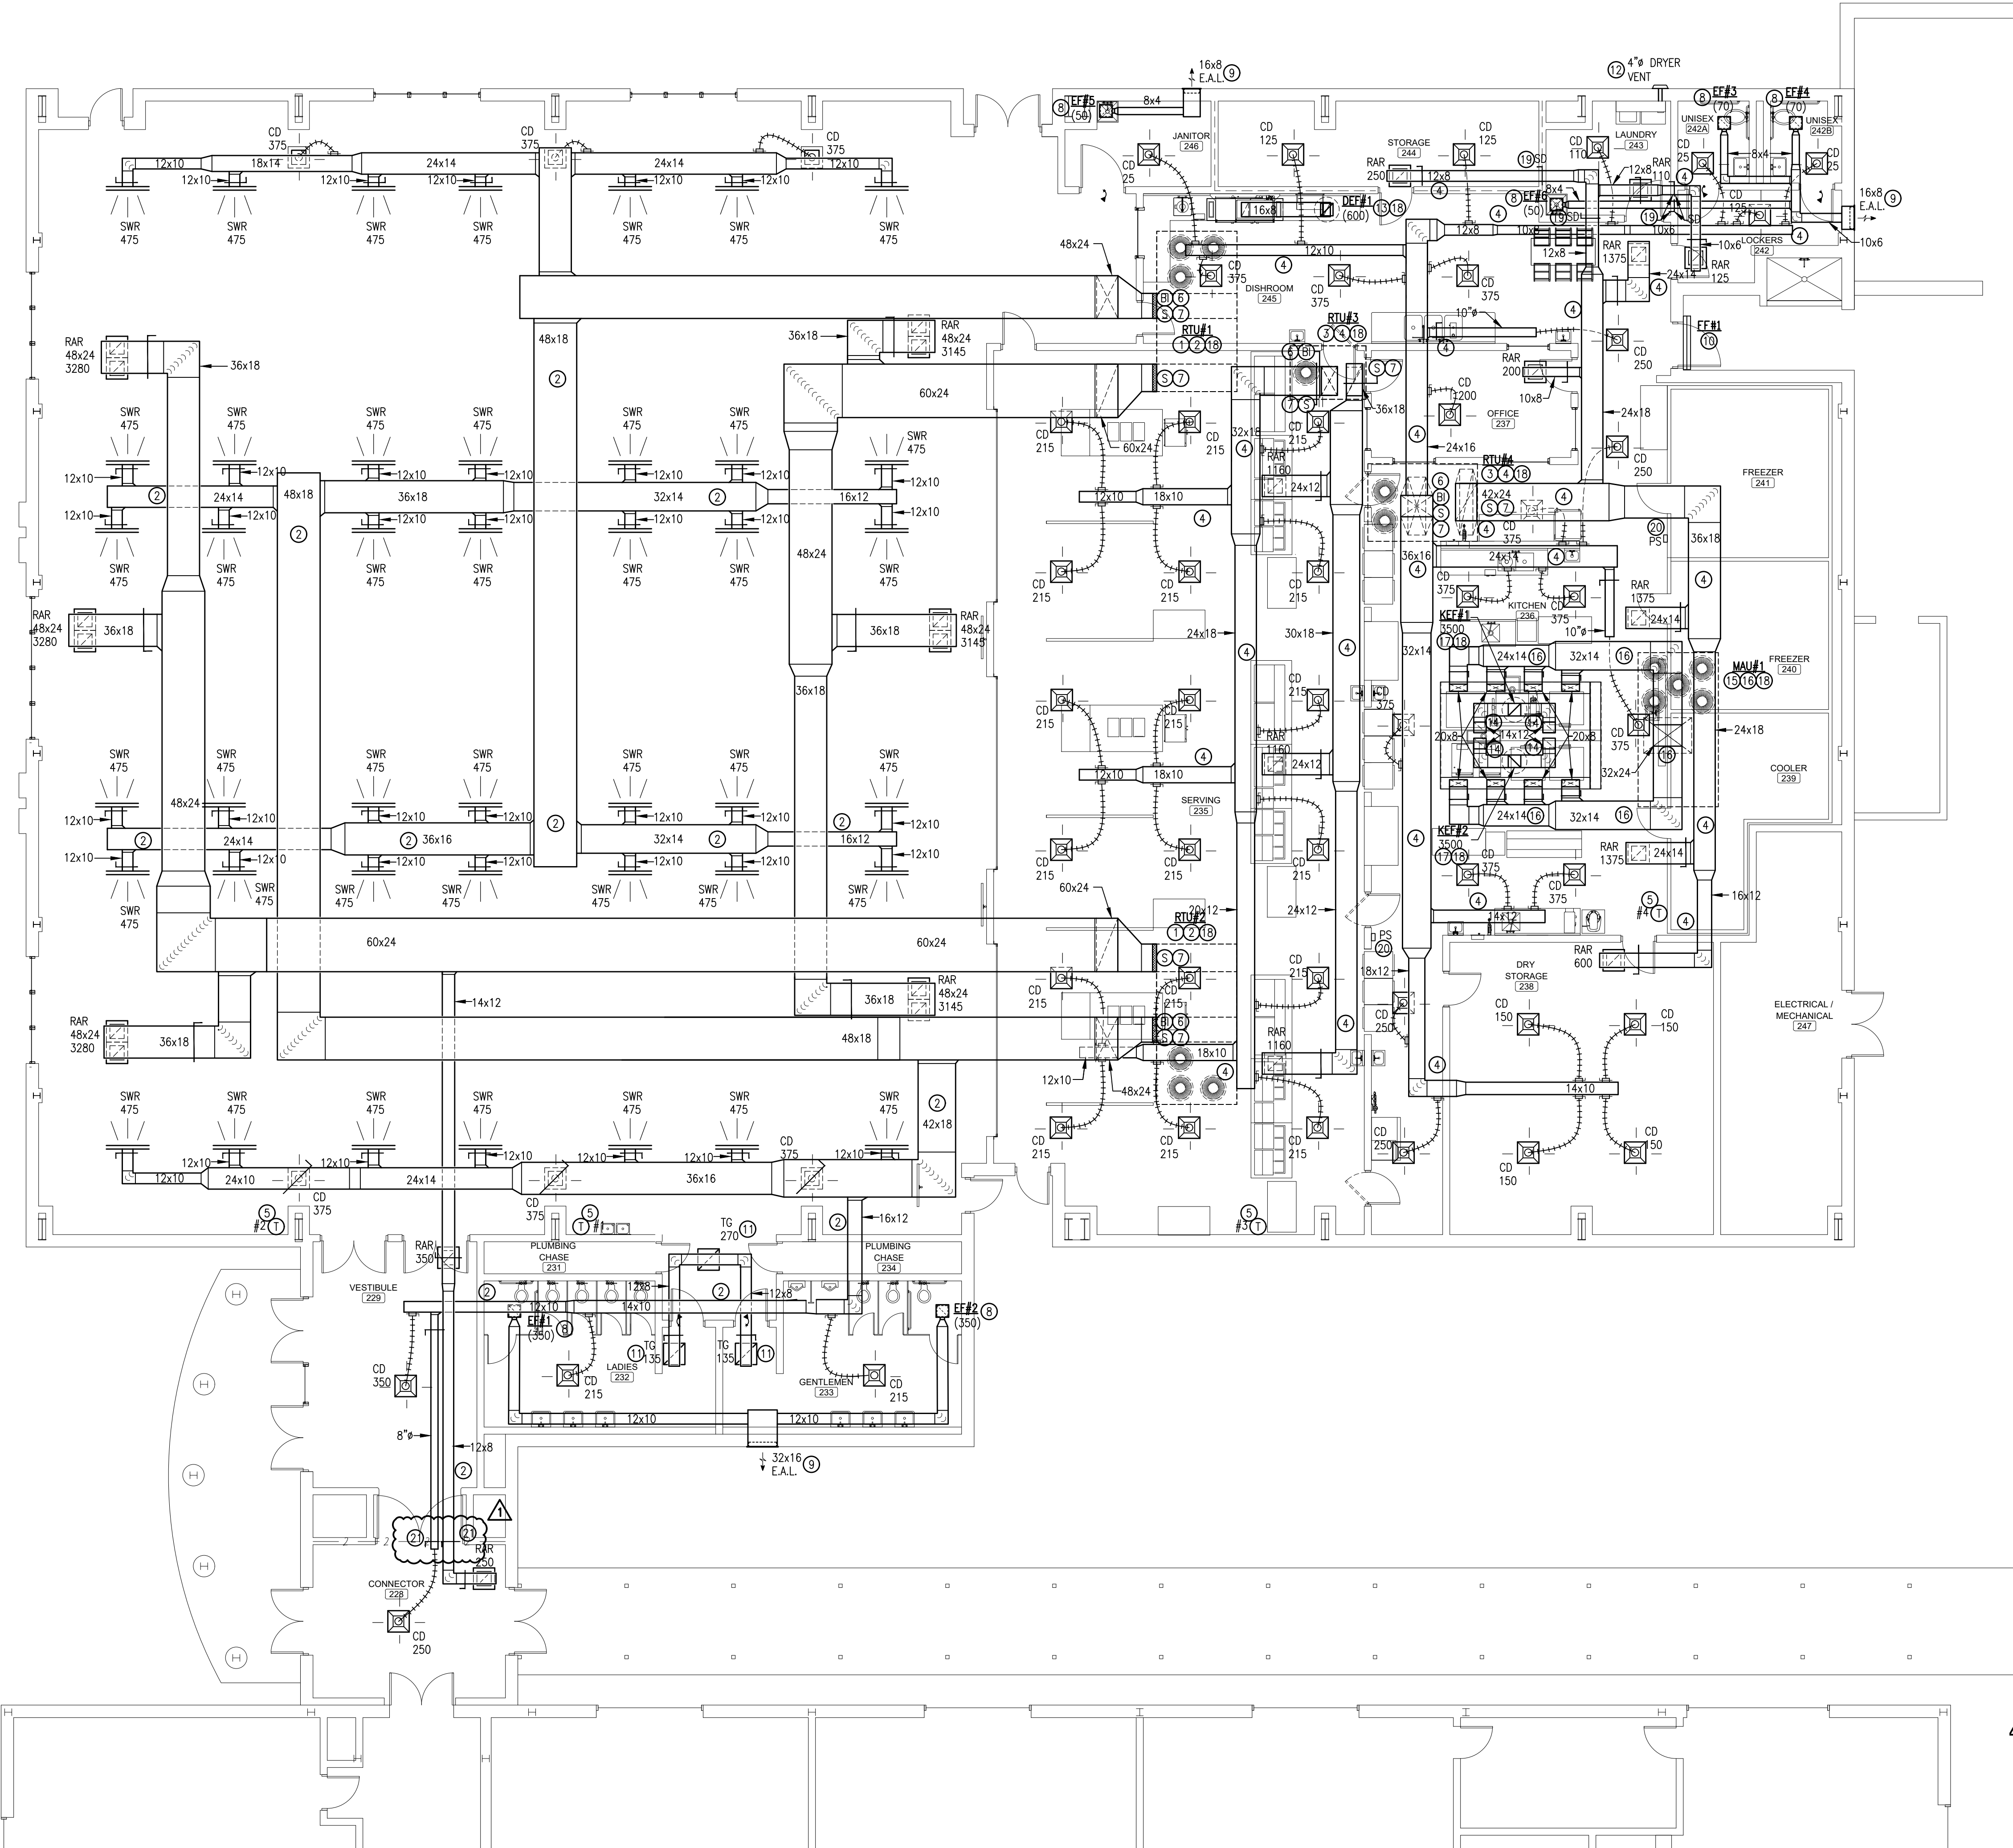


HVAC NEW WORK PLAN - CAFETERIA-KITCHEN BUILDING

SCALE: 1/8" = 1'-0"

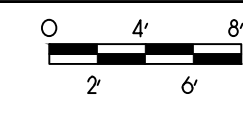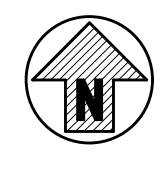


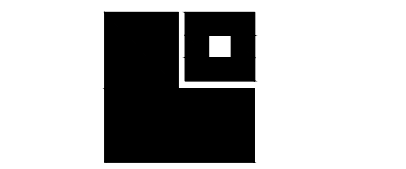


PROJ. MGR.:	H.M. YONGE
DRAWN:	A. HASKWE
DATE:	03/25/26
REVISIONS	
#1	04/17/26 DCM COMMENTS

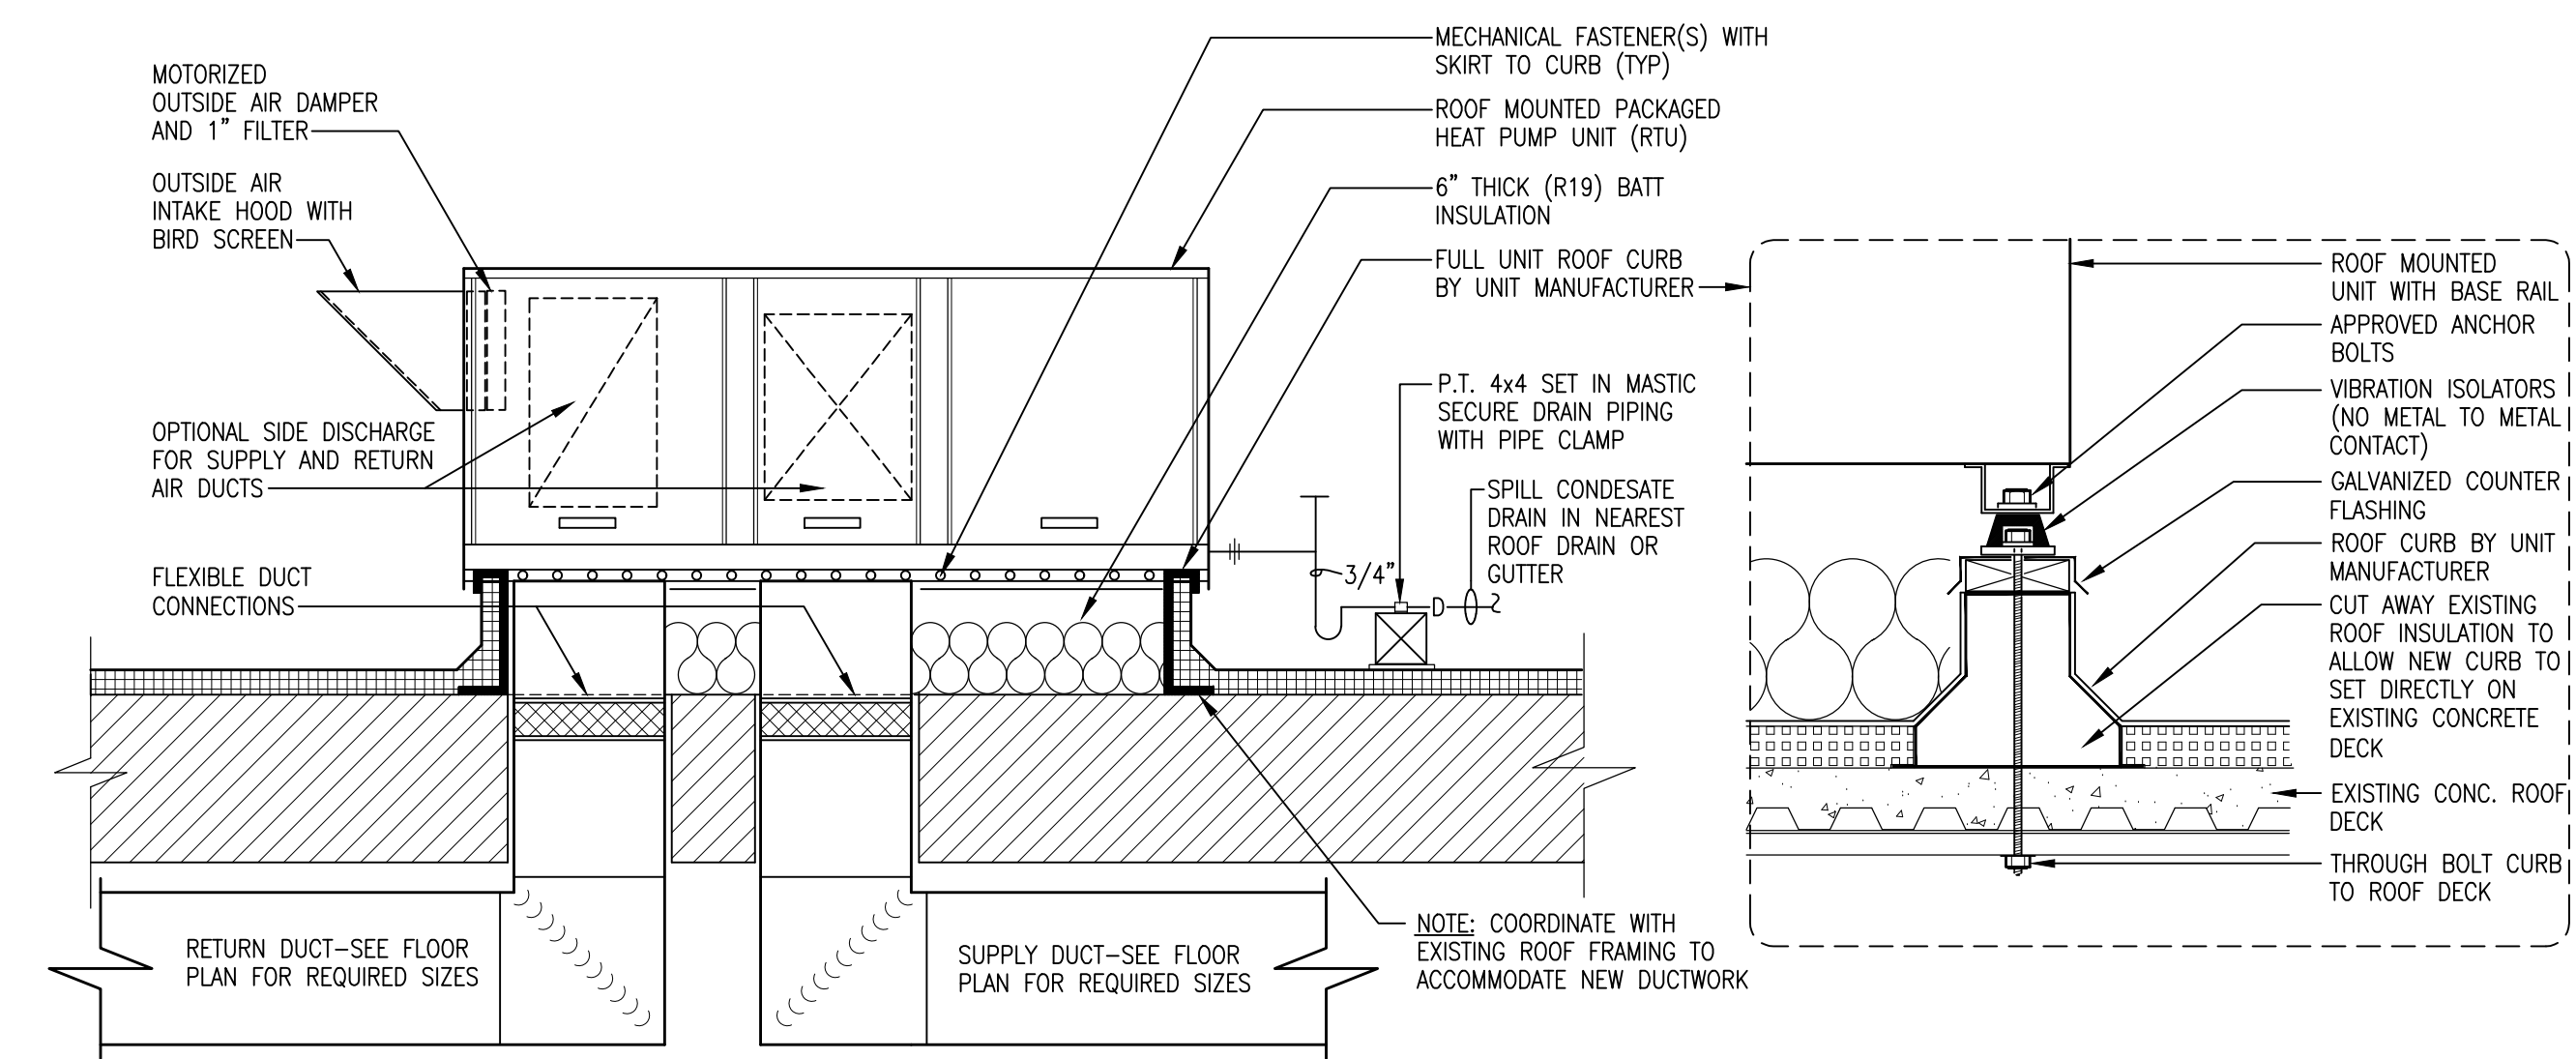


TYPICAL PACKAGED ROOFTOP HEAT PUMP UNIT DETAIL  
NOT TO SCALE

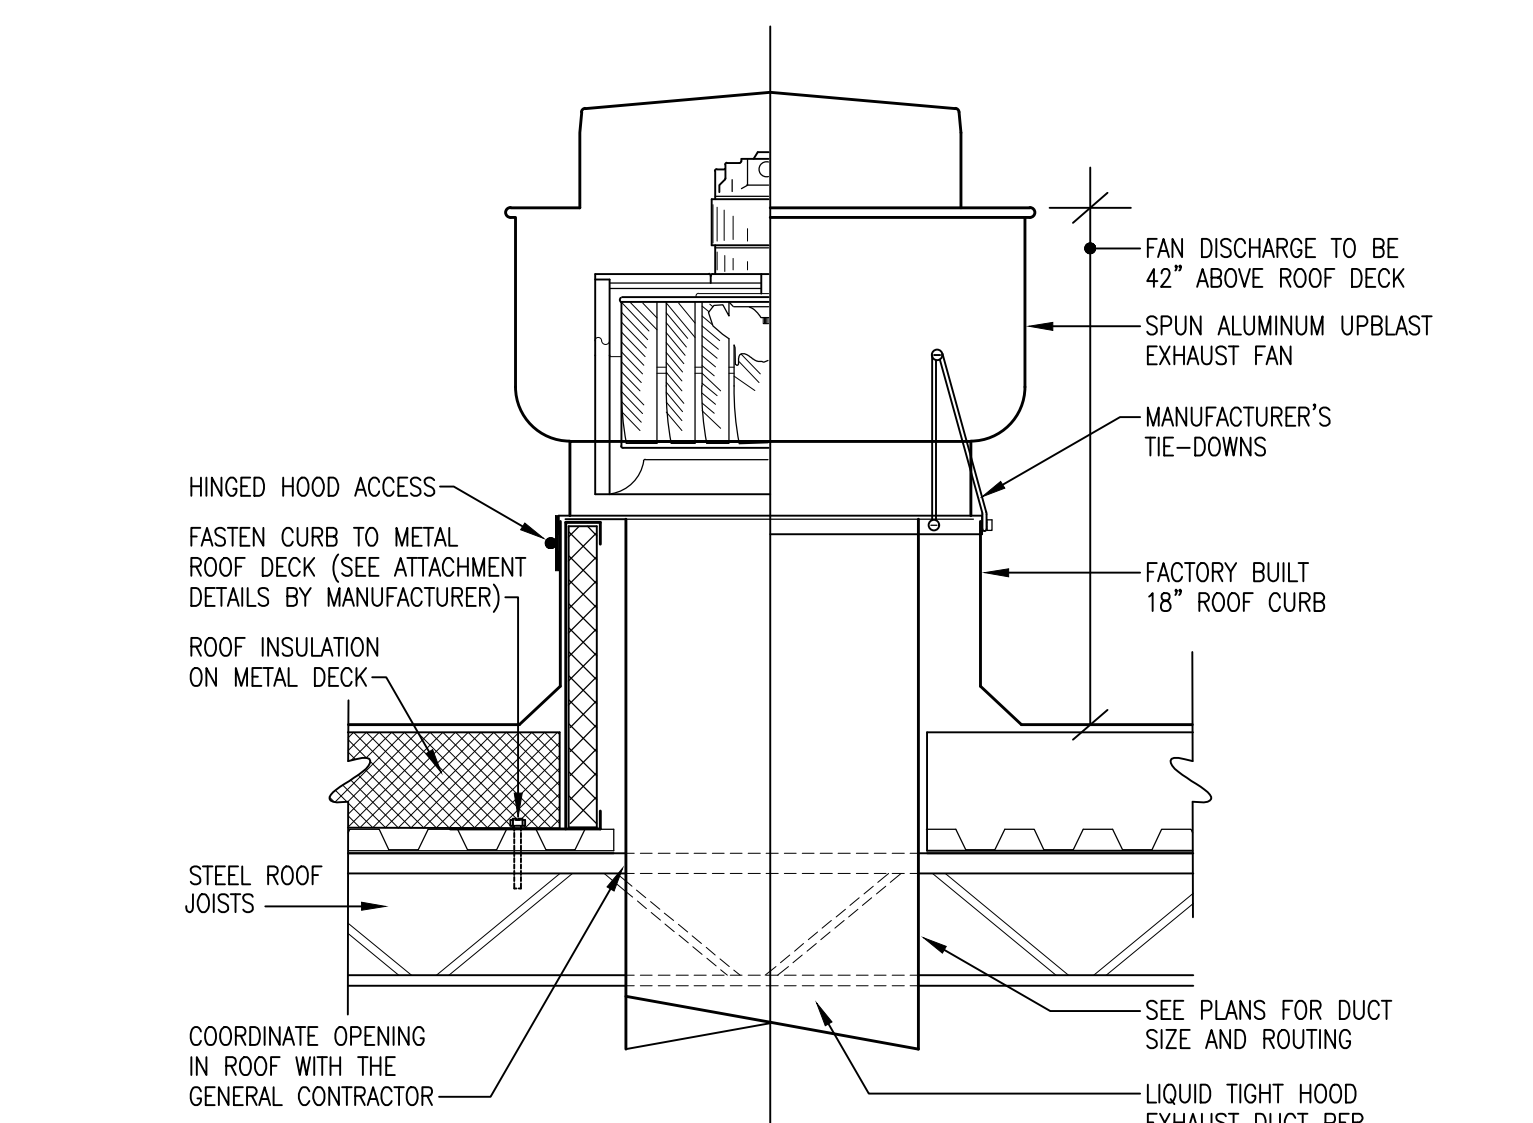


KITCHEN HOOD EXHAUST FAN DETAIL  
NOT TO SCALE

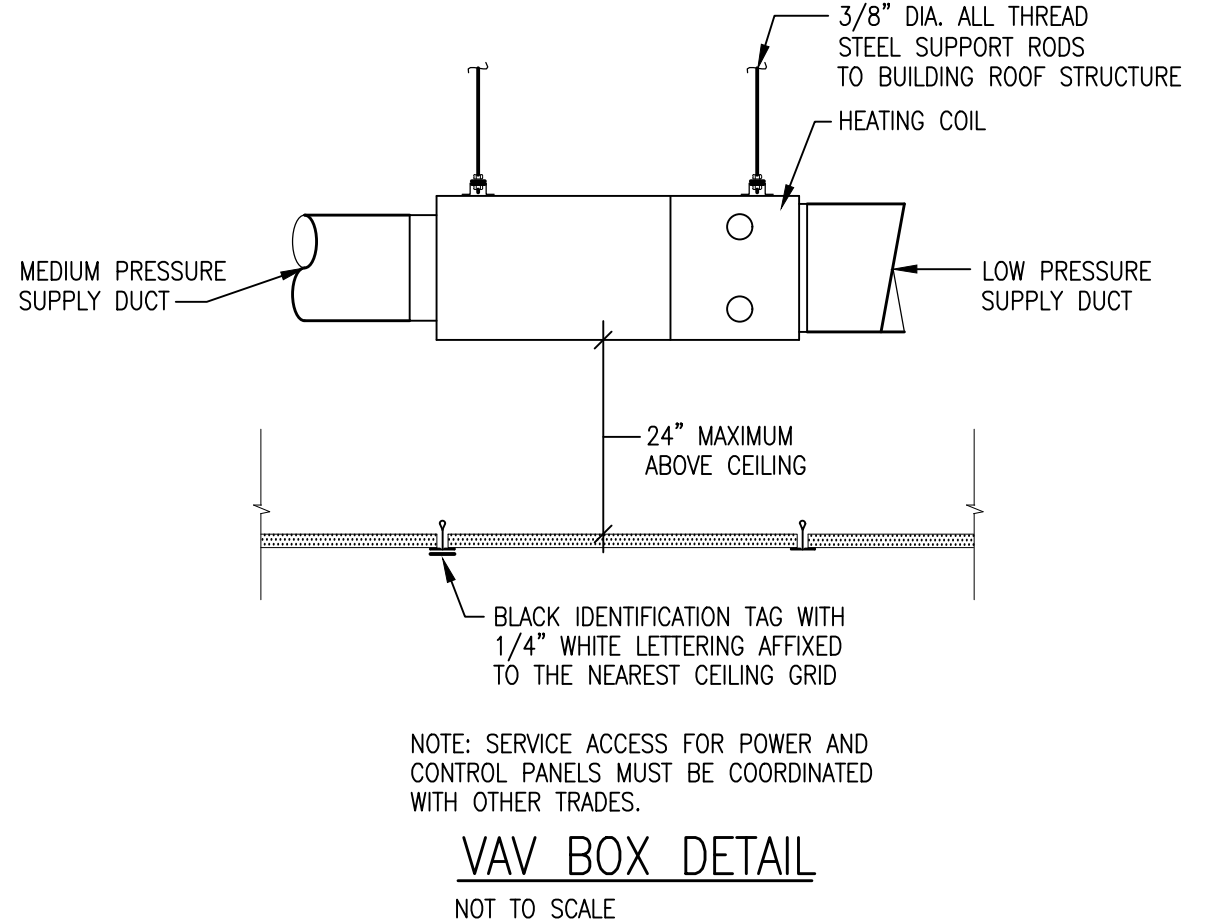


VAV BOX DETAIL  
NOT TO SCALE

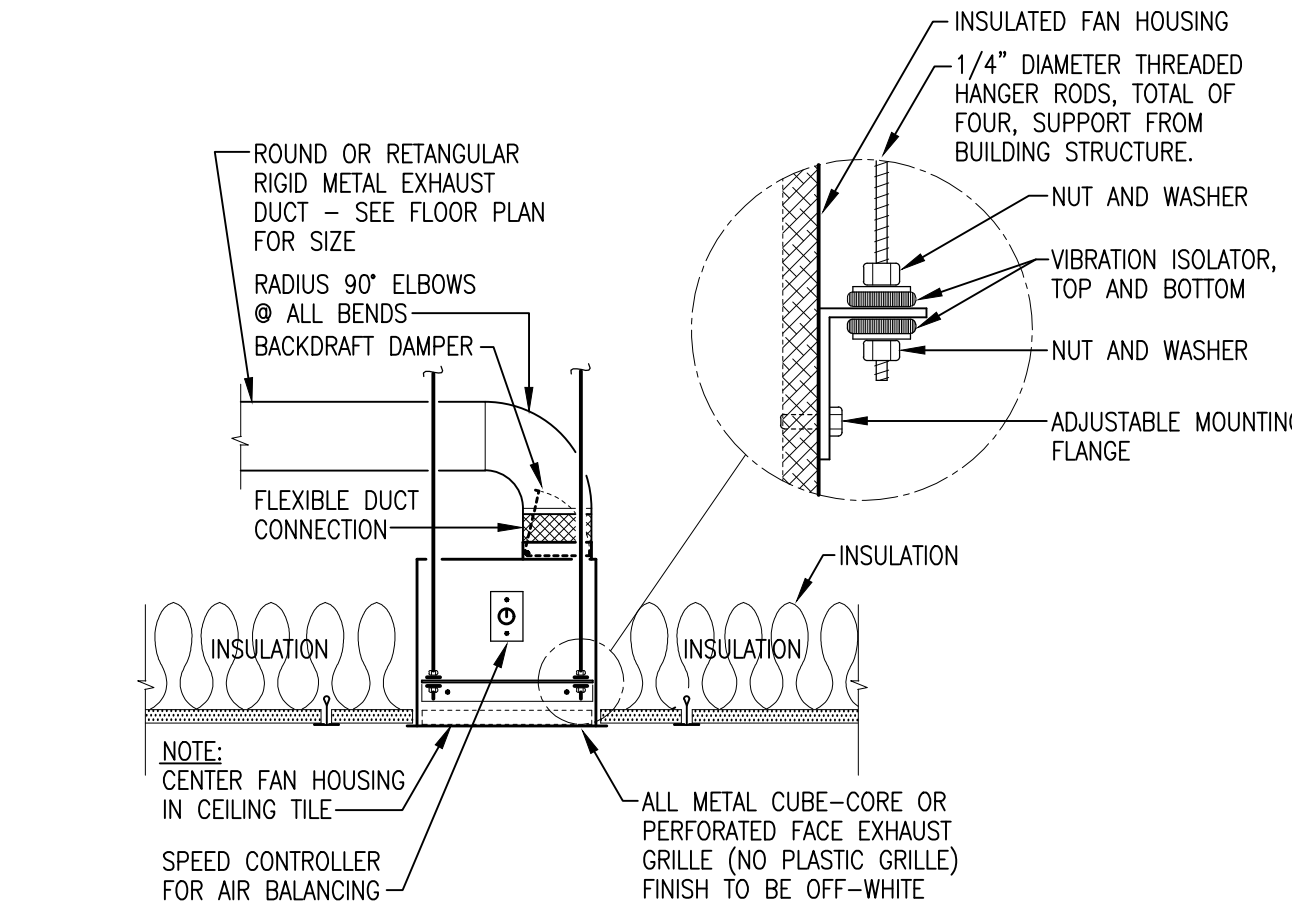


TYPICAL EXHAUST FAN DETAIL  
NOT TO SCALE

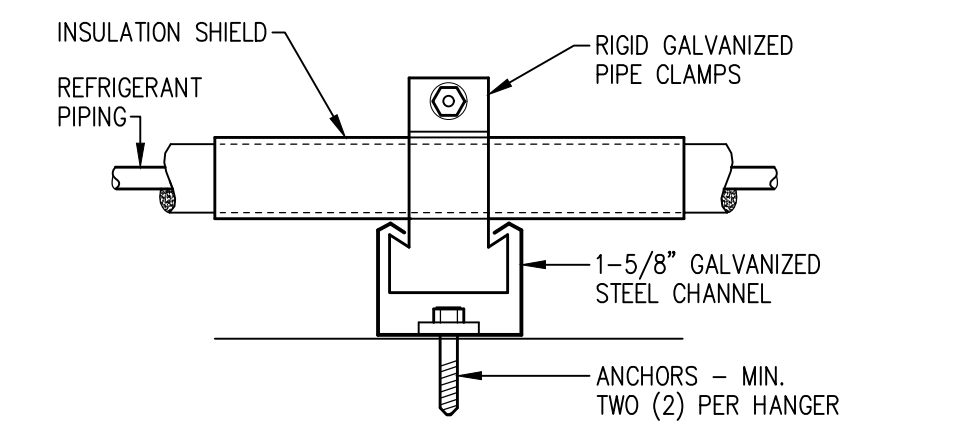

REFRIGERANT/CONDENSATE PIPE SUPPORT DETAIL  
NOT TO SCALE

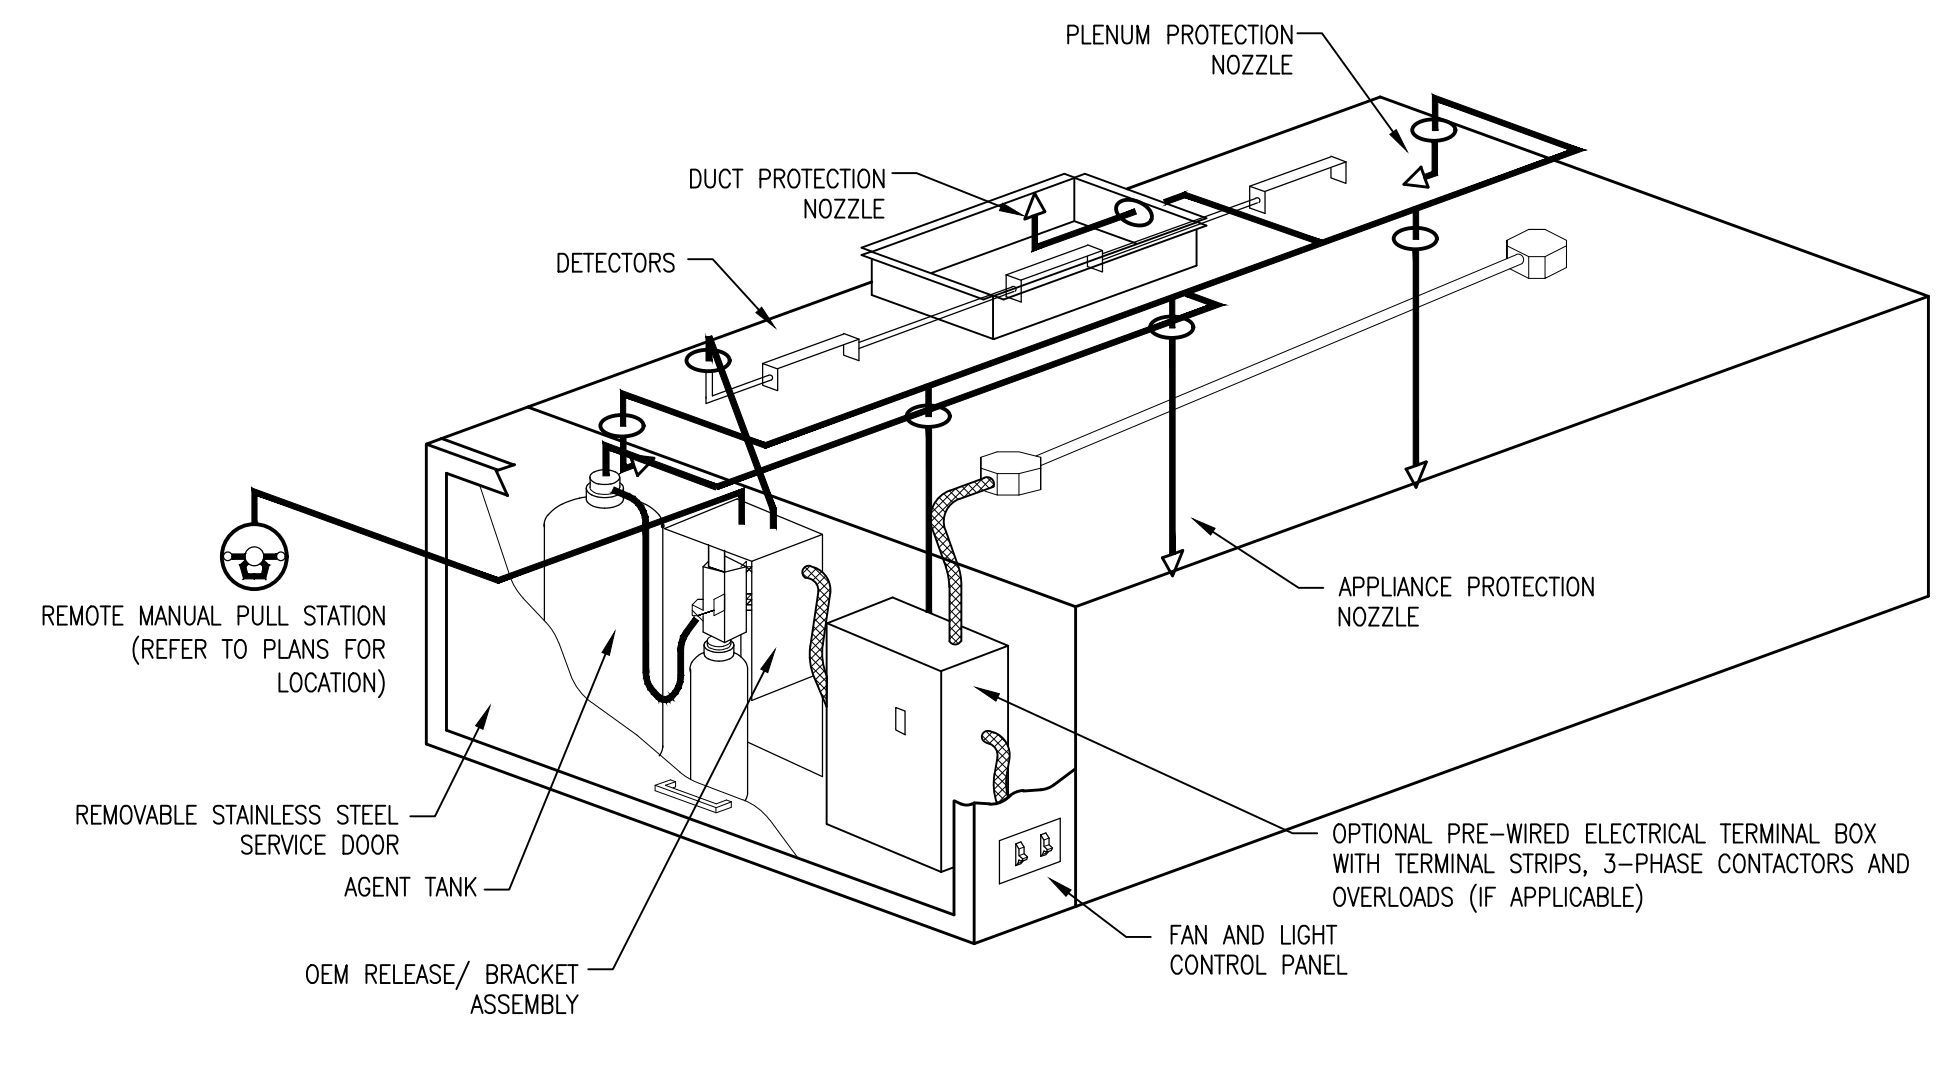


TYPICAL ANSUL R-102 SYSTEM LAYOUT FOR TYPE I HOOD  
NOT TO SCALE

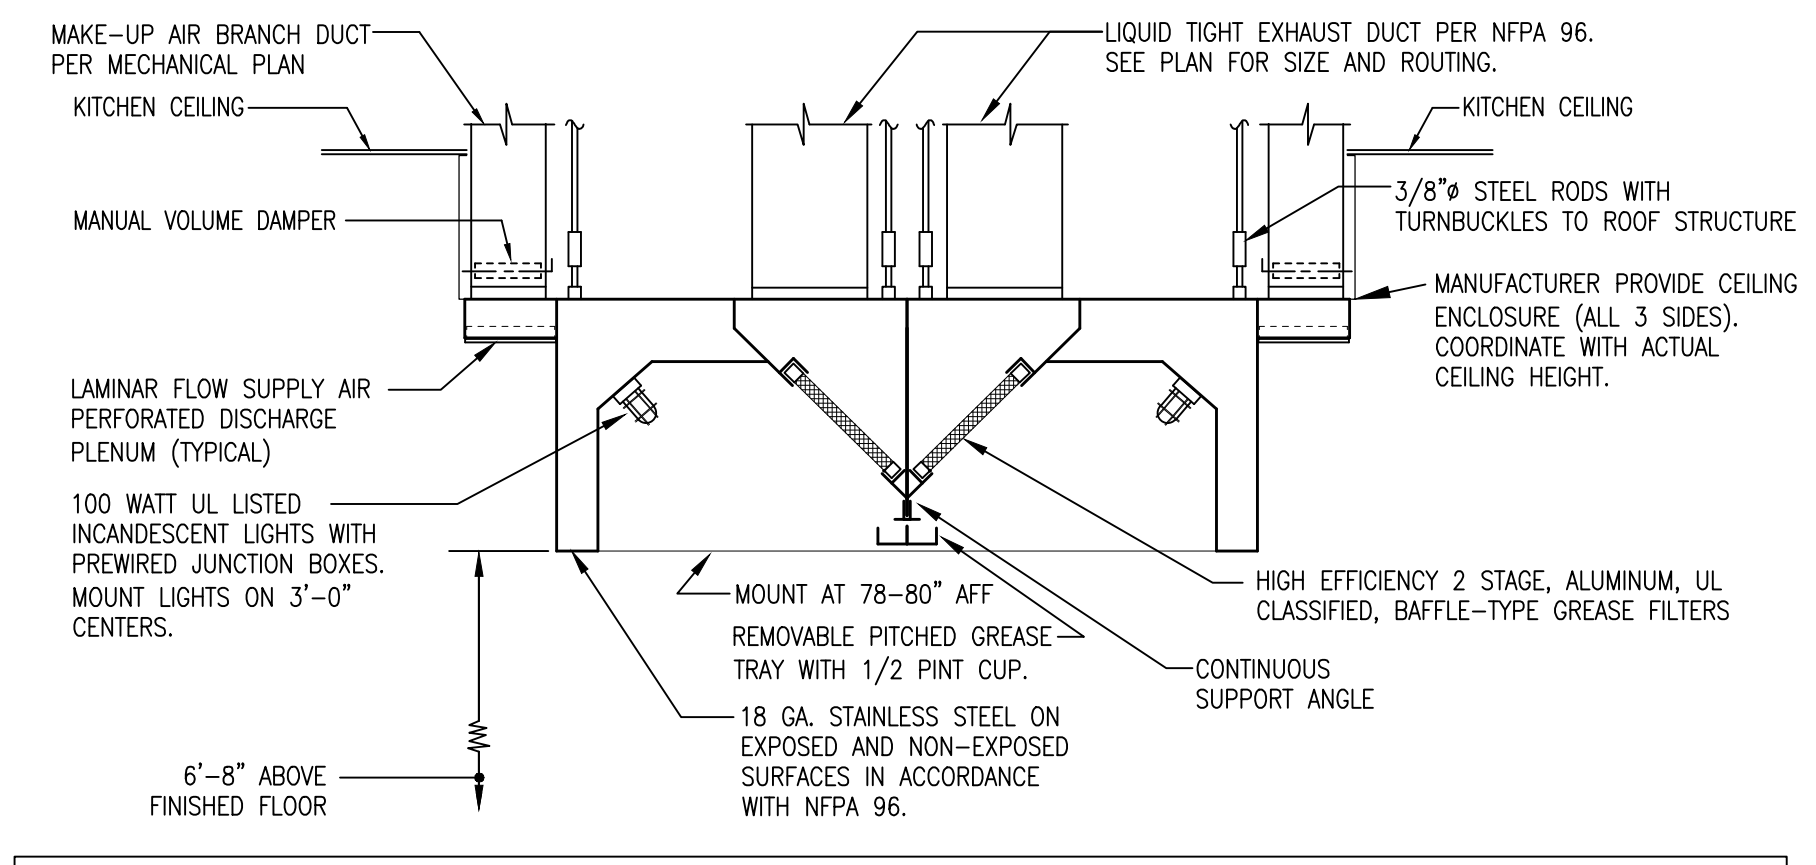


- NOTES:
1. WIDTH OF HOOD SHALL BE 6" LARGER THAN LARGEST PIECE OF COOKING EQUIPMENT AND 12" LONGER THAN SUM OF COOKING EQUIPMENT LENGTHS WITH CONSIDERATION GIVEN TO CLEARANCE BETWEEN COOKING EQUIPMENT HOOD SUPPLIER SHALL PROVIDE AUTOMATIC SHUT OFF, MANUAL RESET GAS VALVE SHALL NOT BE ELECTRONIC SOLENOID TYPE. GAS VALVE SHALL BE SPRING LOADED, MANUAL RESET TYPE.
  2. KITCHEN HOOD TO BE PROVIDED BY MECHANICAL CONTRACTOR AND INSTALLED BY MECHANICAL CONTRACTOR.
  3. A CHEMICAL FIRE SUPPRESSION SYSTEM SHALL BE INCLUDED AS AN INTERNAL PART OF THE HOOD SYSTEM. UPON ACTIVATION OF CHEMICAL SYSTEM SUPPLY FANS SHALL SHUT DOWN AND EXHAUST FANS SHALL OPERATE.
  4. BOTH HOODS SHALL OPERATE SIMULTANEOUSLY SUCH THAT ALL SUPPLY AND EXHAUST FANS OPERATE AT SAME TIME.
  5. PROVIDE AN INTEGRAL THERMAL SENSOR WITH HOOD CONTROLS TO AUTOMATICALLY ACTIVATE FANS AS COOKING EQUIPMENT IS ENERGIZED.
  6. PROVIDE HIGH TEMPERATURE SENSOR WITH HOOD CONTROLS TO SHUT-OFF POWER AND GAS SERVICE TO HOODS.
  7. PROVIDE ALL INTERCONNECTS AND RELAY CONTROL BOXES REQUIRED FOR HOOD CONTROL AND SPECIFICALLY FOR FIRE SUPPRESSION EQUIPMENT CONTROL SYSTEM.


TYPICAL TYPE I KITCHEN HOOD DETAIL  
NOT TO SCALE

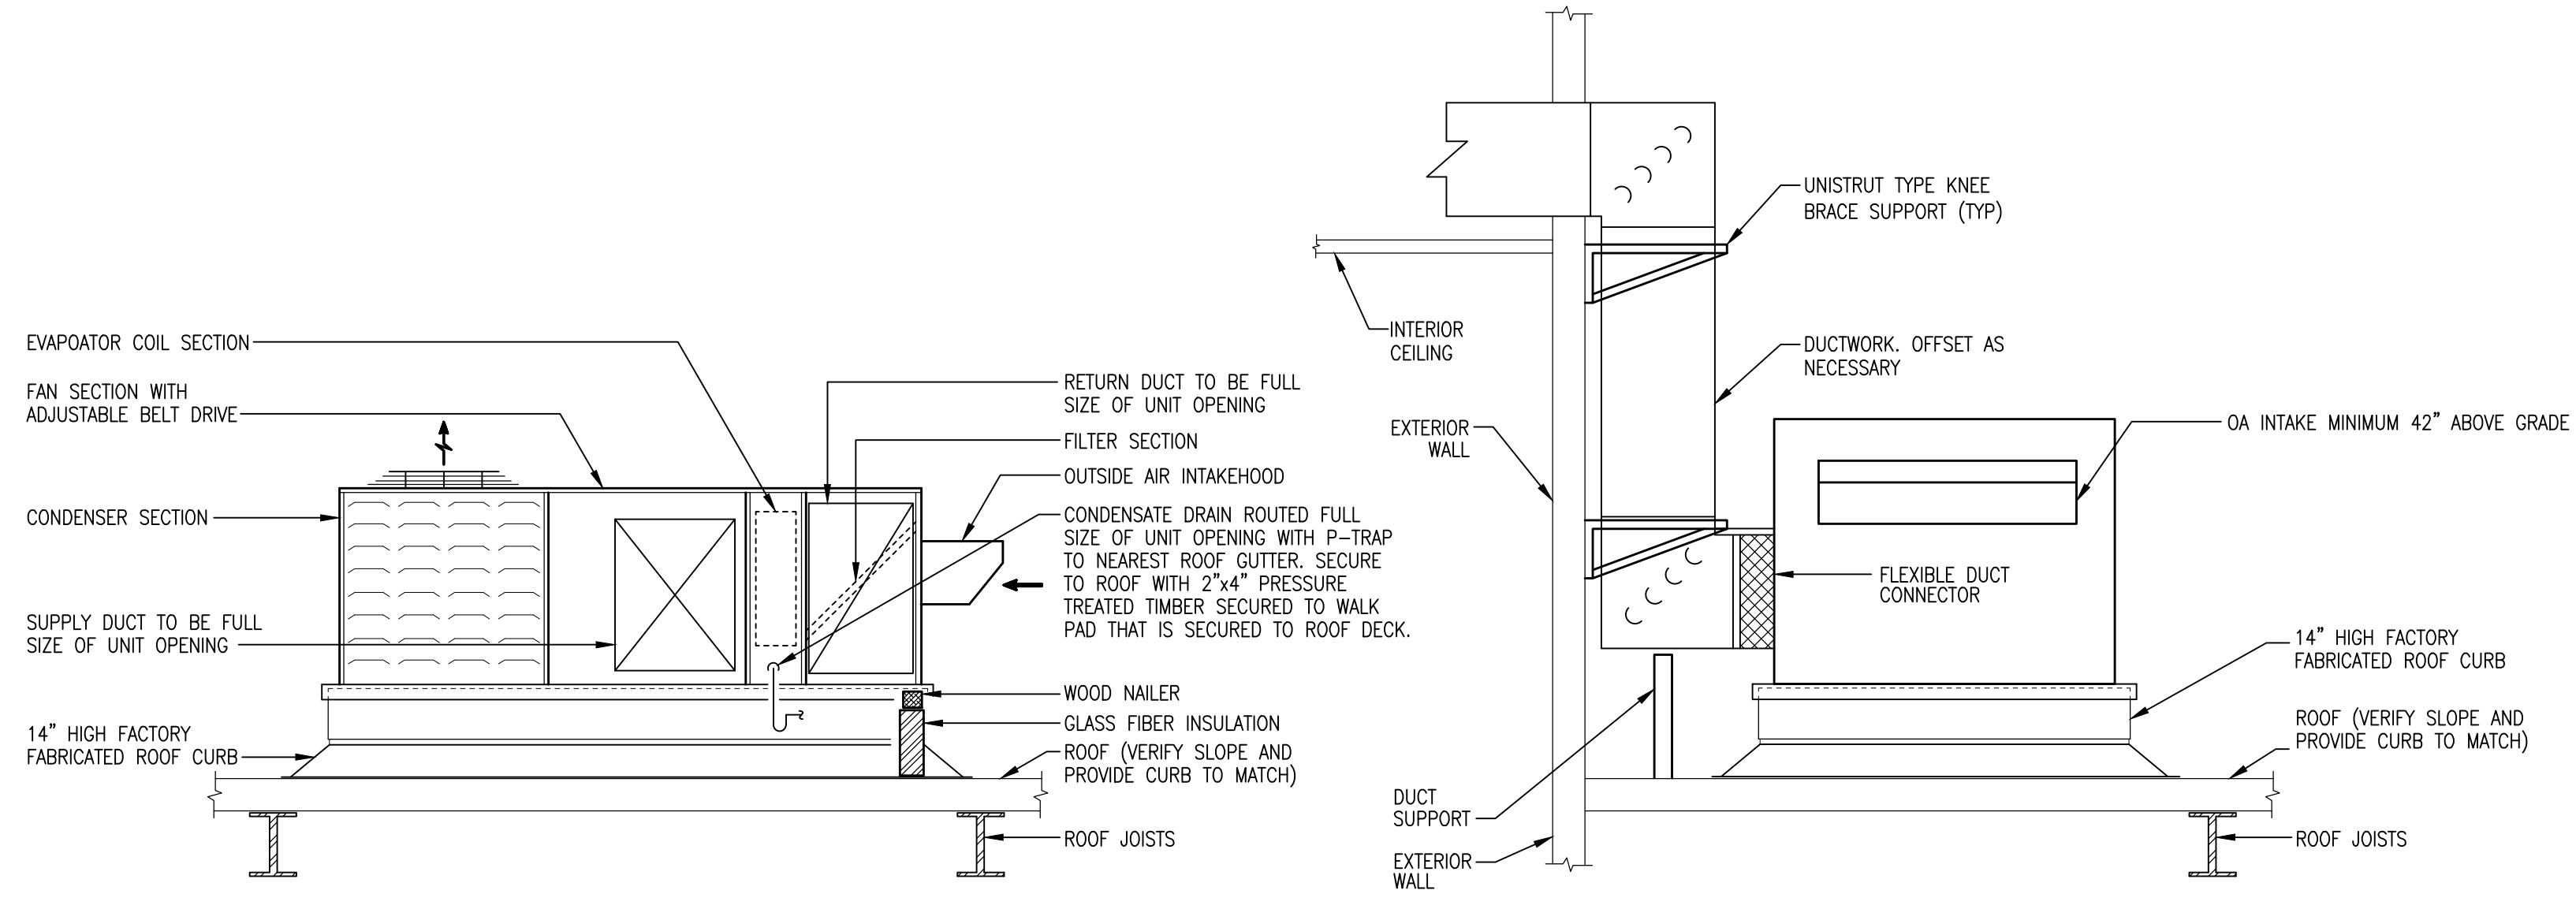


TYPICAL PACKAGED ROOF MOUNTED AIR CONDITIONING UNIT DETAIL  
NOT TO SCALE

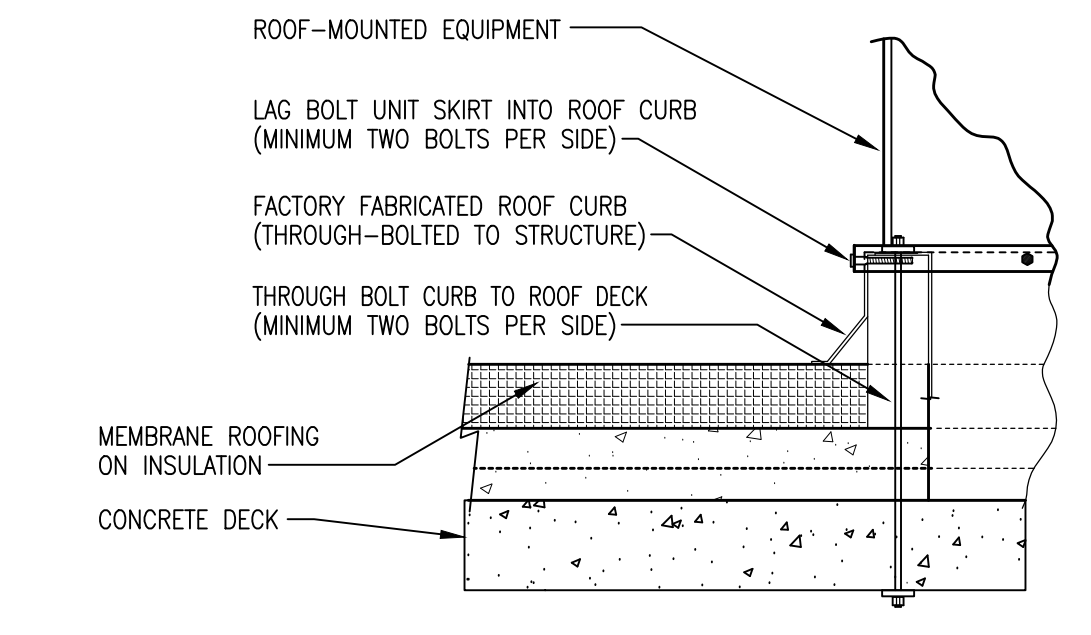


TYPICAL ROOF CURB EQUIPMENT DETAIL  
NOT TO SCALE

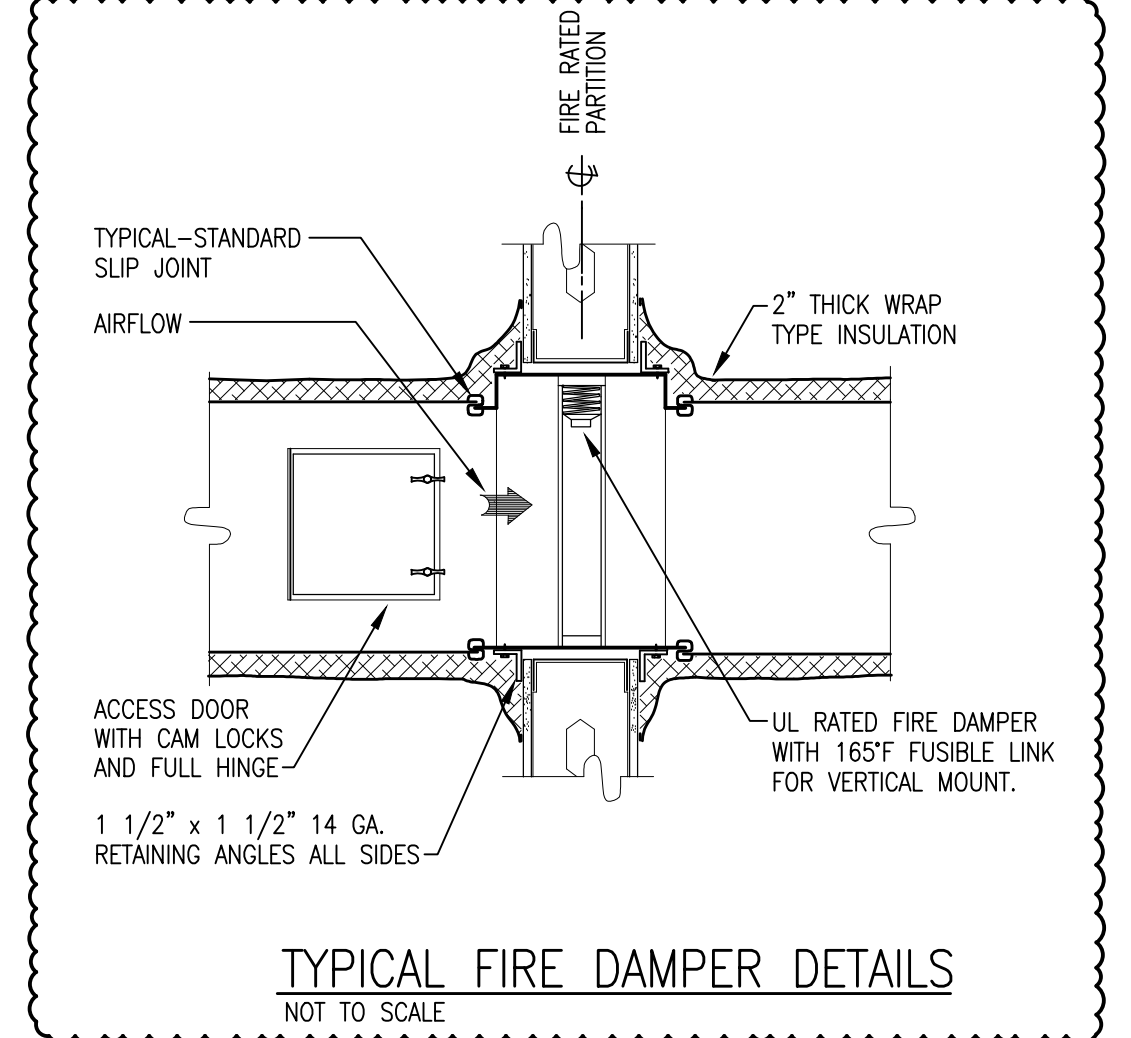


TYPICAL FIRE DAMPER DETAILS  
NOT TO SCALE

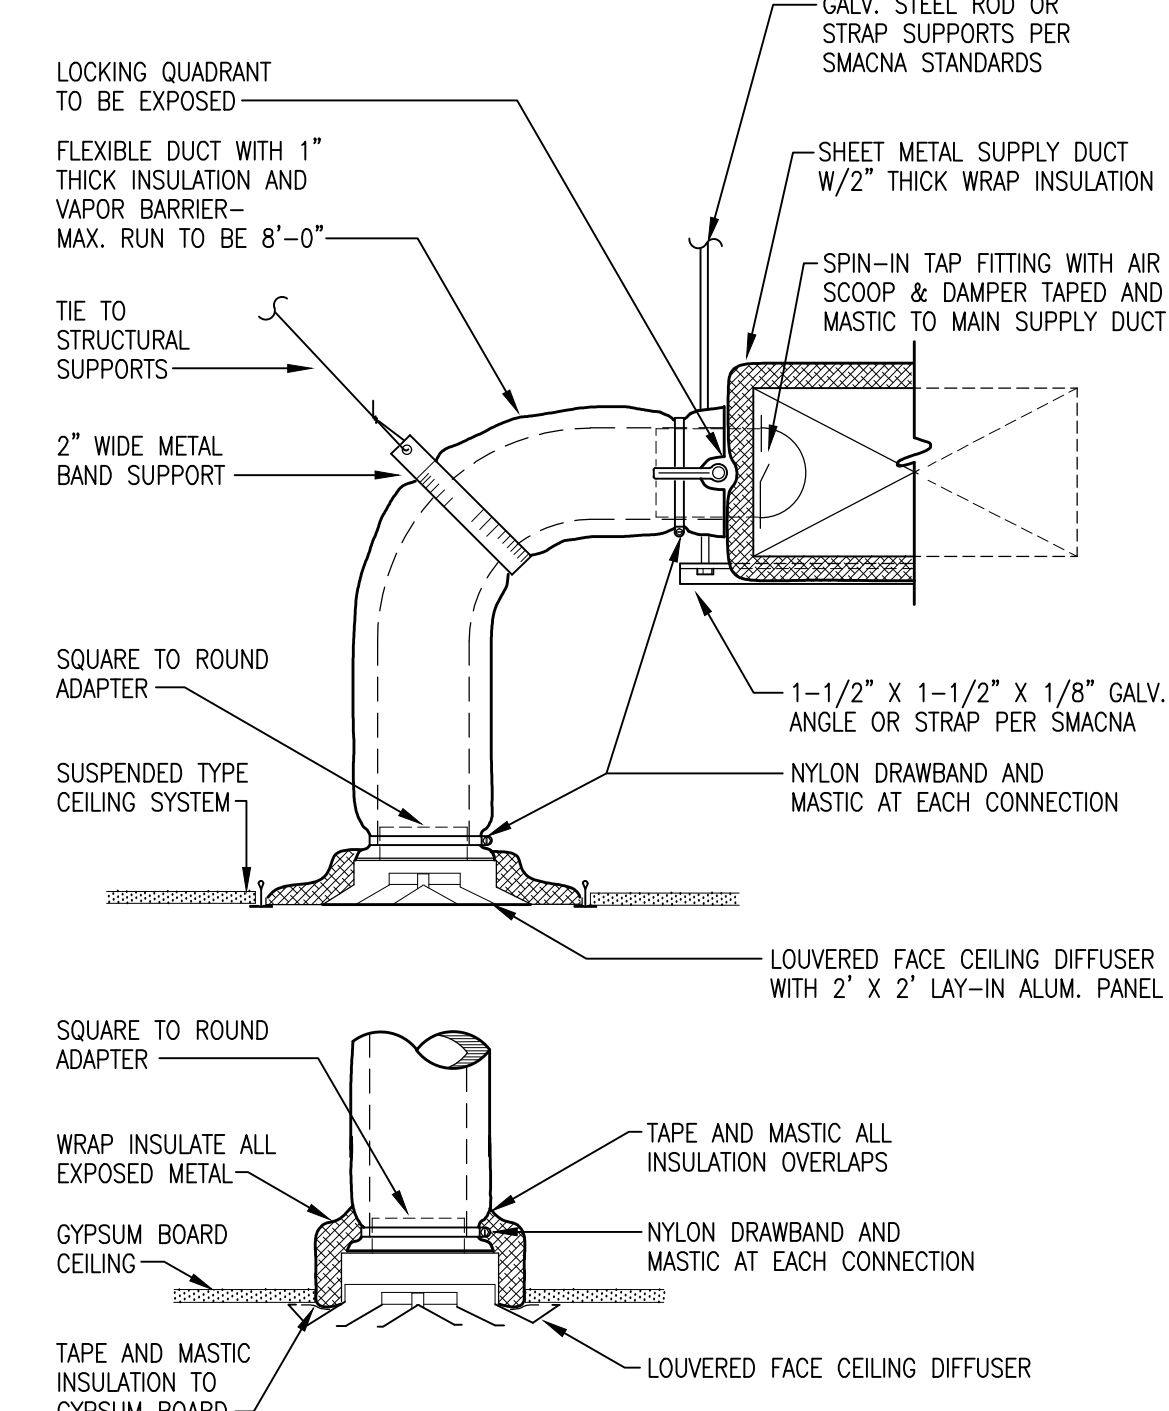

TYPICAL CEILING DIFFUSER DETAIL  
NOT TO SCALE

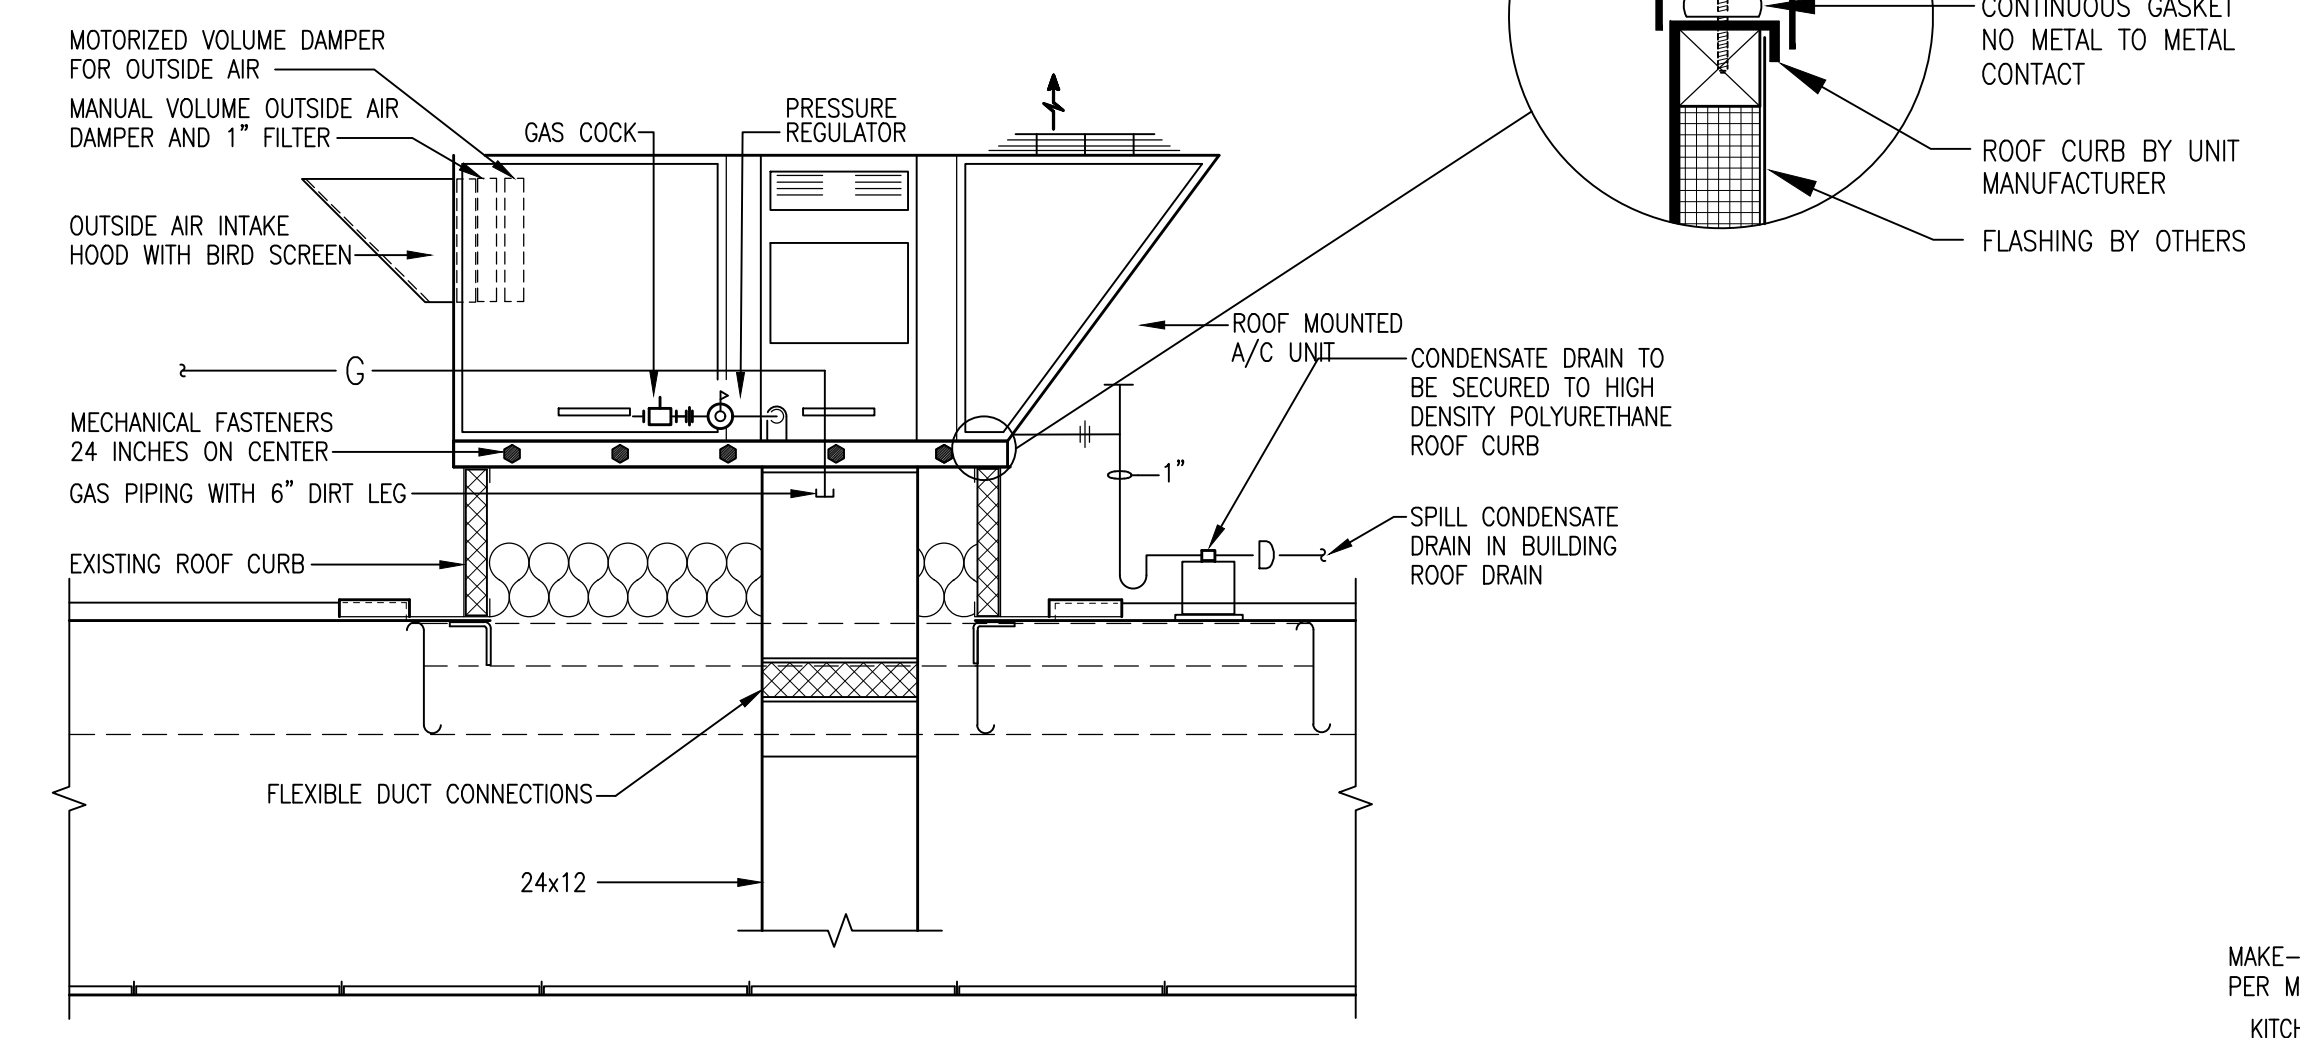


TYPICAL ROOFTOP 100% OUTDOOR AIR UNIT DETAIL  
NOT TO SCALE

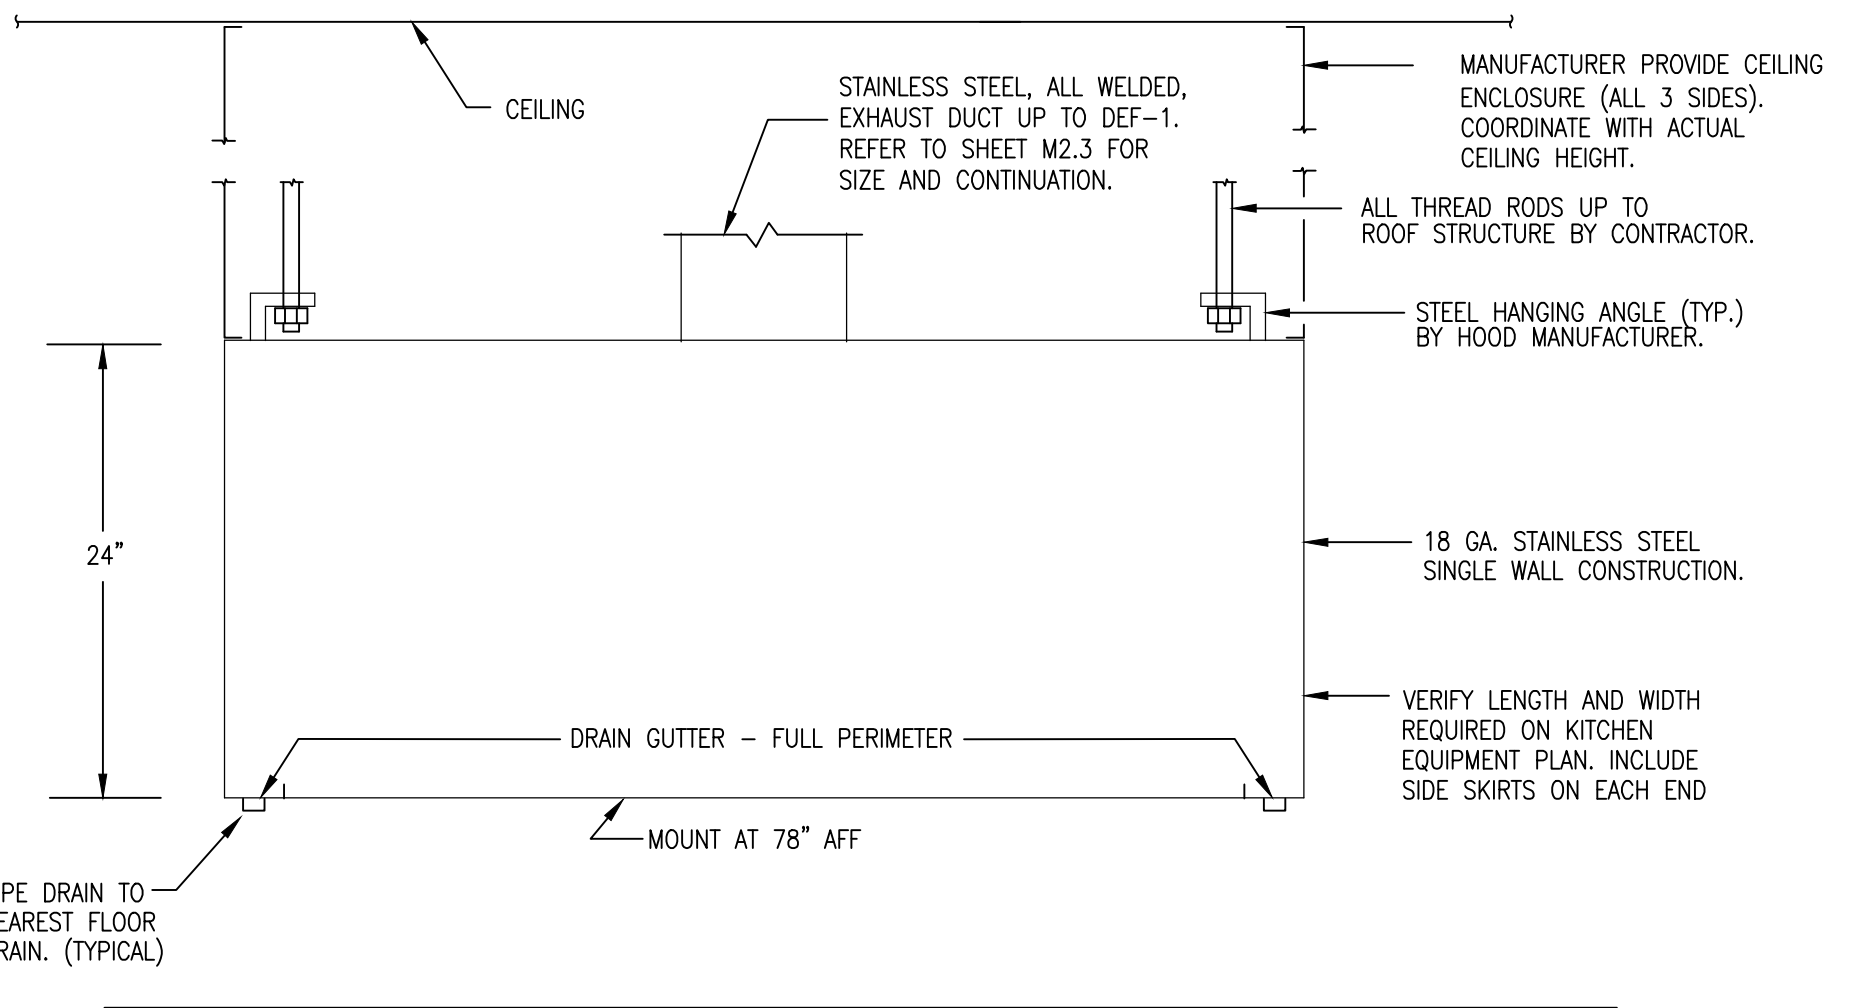

DISHWASHER HOOD (TYPE II) DETAIL  
NOT TO SCALE





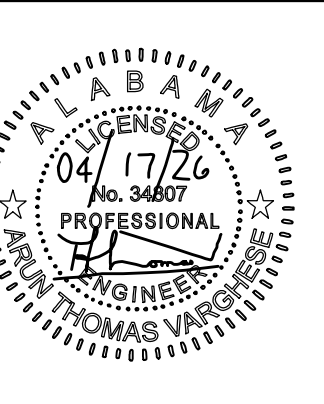


PROJ. MGR.:	A. VARGHESE
DRAWN:	C. PAGE
DATE:	03/25/26
REVISIONS	
#1	04/17/26 DCM COMMENTS

JOB NO. 25-160B

SHEET NO:


**E0.1**

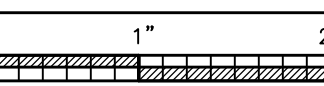

**H.M. YONGE & ASSOCIATES, INC.**  
CONSULTING ENGINEERS // EST. 1988

51 EAST GREGORY STREET  
PENSACOLA, FLORIDA 32502  
PHONE: (904) 384-2061

253 ST. ANTHONY STREET  
MOBILE, ALABAMA 36603  
PHONE: (251) 690-7446

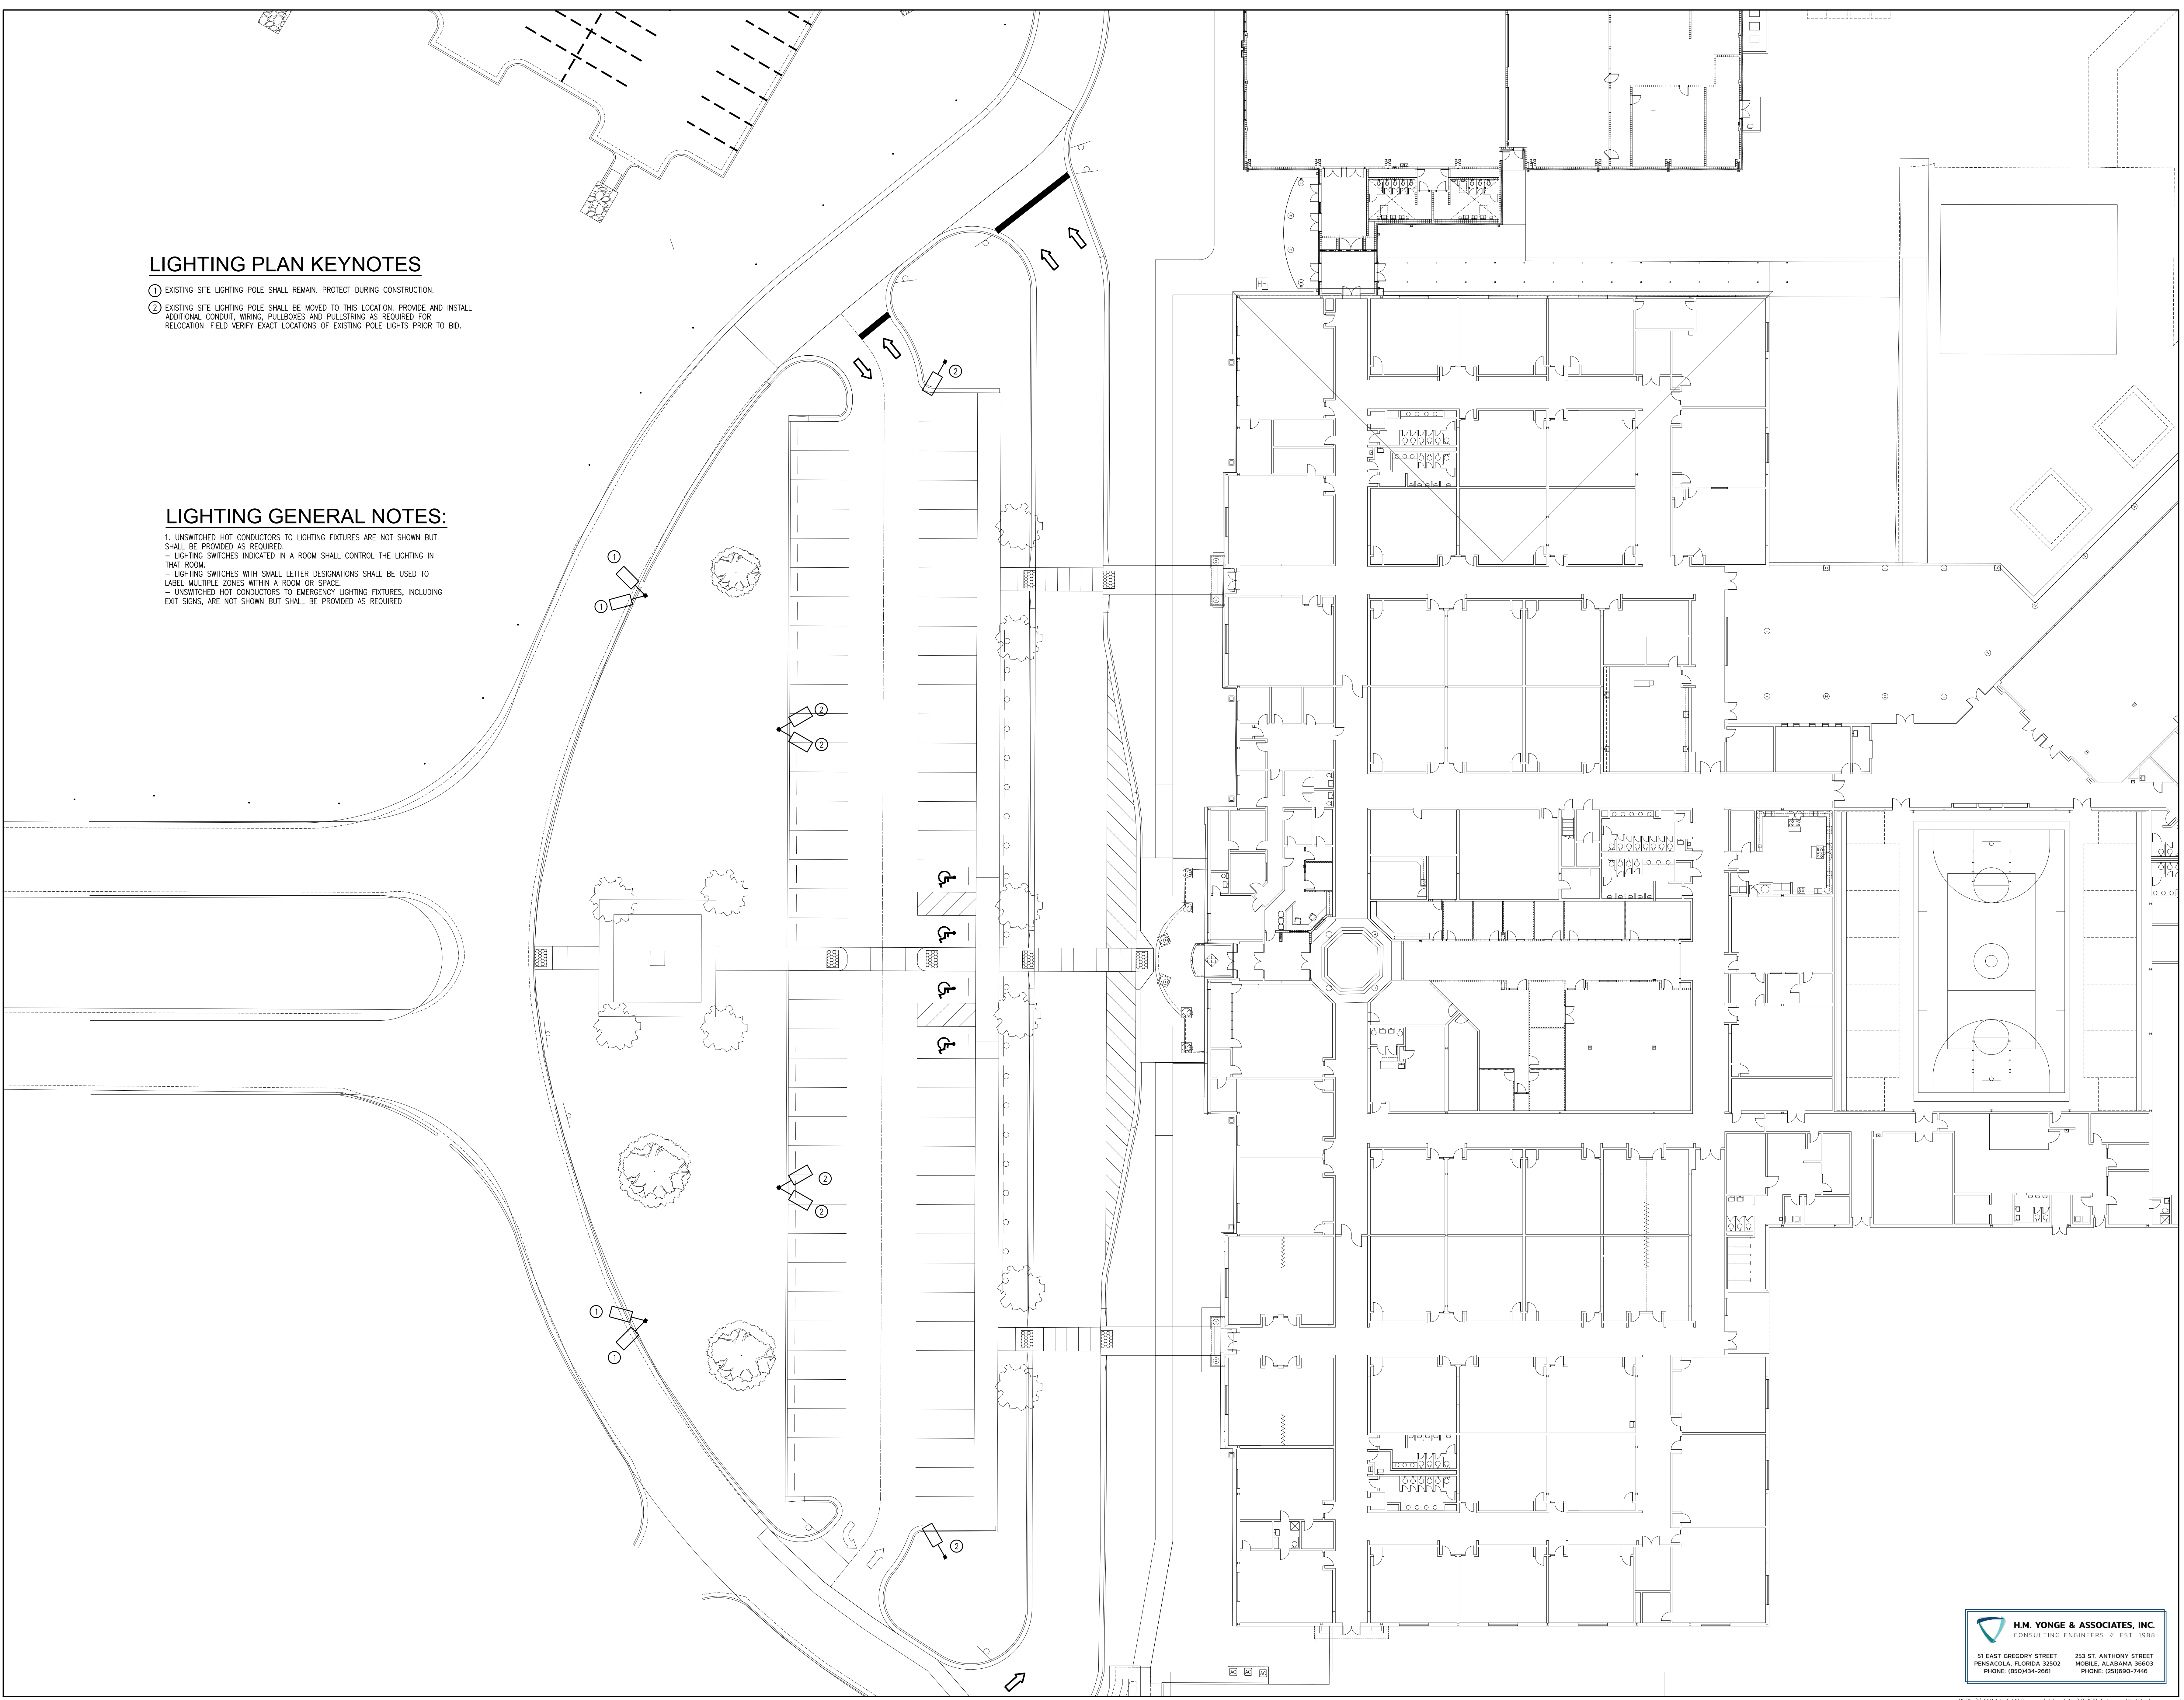

**LIGHTING PLAN KEYNOTES**

- ① EXISTING SITE LIGHTING POLE SHALL REMAIN. PROTECT DURING CONSTRUCTION.
- ② EXISTING SITE LIGHTING POLE SHALL BE MOVED TO THIS LOCATION. PROVIDE AND INSTALL ADDITIONAL CONDUIT, WIRING, PULLBOXES AND PULLSTRING AS REQUIRED FOR RELOCATION. FIELD VERIFY EXACT LOCATIONS OF EXISTING POLE LIGHTS PRIOR TO BID.


**LIGHTING GENERAL NOTES:**

- 1. UNSWITCHED HOT CONDUCTORS TO LIGHTING FIXTURES ARE NOT SHOWN BUT SHALL BE PROVIDED AS REQUIRED.
- LIGHTING SWITCHES INDICATED IN A ROOM SHALL CONTROL THE LIGHTING IN THAT ROOM.
- LIGHTING SWITCHES WITH SMALL LETTER DESIGNATIONS SHALL BE USED TO LABEL MULTIPLE ZONES WITHIN A ROOM OR SPACE.
- UNSWITCHED HOT CONDUCTORS TO EMERGENCY LIGHTING FIXTURES, INCLUDING EXIT SIGNS, ARE NOT SHOWN BUT SHALL BE PROVIDED AS REQUIRED.



**SITE IMPROVEMENTS AND  
INTERIOR ALTERATIONS TO  
FAIRHOPE HIGH SCHOOL**  
ONE PIRATE DRIVE  
FAIRHOPE, ALABAMA 36532  
BALDWIN COUNTY PUBLIC SCHOOLS

SHEET TITLE: LIGHTING OVERALL NEW WORK PLAN

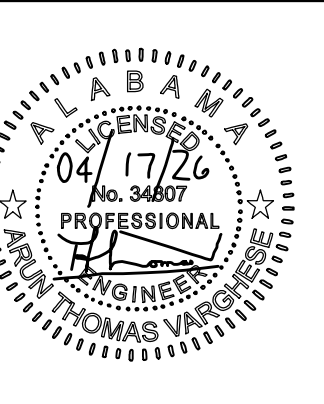

PROJ. MGR.: A. VARGHESE  
DRAWN: C. PAGE

DATE: 03/25/26



REVISIONS

#1 04/17/26 DCM  
COMMENTS

JOB NO. 25-160B

SHEET NO:

**E1.0**

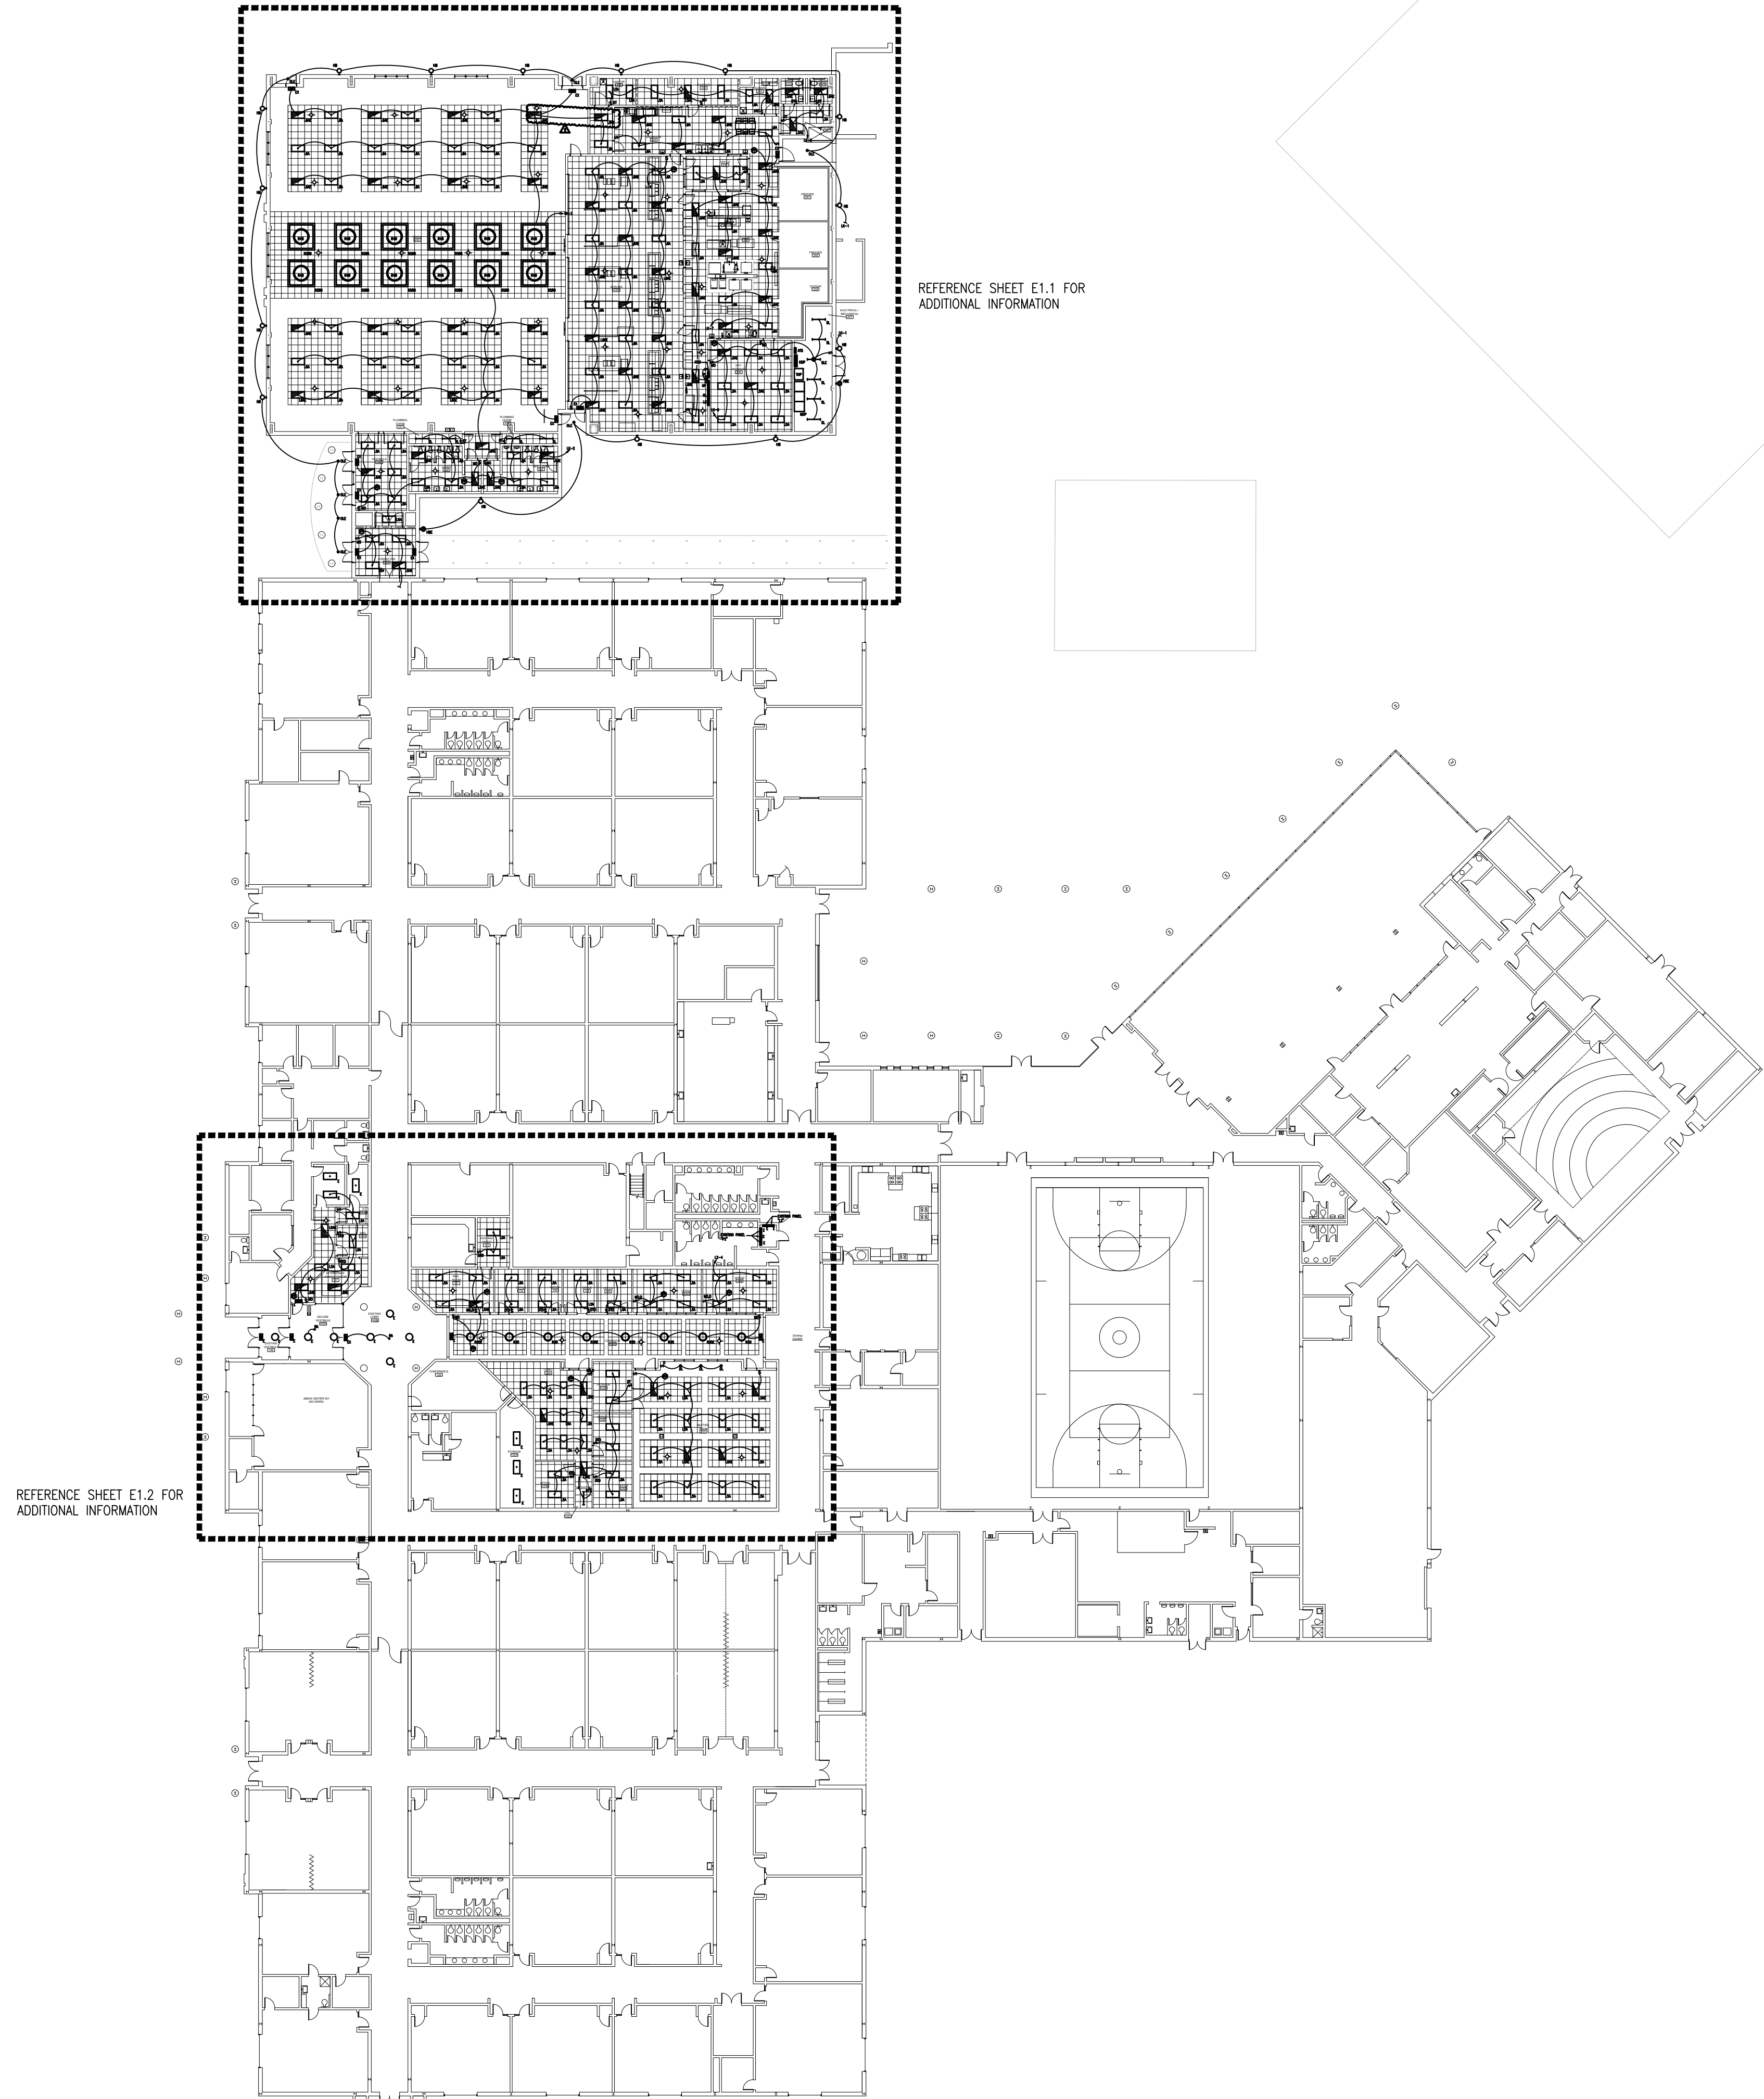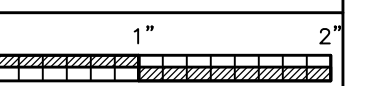

**LIGHTING OVERALL NEW WORK PLAN**


SCALE: 1" = 30'-0"



**H.M. YONGE & ASSOCIATES, INC.**  
CONSULTING ENGINEERS / EST. 1988

51 EAST GREGORY STREET  
PENSACOLA, FLORIDA 32502  
PHONE: (904)334-3561

253 ST. ANTHONY STREET  
MOBILE, ALABAMA 36603  
PHONE: (251)690-7446

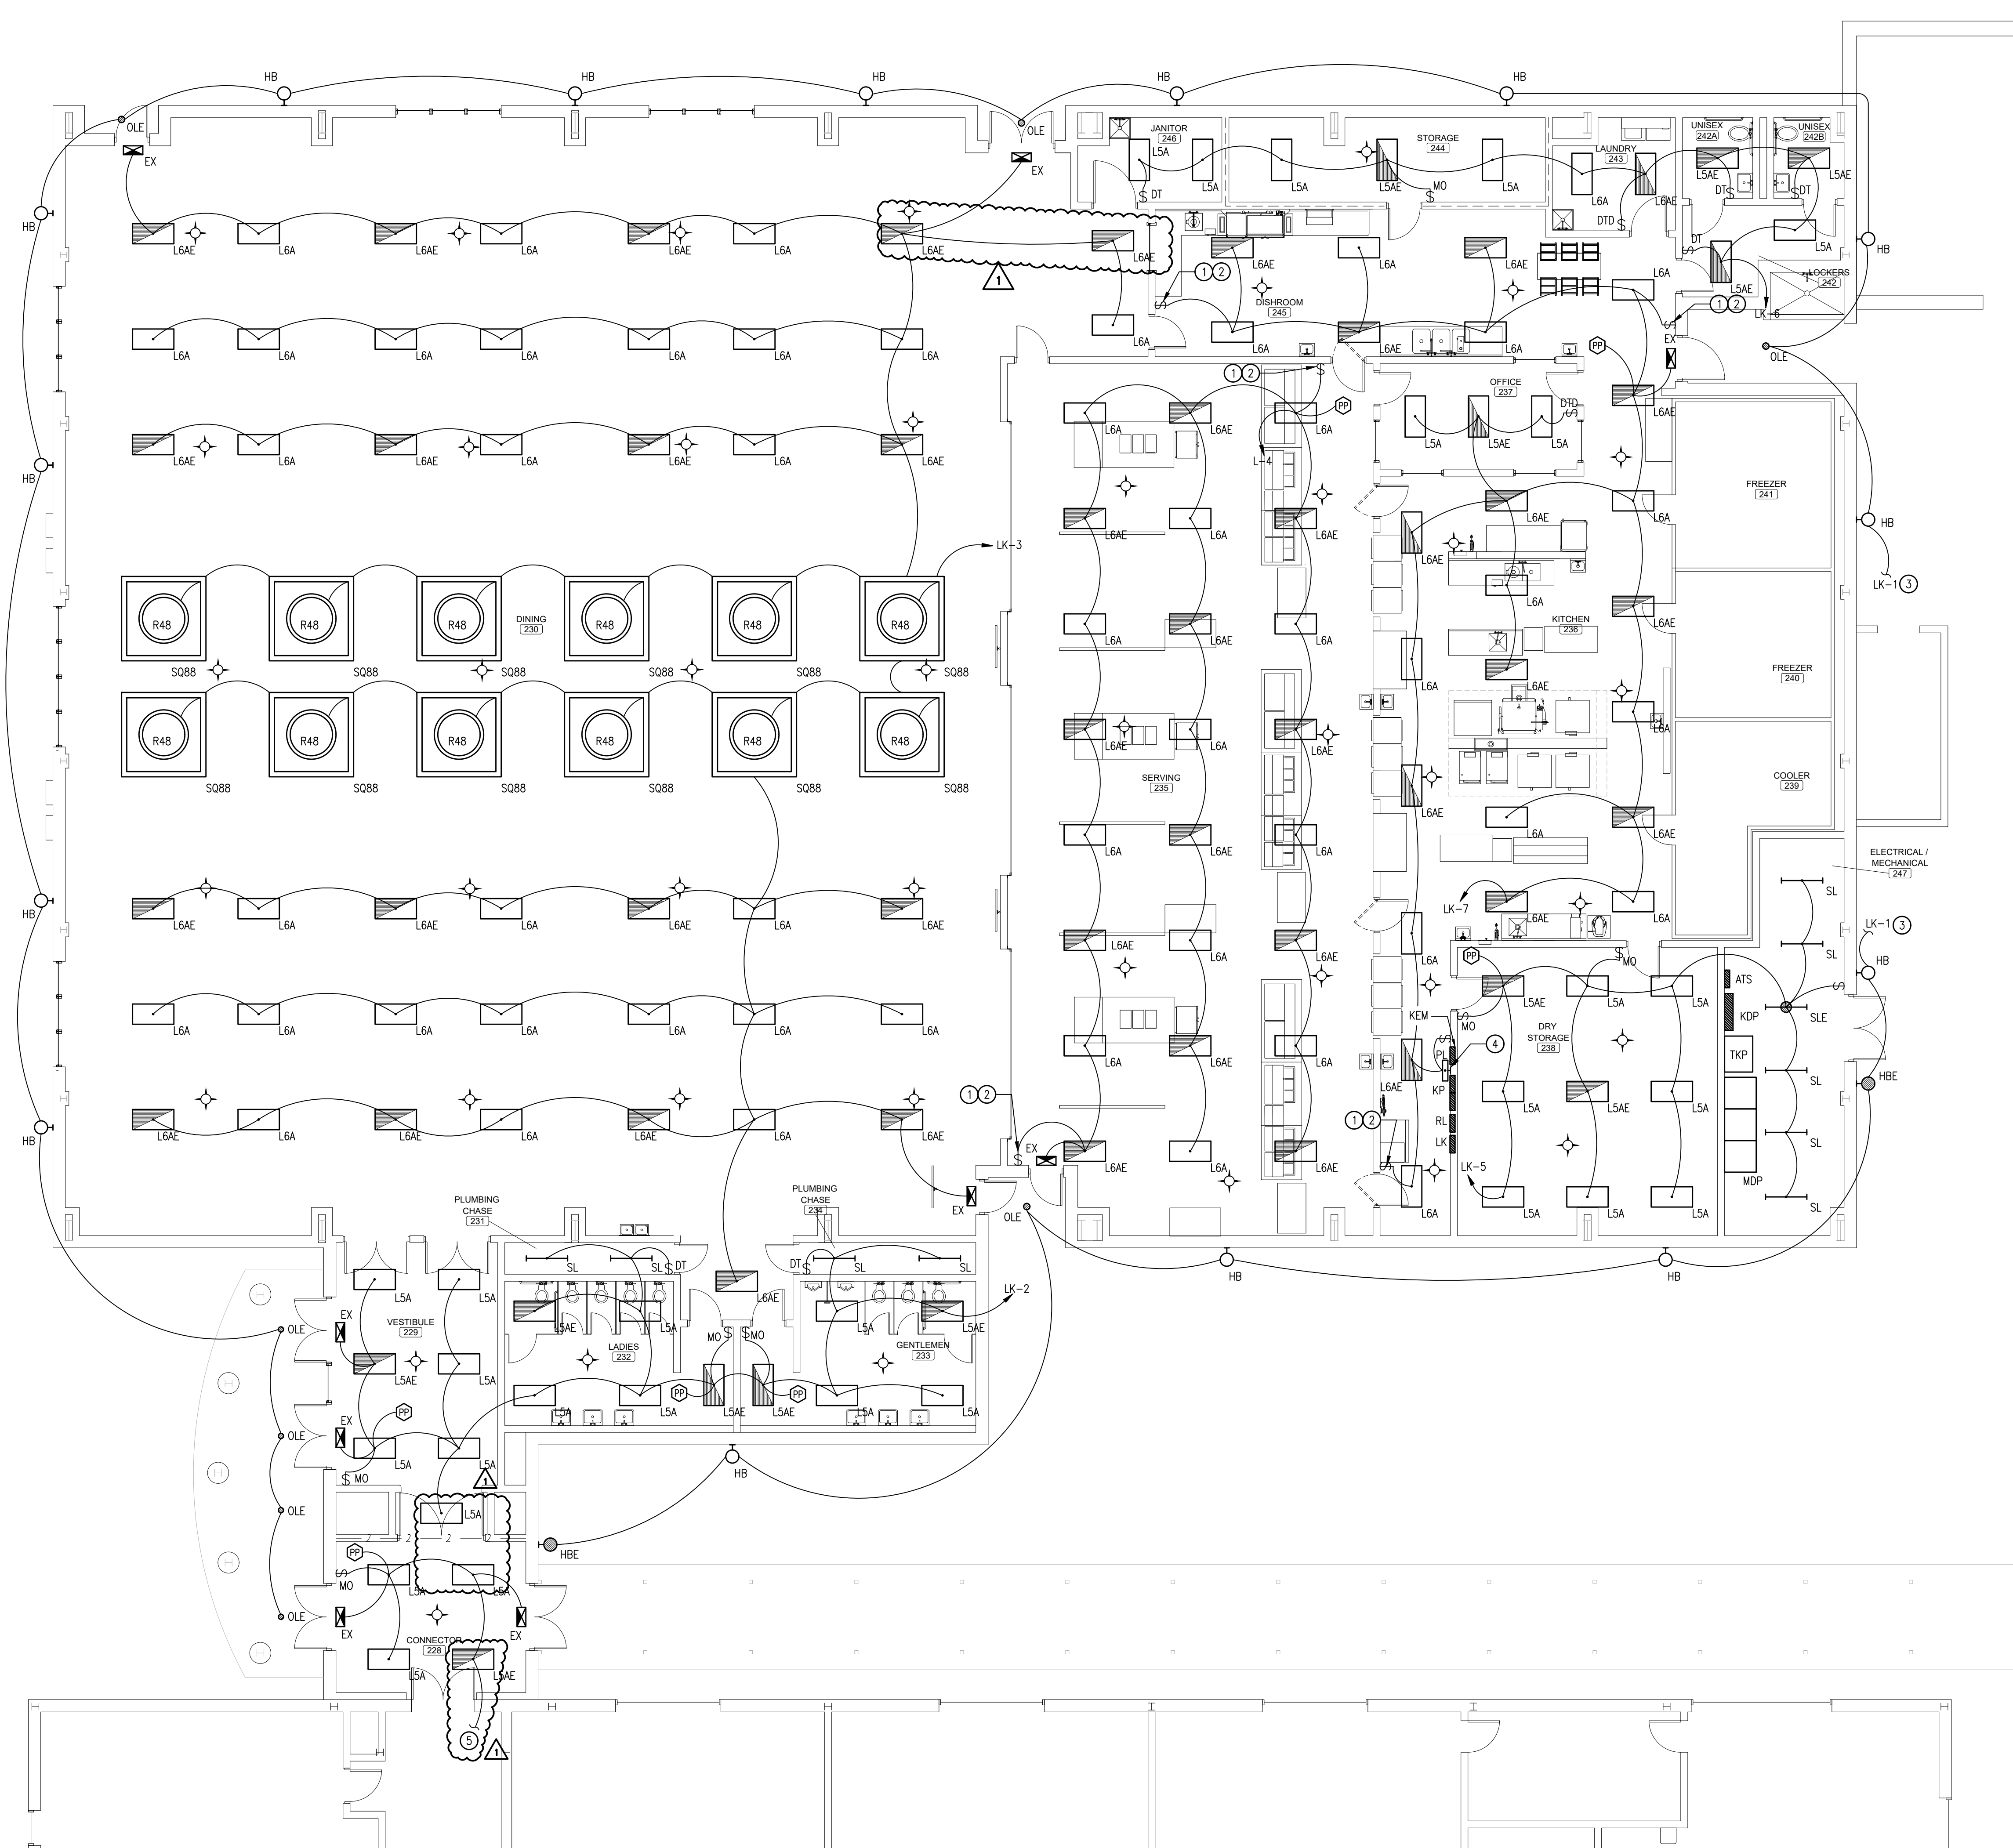

**LIGHTING PLAN KEYNOTES**


- 1 PROVIDE NEW WATTSTOPPER DLM ROOM CONTROLLER, LMRC-211 FOR USE WITH MULTI-WAY DIMMING CIRCUIT IN THIS ROOM. COORDINATE CONNECTION REQUIREMENTS WITH MANUFACTURER.
- 2 NEW MULTI-WAY DIMMING SWITCH SHALL BE WATTSTOPPER LMSW-211-W. SWITCHES SHALL BE USED IN JUNCTION WITH NEW DLM ROOM CONTROLLER. COORDINATE CONNECTION REQUIREMENTS WITH MANUFACTURER.
- 3 HOMERUN SHALL BE REROUTED THROUGH INTERMATIC ET8000 ASTRONOMIC TIME CLOCK IN NEMA 3R ENCLOSURE, COORDINATE TIME OF DAY SCHEDULE WITH OWNER. TIME CLOCK SHALL BE INSTALLED ADJACENT TO SERVING PANELS/BOARDS.
- 4 NEW LIGHT SHALL BE WALL MOUNTED ABOVE PANELS. NEW LIGHT SHALL NOT BE CONTROLLED BY AUTOMATIC MEANS. PROVIDE UNSWITCHED HOT CONNECTION AND CONTROL VIA MANUAL ON/OFF SWITCH.
- 5 NEW LIGHTING FIXTURES SHALL BE TIED IN TO EXISTING HALLWAY LIGHTING CIRCUIT IN EXISTING BUILDING. PROVIDE A NEW UNSWITCHED HOT CONNECTION FROM THE EXISTING LIGHTING CIRCUIT. PROVIDE AND INSTALL ANY CONDUIT, WIRING, OR JUNCTION BOXES AS REQUIRED FOR CONNECTION.

**LIGHTING GENERAL NOTES:**

1. UNSWITCHED HOT CONDUCTORS TO LIGHTING FIXTURES ARE NOT SHOWN BUT SHALL BE PROVIDED AS REQUIRED.
  - LIGHTING SWITCHES INDICATED IN A ROOM SHALL CONTROL THE LIGHTING IN THAT ROOM.
  - LIGHTING SWITCHES WITH SMALL LETTER DESIGNATIONS SHALL BE USED TO LABEL MULTIPLE ZONES WITHIN A ROOM OR SPACE.
  - UNSWITCHED HOT CONDUCTORS TO EMERGENCY LIGHTING FIXTURES, INCLUDING EXIT SIGNS, ARE NOT SHOWN BUT SHALL BE PROVIDED AS REQUIRED.

**LIGHTING NEW WORK PLAN -  
CAFETERIA-KITCHEN BUILDING**

SCALE: 1/8" = 1'-0"

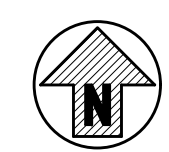


**H.M. YONGE & ASSOCIATES, INC.**  
CONSULTING ENGINEERS • EST. 1988

51 EAST GREGORY STREET PENSACOLA, FLORIDA 32502  
PHONE: 904-934-2061

253 ST. ANTHONY STREET MOBILE, ALABAMA 36603  
PHONE: 251-950-7446

SHEET TITLE: LIGHTING NEW WORK PLAN -  
CAFETERIA-KITCHEN BUILDING

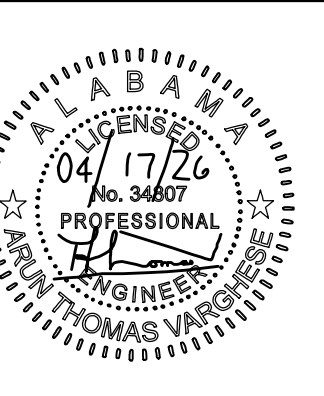


PROJ. MGR.:	A. VARGHESE
DRAWN:	C. PAGE
DATE:	03/25/26
REVISIONS	
#1	04/17/26 DCM COMMENTS

JOB NO. 25-160B

SHEET NO:

**E1.1**



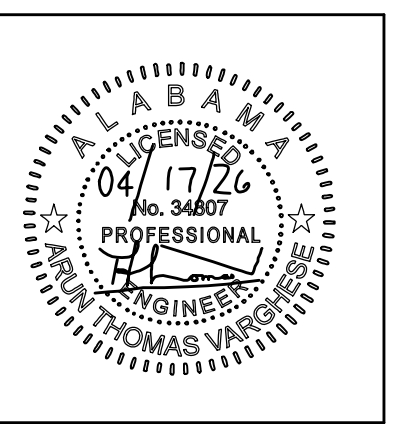


PROJ. MGR.:	A. VARGHESE
DRAWN:	C. PAGE
DATE:	03/25/26
REVISIONS	
#1	04/17/26 DCM COMMENTS

JOB NO. **25-160B**

SHEET NO:

**E1.2**

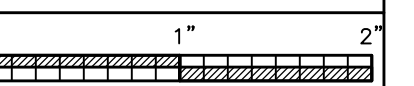

**LIGHTING PLAN KEYNOTES**

- 1 PROVIDE NEW WATTSTOPPER DIM ROOM CONTROLLER, LMR-211 FOR USE WITH MULTI-WAY DIMMING CIRCUIT IN THIS ROOM. COORDINATE CONNECTION REQUIREMENTS WITH MANUFACTURER.
- 2 NEW MULTI-WAY DIMMING SWITCH SHALL BE WATTSTOPPER LMSW-211-W. SWITCHES SHALL BE USED IN JUNCTION WITH NEW DIM ROOM CONTROLLER. COORDINATE CONNECTION REQUIREMENTS WITH MANUFACTURER.
- 3 NEW LIGHTING FIXTURES SHALL TIE INTO EXISTING LIGHTING FIXTURE CIRCUIT L2-6. PROVIDE AND INSTALL ADDITIONAL CONDUIT, WIRING, AND JUNCTION BOXES AS NECESSARY TO ACCOMMODATE NEW LAYOUT.
- 4 NEW LIGHTING FIXTURES SHALL TIE INTO EXISTING LIGHTING FIXTURE CIRCUIT L2-12. PROVIDE AND INSTALL ADDITIONAL CONDUIT, WIRING, AND JUNCTION BOXES AS NECESSARY TO ACCOMMODATE NEW LAYOUT.

**LIGHTING GENERAL NOTES:**

1. UNSWITCHED HOT CONDUCTORS TO LIGHTING FIXTURES ARE NOT SHOWN BUT SHALL BE PROVIDED AS REQUIRED.
- LIGHTING SWITCHES INDICATED IN A ROOM SHALL CONTROL THE LIGHTING IN THAT ROOM.
- LIGHTING SWITCHES WITH SMALL LETTER DESIGNATIONS SHALL BE USED TO LABEL MULTIPLE ZONES WITHIN A ROOM OR SPACE.
- UNSWITCHED HOT CONDUCTORS TO EMERGENCY LIGHTING FIXTURES, INCLUDING EXIT SIGNS, ARE NOT SHOWN BUT SHALL BE PROVIDED AS REQUIRED.



**LIGHTING NEW WORK PLAN -  
MEDIA CENTER**  
SCALE: 1/8" = 1'-0"

**H.M. YONGE & ASSOCIATES, INC.**  
CONSULTING ENGINEERS / EST. 1988


51 EAST GREGORY STREET PENSACOLA, FLORIDA 32502 PHONE: (904)334-3561

253 ST. ANTHONY STREET MOBILE, ALABAMA 36603 PHONE: (251)690-7446



**SITE IMPROVEMENTS AND  
INTERIOR ALTERATIONS TO  
FAIRHOPE HIGH SCHOOL**  
ONE PIRATE DRIVE  
FAIRHOPE, ALABAMA 36539  
BALDWIN COUNTY PUBLIC SCHOOLS

SHEET TITLE: ELECTRICAL OVERALL NEW WORK PLAN



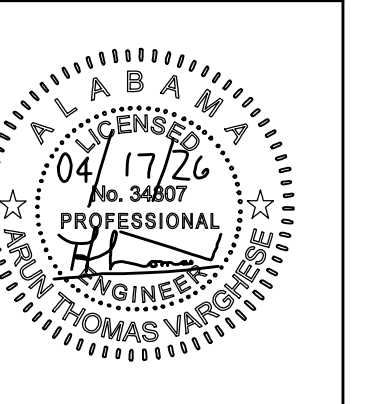


PROJ. MGR.:	A. VARGHESE
DRAWN:	C. PAGE
DATE:	03/25/26
REVISIONS	
#1	04/17/26 DCM COMMENTS

JOB NO. **25-160B**

SHEET NO:

**E2.0**

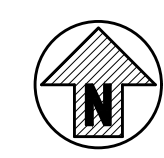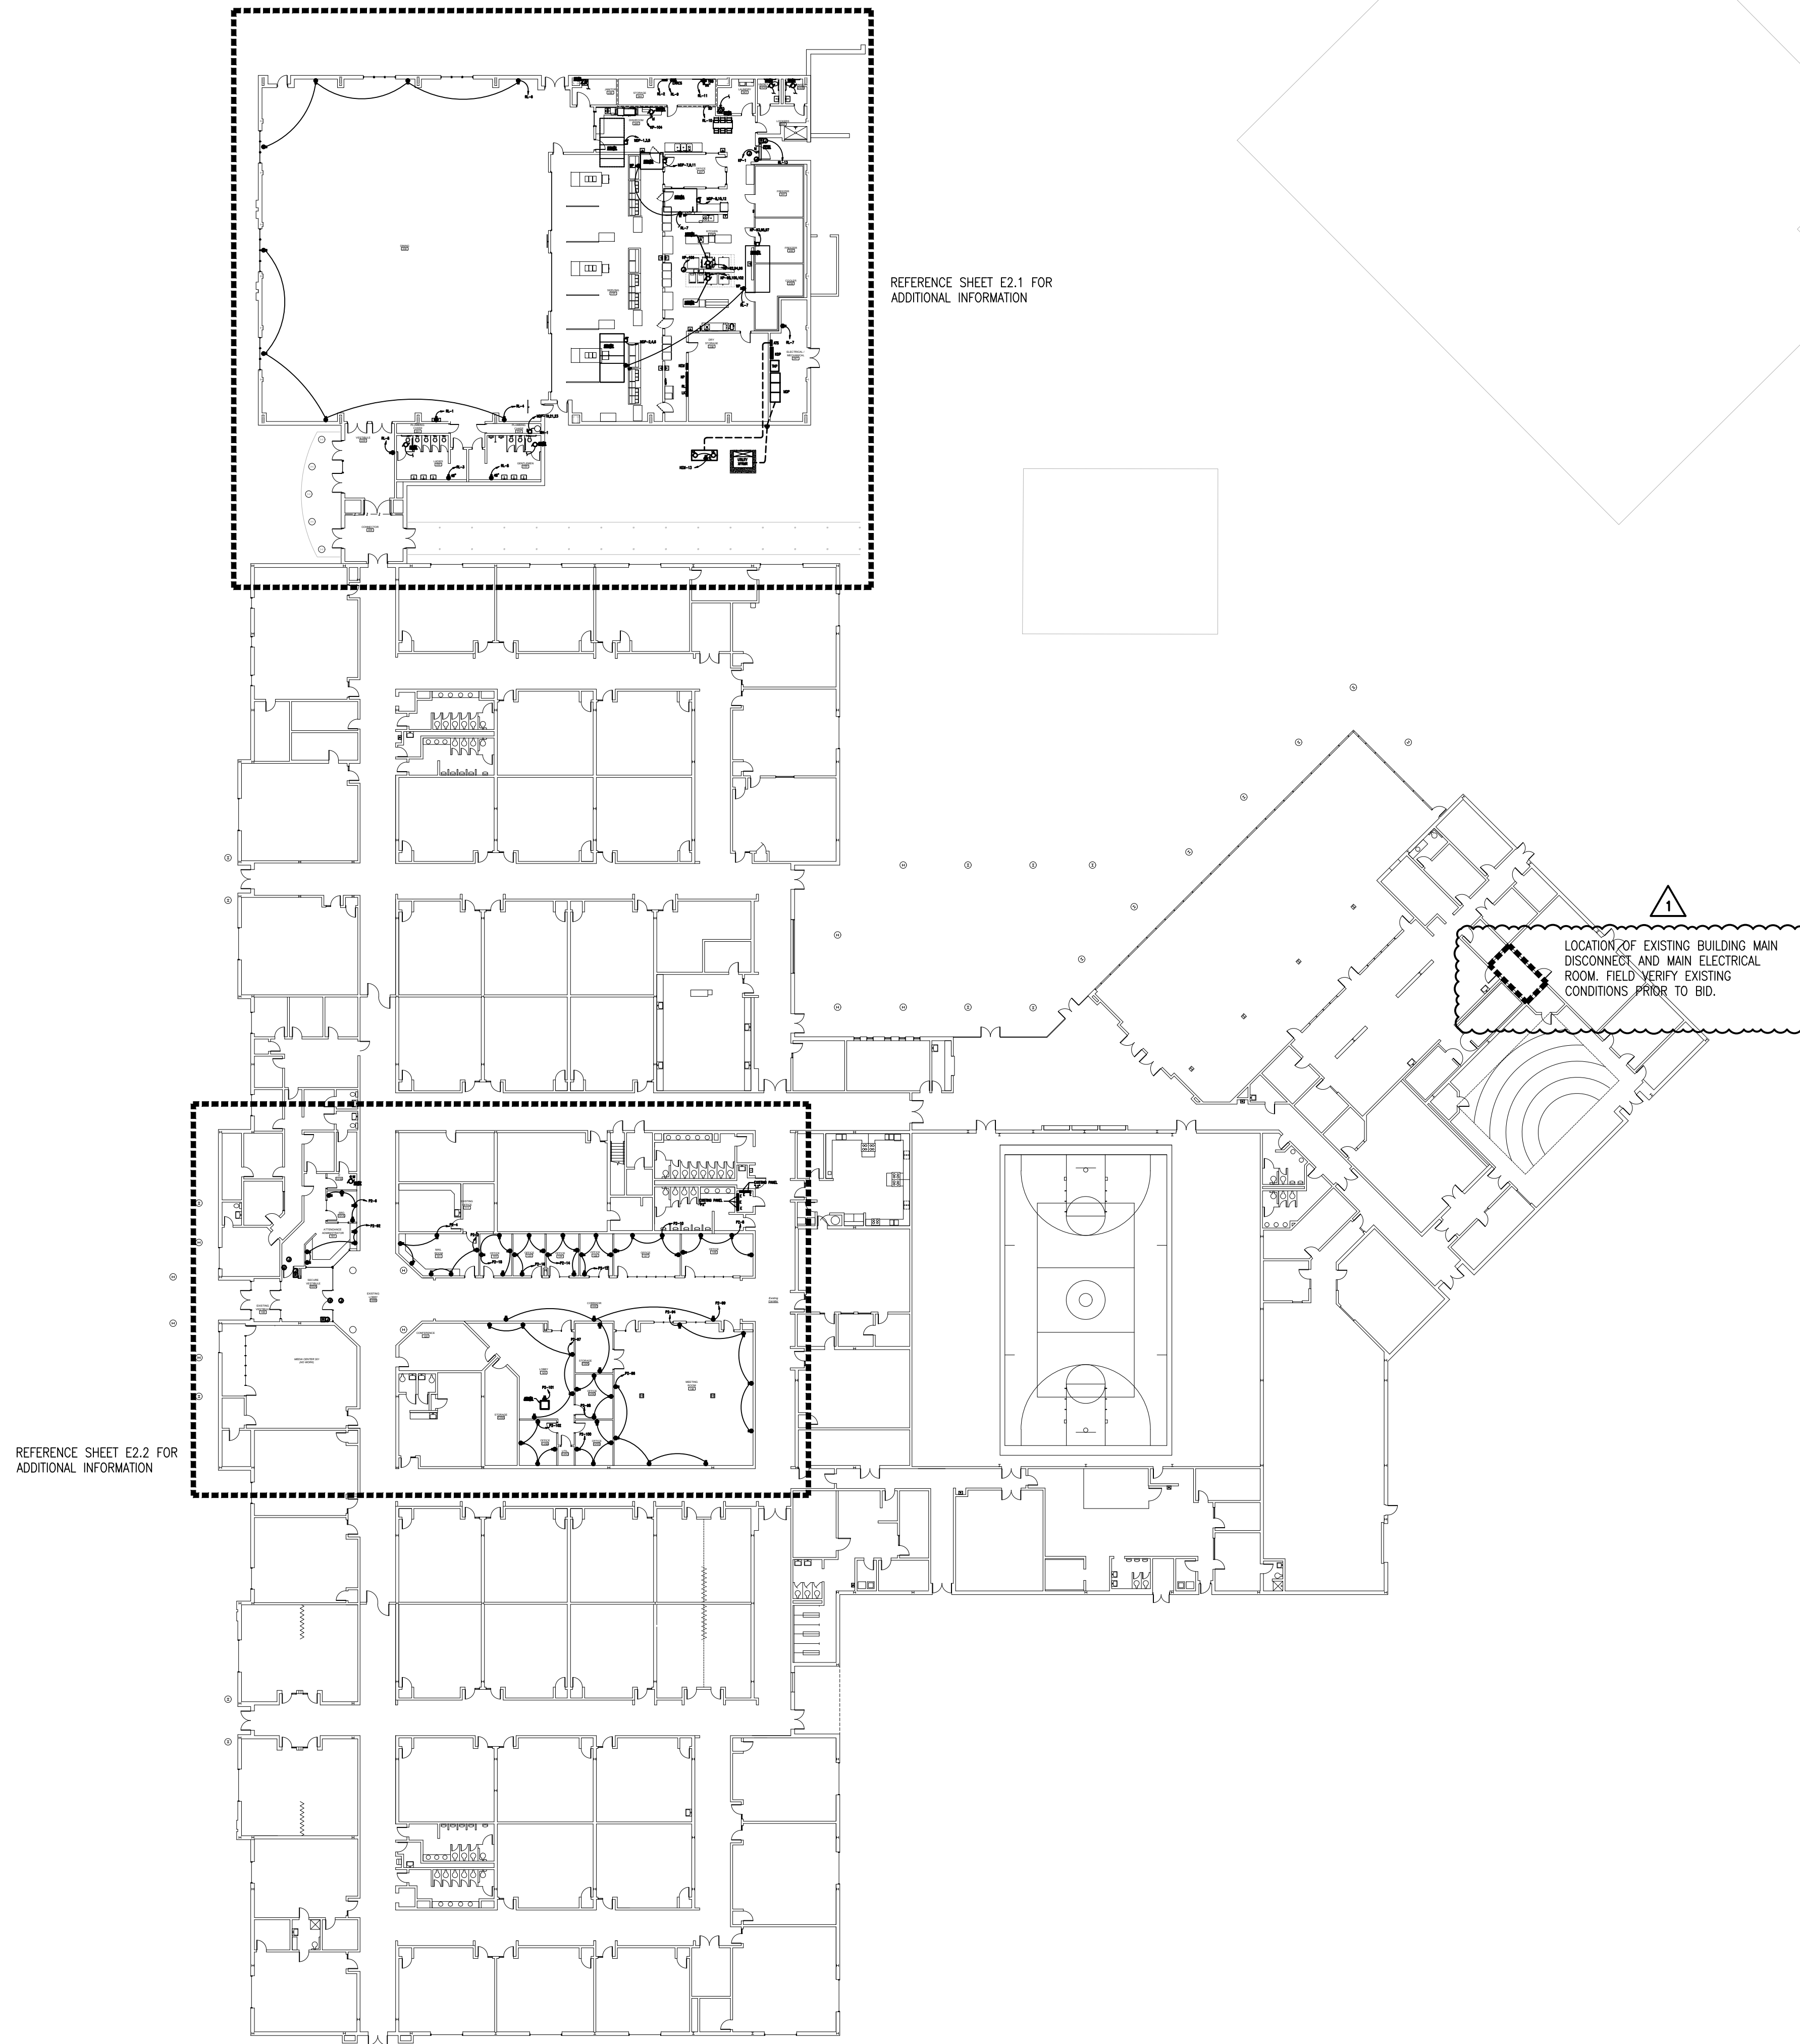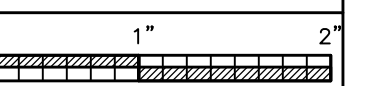

**ELECTRICAL OVERALL NEW WORK PLAN**  
SCALE: 1" = 30'-0"



**H.M. YONGE & ASSOCIATES, INC.**  
CONSULTING ENGINEERS / EST. 1988

51 EAST GREGORY STREET  
PENSACOLA, FLORIDA 32502  
PHONE: (904) 384-3561

253 ST. ANTHONY STREET  
MOBILE, ALABAMA 36603  
PHONE: (251) 690-7446




PROJ. MGR.:	A. VARGHESE
DRAWN:	C. PAGE
DATE:	03/25/26
REVISIONS	
#1	04/17/26 DCM COMMENTS

JOB NO. 25-160B


SHEET NO:

E2.1

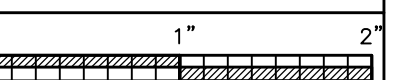


**POWER PLAN KEYNOTES**

- 1 NEW HVAC UNIT AND DISCONNECT LOCATED ON ROOF. SEE EQUIPMENT ELECTRICAL SCHEDULE ON SHEET E0.0 FOR DISCONNECT TYPE AND WIRE SIZE.
- 2 NEW HVAC MAINTENANCE RECEPTACLE LOCATED ON ROOF. ENSURE THAT RECEPTACLES ARE LOCATED WITHIN 25' OF HVAC EQUIPMENT PER NEC.
- 3 EXHAUST FAN POWER SHALL BE INTERLOCKED WITH LOCAL ROOM LIGHTING CIRCUIT. COORDINATE WITH MECHANICAL CONTRACTOR FOR INSTALLATION REQUIREMENTS.
- 4 NEW GENERATOR FOR USE WITH PANEL "KEM". SEE RISER DIAGRAM FOR MORE INFORMATION. COORDINATE INSTALLATION REQUIREMENTS WITH MANUFACTURER. COORDINATE INSTALLATION LOCATION WITH ARCHITECT PRIOR TO ANY ROUGH-IN.
- 5 UNDERGROUND FEEDER ROUTING FOR NEW GENERATOR. SEE RISER DIAGRAM FOR WIRE SIZES. FURNISH AND INSTALL ADDITIONAL CONDUIT, WIRING, AND PULLBOXES AS REQUIRED.
- 6 PROVIDE 3/4" X 4" X 8" PLYWOOD BACKBOARD. PROVIDE 6" CLEARANCE ABOVE FLOOR. ALL POWER AND DATA RECEPTACLES SHALL BE FLUSH WITH BACKBOARD. PROVIDE #6 GROUND IN 3/4" EMT CONDUIT FROM SERVING ELECTRICAL PANEL TO BACKBOARD. COIL 10' SLACK AT BACKBOARD. PROVIDE GROUND BUS BAR (HARGER GBI SERIES) AS REQUIRED BY COMMUNICATIONS CONTRACTOR.
- 7 PROVIDE 3/8" FLEX CONDUIT WITH PULL STRING FROM 4" SQUARE BOX WITH 8" OF FOAM BLOCKING LOCATED IN DOOR FRAME AT CENTER HINGE UP TO ABOVE ACCESSIBLE CEILING. FOR ELECTRIC LOCKING DOOR. COORDINATE WITH SECURITY VENDOR.
- 8 4" SQUARE BOX LOCATED ABOVE DOOR IN ACCESSIBLE CEILING. PROVIDE 3/8" FLEX CONDUIT WITH PULL STRING TO FROM BOX TO CENTER OF 24" FOAM BLOCKING ABOVE DOOR FRAME.
- 9 PROVIDE 3/8" FLEX CONDUIT WITH PULL STRING FROM 4" SQUARE BOX AT 48" AFF TO 4" SQUARE BOX LOCATED ABOVE ACCESSIBLE CEILING, FOR CARD READER. COORDINATE WITH SECURITY VENDOR.
- 10 PROVIDE A 4" JUNCTION BOX FOR USE WITH CARD READER TERMINAL. PROVIDE FIRE ALARM INTERLOCK CONNECTION AS REQUIRED. COORDINATE WITH SECURITY VENDOR AND MANUFACTURER PRIOR TO ANY ROUGH-IN.
- 11 MAINTAIN CLEARANCE AND WORKING SPACE PER THE NATIONAL ELECTRICAL CODE ABOUT ELECTRICAL EQUIPMENT IN THIS SPACE.
- 12 APPROXIMATE LOCATION FOR NEW UTILITY TRANSFORMER. COORDINATE FINAL LOCATION WITH CIVIL ENGINEERING AND WITH UTILITY COMPANY. SEE ELECTRICAL RISER DIAGRAM.
- 13 UNDERGROUND FEEDER ROUTING FOR UTILITY TRANSFORMER SECONDARY. SEE RISER DIAGRAM FOR WIRE SIZES. COORDINATE FINAL ROUTING OF SECONDARY CONDUIT AND WIRING WITH FINAL LOCATION OF TRANSFORMER. FURNISH AND INSTALL ADDITIONAL CONDUIT, WIRING, AND PULLBOXES AS REQUIRED.
- 14 APPROXIMATE LOCATION FOR NEW ELECTRICAL SERVICE METER. COORDINATE FINAL LOCATION WITH THE FINAL LOCATION OF THE UTILITY TRANSFORMER. SEE RISER DIAGRAM FOR MORE INFORMATION.
- 15 POWER CONNECTION FOR NEW SOLENOID VALVE. COORDINATE FINAL LOCATION AND POWER REQUIREMENTS WITH PLUMBING CONTRACTOR PRIOR TO ANY ROUGH-IN.
- 16 NEW FIRE ALARM BOOSTER PANEL.

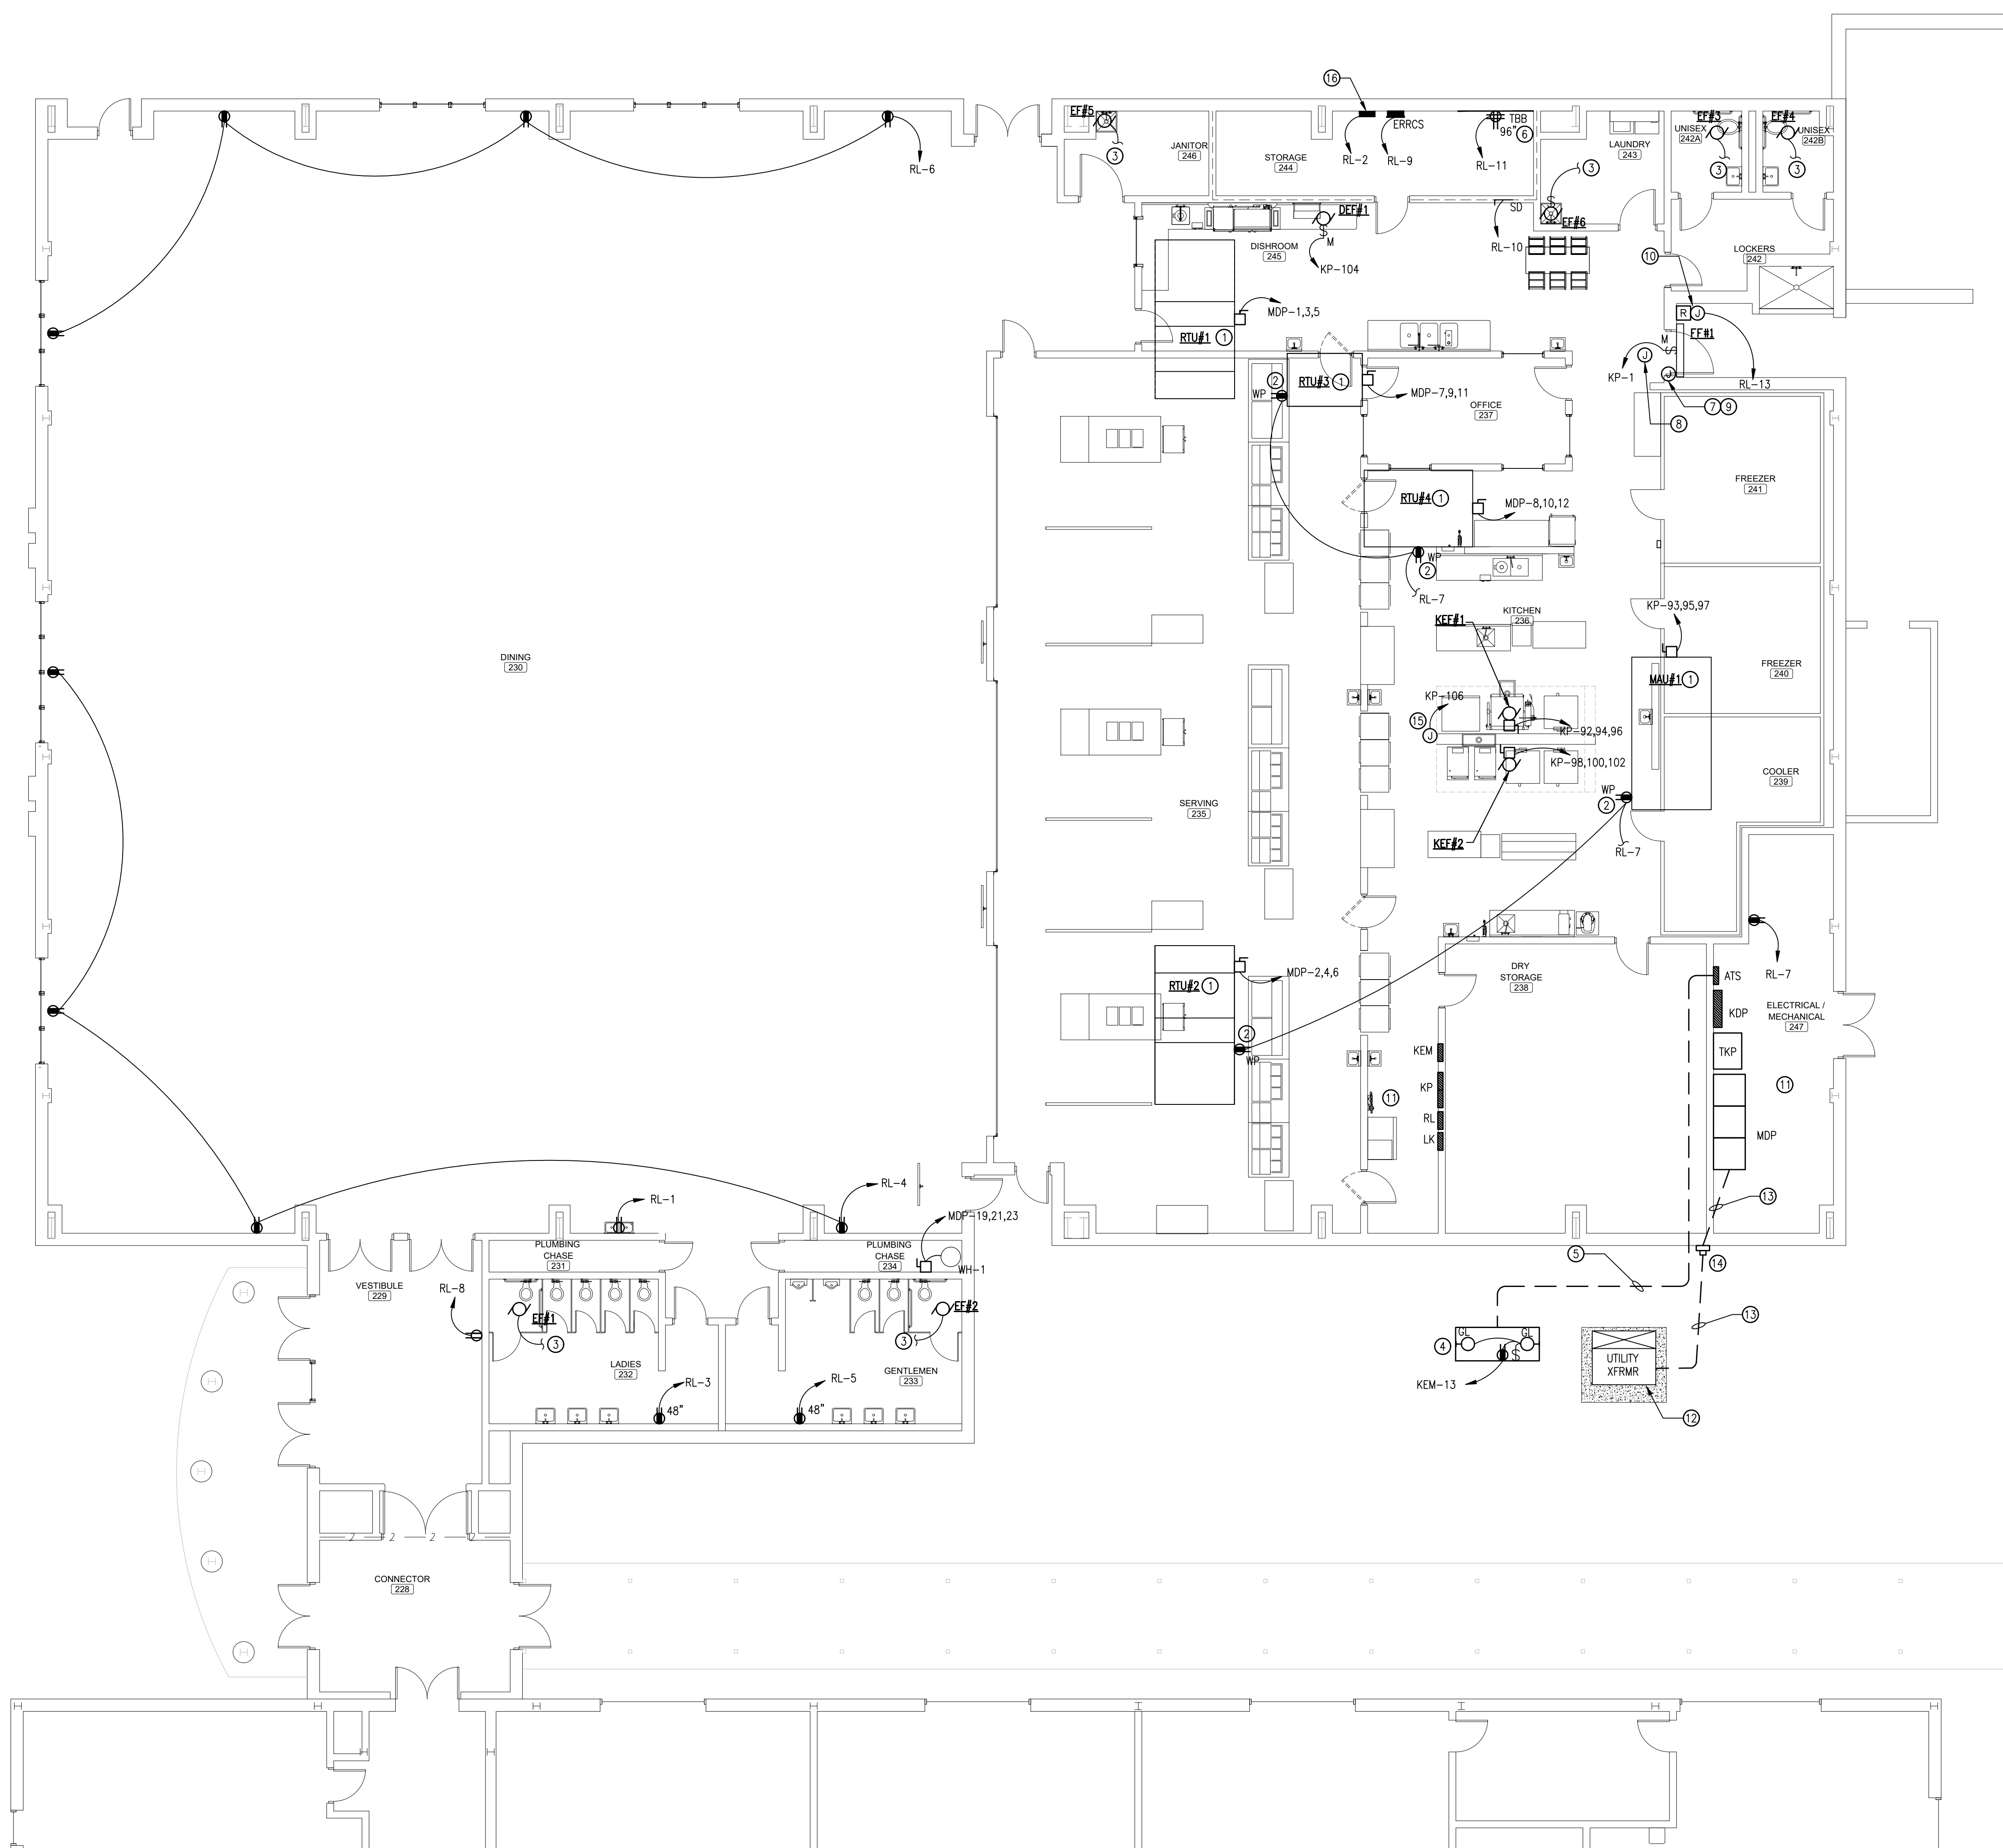

**ELECTRICAL NEW WORK PLAN -  
CAFETERIA-KITCHEN BUILDING**  
SCALE: 1/8" = 1'-0"


**H.M. YONGE & ASSOCIATES, INC.**  
CONSULTING ENGINEERS • EST. 1988  
51 EAST GREGORY STREET PENSACOLA, FLORIDA 32502  
253 ST. ANTHONY STREET MOBILE, ALABAMA 36603  
PHONE: 904.934-3561 PHONE: 251.950-7446

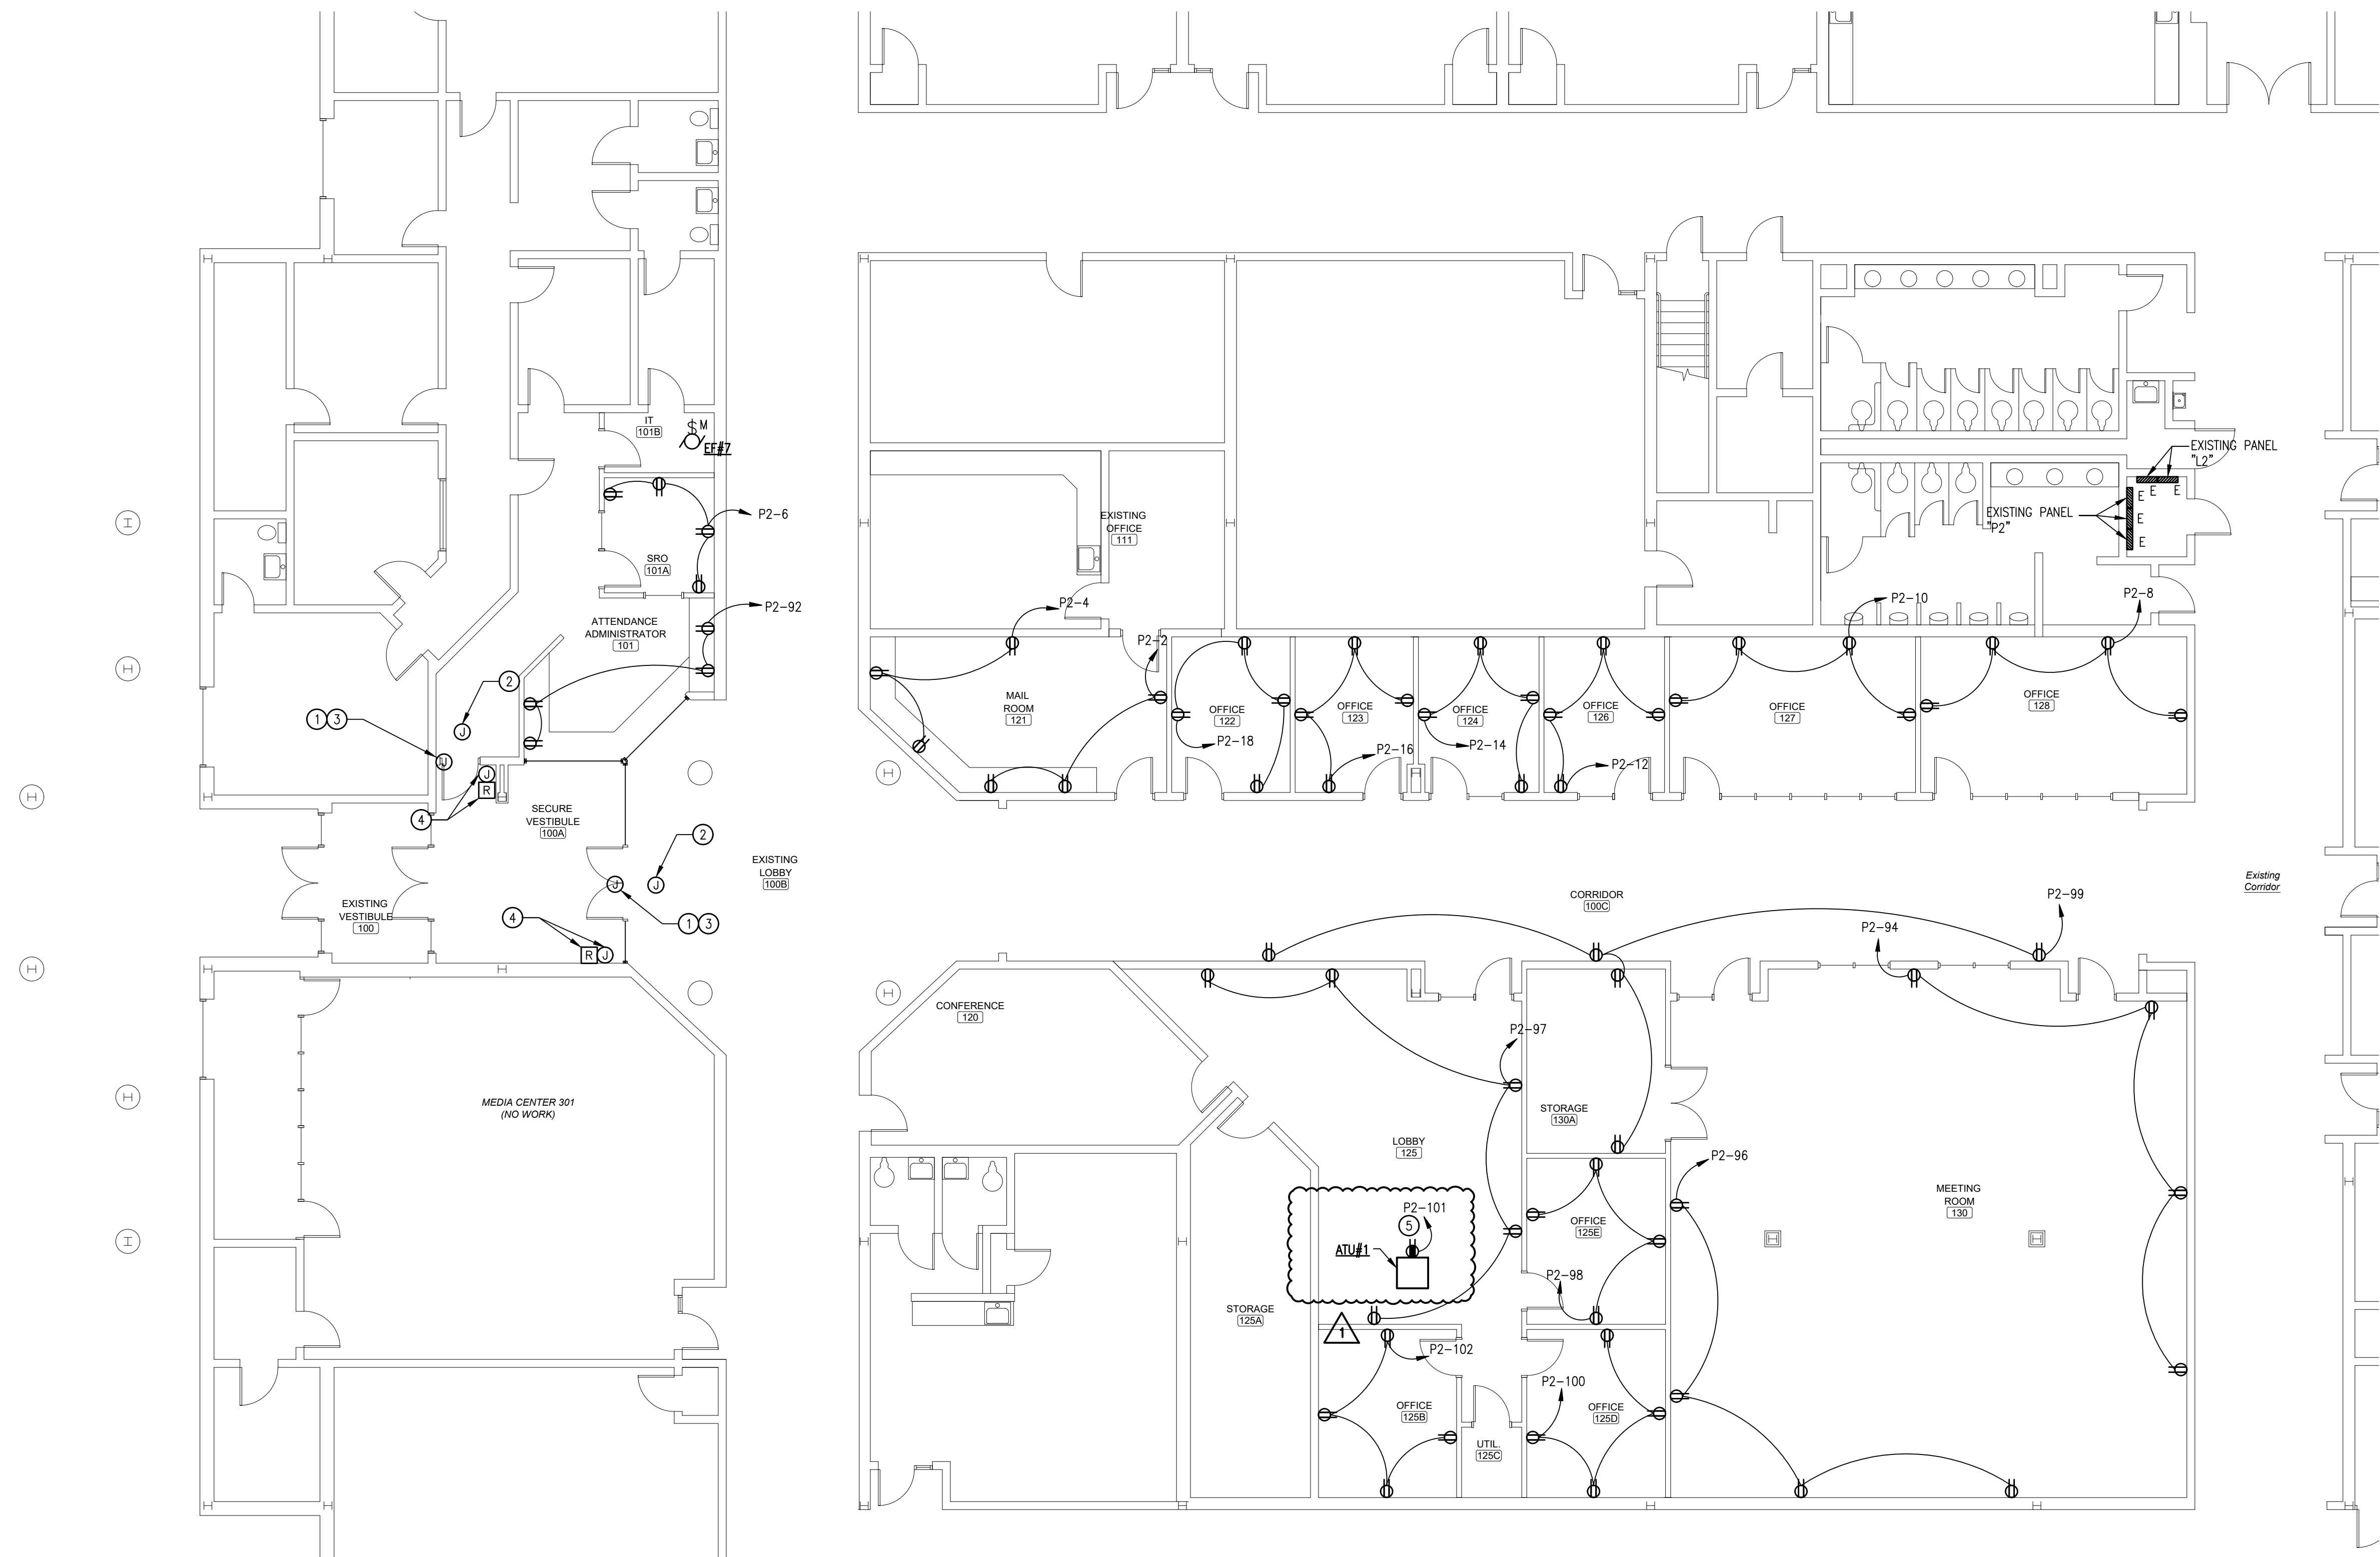


**POWER PLAN KEYNOTES**

- ① PROVIDE 3/8" FLEX CONDUIT WITH PULL STRING FROM 4" SQUARE BOX WITH 8" OF FOAM BLOCKING LOCATED IN DOOR FRAME AT CENTER HINGE UP TO ABOVE ACCESSIBLE CEILING. FOR ELECTRIC LOCKING DOOR. COORDINATE WITH SECURITY VENDOR.
- ② 4" SQUARE BOX LOCATED ABOVE DOOR IN ACCESSIBLE CEILING. PROVIDE 3/8" FLEX CONDUIT WITH PULL STRING TO FROM BOX TO CENTER OF 24" FOAM BLOCKING ABOVE DOOR FRAME.
- ③ PROVIDE 3/8" FLEX CONDUIT WITH PULL STRING FROM 4" SQUARE BOX AT 48" AFF TO 4" SQUARE BOX LOCATED ABOVE ACCESSIBLE CEILING, FOR CARD READER. COORDINATE WITH SECURITY VENDOR.
- ④ PROVIDE A 4" JUNCTION BOX FOR USE WITH CARD READER TERMINAL. PROVIDE FIRE ALARM INTERLOCK CONNECTION AS REQUIRED. COORDINATE WITH SECURITY VENDOR AND MANUFACTURER PRIOR TO ANY BOUGH-IN.
- ⑤ NEW RECEPTACLE MOUNTED ABOVE CEILING SHALL BE FOR USE WITH HVAC MAINTENANCE ONLY PER NEC.

**ELECTRICAL NEW WORK PLAN -  
MEDIA CENTER**  
SCALE: 1/8" = 1'-0"

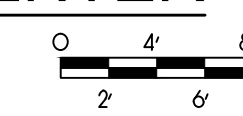

SHEET TITLE: **ELECTRICAL NEW WORK PLAN - MEDIA CENTER AND CLASSROOM ALTERATIONS**

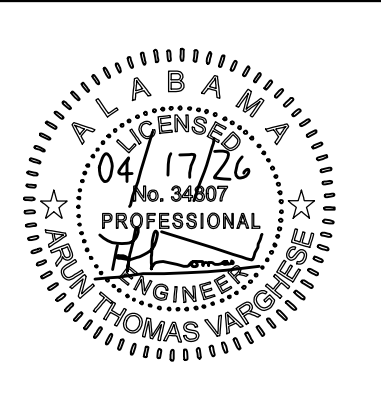

PROJ. MGR.:	A. VARGHESE
DRAWN:	C. PAGE
DATE:	03/25/26
REVISIONS	
#1	04/17/26 DCM COMMENTS

JOB NO. **25-160B**  
SHEET NO:  
**E2.2**

**H.M. YONGE & ASSOCIATES, INC.**  
CONSULTING ENGINEERS • EST. 1988  
51 EAST GREGORY STREET PENSACOLA, FLORIDA 32502 PHONE: (904)334-3561  
253 ST. ANTHONY STREET MOBILE, ALABAMA 36603 PHONE: (251)690-7446





PROJ. MGR.:	A. VARGHESE
DRAWN:	C. PAGE
DATE:	03/25/26
REVISIONS	
#1	04/17/26 DCM COMMENTS

JOB NO. 25-160B

SHEET NO:

**E2.3**

**POWER PLAN KEYNOTES**


- MOTORIZED DOOR CONTROLLER: PROVIDE 3/4" WITH PULL STRING FROM DOOR CONTROLLER TO DOOR OPERATOR. PROVIDE ALL CONNECTION AS REQUIRED. COORDINATE WITH DOOR MANUFACTURER FOR REQUIREMENTS.
- MAINTAIN CLEARANCE AND WORKING SPACE PER THE NATIONAL ELECTRICAL CODE ABOUT ELECTRICAL EQUIPMENT IN THIS SPACE.
- COORDINATE INSTALLATION REQUIREMENTS FOR EQUIPMENT UNDER HOOD WITH FOOD SERVICE DRAWINGS AND KITCHEN EQUIPMENT MANUFACTURER. SEE ALSO PANEL "HP" ON SHEET ES.0 FOR HOME RUN DESIGNATIONS OF CIRCUITS LOCATED UNDER HOOD.
- REMOTE JUNCTION BOX FOR USE WITH SINK HEATER. COORDINATE INSTALLATION REQUIREMENTS WITH FOOD SERVICE DRAWINGS AND KITCHEN EQUIPMENT MANUFACTURER.

**GENERAL NOTES:**

- COORDINATE THE EXACT LOCATIONS OF RECEPTACLES AND DISCONNECTS WITH THE KITCHEN EQUIPMENT SUPPLIER AND OWNER PRIOR TO INSTALLATION. ALL RECEPTACLES AND DISCONNECTS ARE TO BE COORDINATED WITH THE KITCHEN EQUIPMENT.
- PRIOR TO INSTALLATION, MOUNTING HEIGHTS ARE TO BE SUCH THAT THE CORD LENGTH IS MINIMIZED.
- ALL DISCONNECTS IN THE KITCHEN AREA ARE TO BE NEMA-3R TYPE, UNLESS NOTED OTHERWISE.
- THE ELECTRICAL CONTRACTOR IS TO PROVIDE AND INSTALL UNISTRUT, ANGLES AND OTHER HARDWARE AS REQUIRED TO MOUNT OUTLETS IN THE KITCHEN AS SHOWN. THE UNISTRUT SHALL BE USED FOR OTHER SERVICES SUCH AS GAS, WATER, ETC. - COORDINATE WITH THE RESPECTIVE CONTRACTORS AS REQUIRED. THE UNISTRUT IS TO BE STAINLESS STEEL.
- ALL KITCHEN EXHAUST FAN AND SUPPLY FAN DISCONNECTS ARE TO BE PROVIDED WITH A NEMA SIZE 0 COMBISTARTER. AN ADDITIONAL HOOD CONTROL SWITCH IS TO BE PROVIDED AND INSTALL AT THE HOOD SERVED BY THE FAN (COORDINATE THE LOCATION WITH THE HOOD SUPPLIER).
- THE ELECTRICAL CONTRACTOR IS TO COORDINATE THE EXACT RECEPTACLE TYPE AND VOLTAGE FOR ALL EQUIPMENT WITH THE RESPECTIVE EQUIPMENT SUPPLIER (INCLUDING KITCHEN EQUIPMENT) PRIOR TO INSTALLATION.
- LOCATION OF ALL ELECTRICAL ROUGH INS FOR KITCHEN EQUIPMENT SHALL BE COORDINATED WITH FINAL KITCHEN EQUIPMENT LOCATION APPROVED BY OWNER AND ARCHITECT PRIOR TO ROUGH IN. POWER REQUIREMENTS FOR ALL KITCHEN EQUIPMENT SHALL BE COORDINATED PRIOR TO ORDER AND INSTALLATION.
- THE ELECTRICAL CONTRACTOR IS RESPONSIBLE FOR PROVIDING AND INSTALLING ALL CONDUIT, WIRE, BOXES, ETC. REQUIRED TO MAKE THE FREEZER AND COOLER UNITS FULLY FUNCTIONAL. THE ELECTRICAL CONTRACTOR SHALL COORDINATE EXACT POWER REQUIREMENTS FOR THE FREEZER AND COOLER UNITS PRIOR TO ORDER AND INSTALLATION.
- FOR ALL 15A/1 AND 20/1 RECEPTACLES FEEDING KITCHEN EQUIPMENT, PROVIDE GFCI BREAKERS INSTEAD OF GFCI RECEPTACLES WHEN THE RECEPTACLES ARE NOT READILY ACCESSIBLE.
- PROVIDE INTERLOCK CONNECTIONS BETWEEN THE KITCHEN EXHAUST AND SUPPLY FANS AND THE HOOD CONTROLLER PER MANUFACTURER REQUIREMENTS.

**HOOD CONTROL  
SEQUENCE OF  
OPERATION**


	EXHAUST FAN TURNS ON/STAYS ON	SUPPLY FAN TURNS ON	SUPPLY FAN TURNS OFF	SUPPRESSION SYSTEM ACTIVATES	ALARM SIGNAL SENT TO FACP	GAS SUPPLY SHUTS DOWN UNDER HOOD	ALL ELECTRICAL EXCEPT LIGHTING SHUTS DOWN UNDER HOOD
DUCT THERMAL SENSOR ACTIVATES	X	X					
FAN SWITCH ON HOOD	X	X					
SUPPRESSION SYSTEM FUSIBLE LINK OPERATES	X	X	X	X	X	X	X
SUPPRESSION SYSTEM MANUAL PULL OPERATES	X	X	X	X	X	X	X

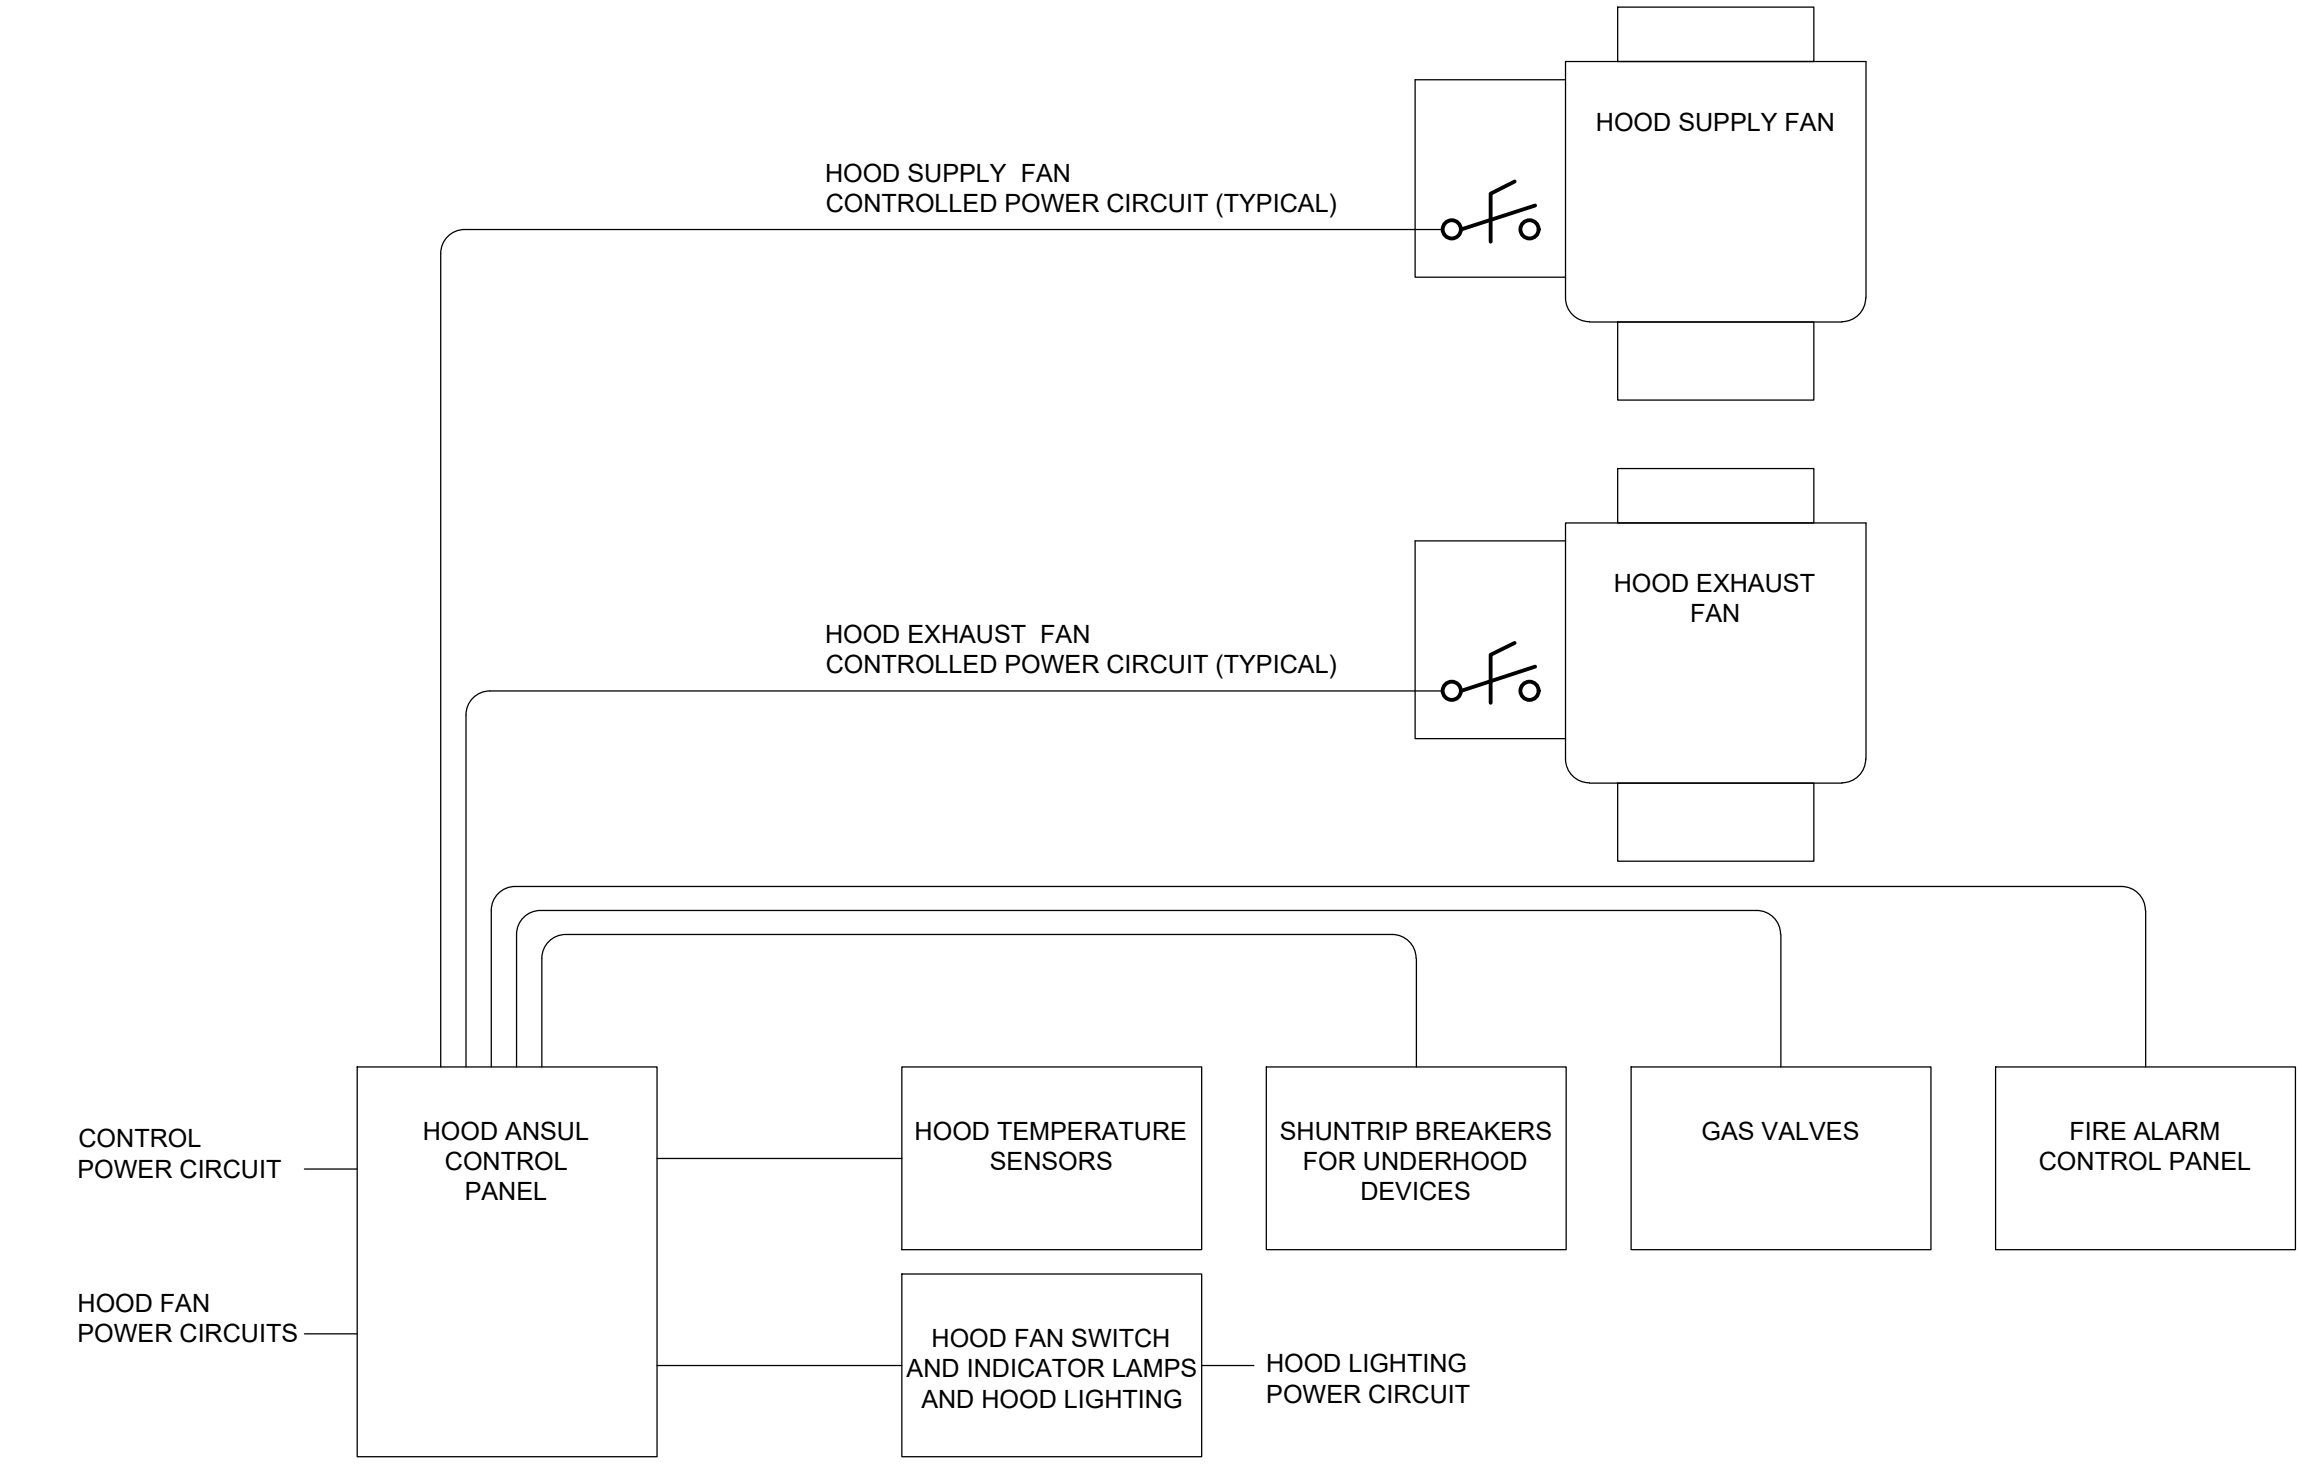

**HOOD CONTROL DIAGRAM**  
NOT TO SCALE

**ELECTRICAL NEW WORK  
PLAN - KITCHEN**


SCALE: 1/4" = 1'-0"

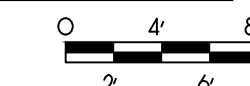


**H.M. YONGE & ASSOCIATES, INC.**  
CONSULTING ENGINEERS • EST. 1988

51 EAST GREGORY STREET  
PENSACOLA, FLORIDA 32502  
PHONE: (904)384-3561

253 ST. ANTHONY STREET  
MOBILE, ALABAMA 36603  
PHONE: (251)950-7446

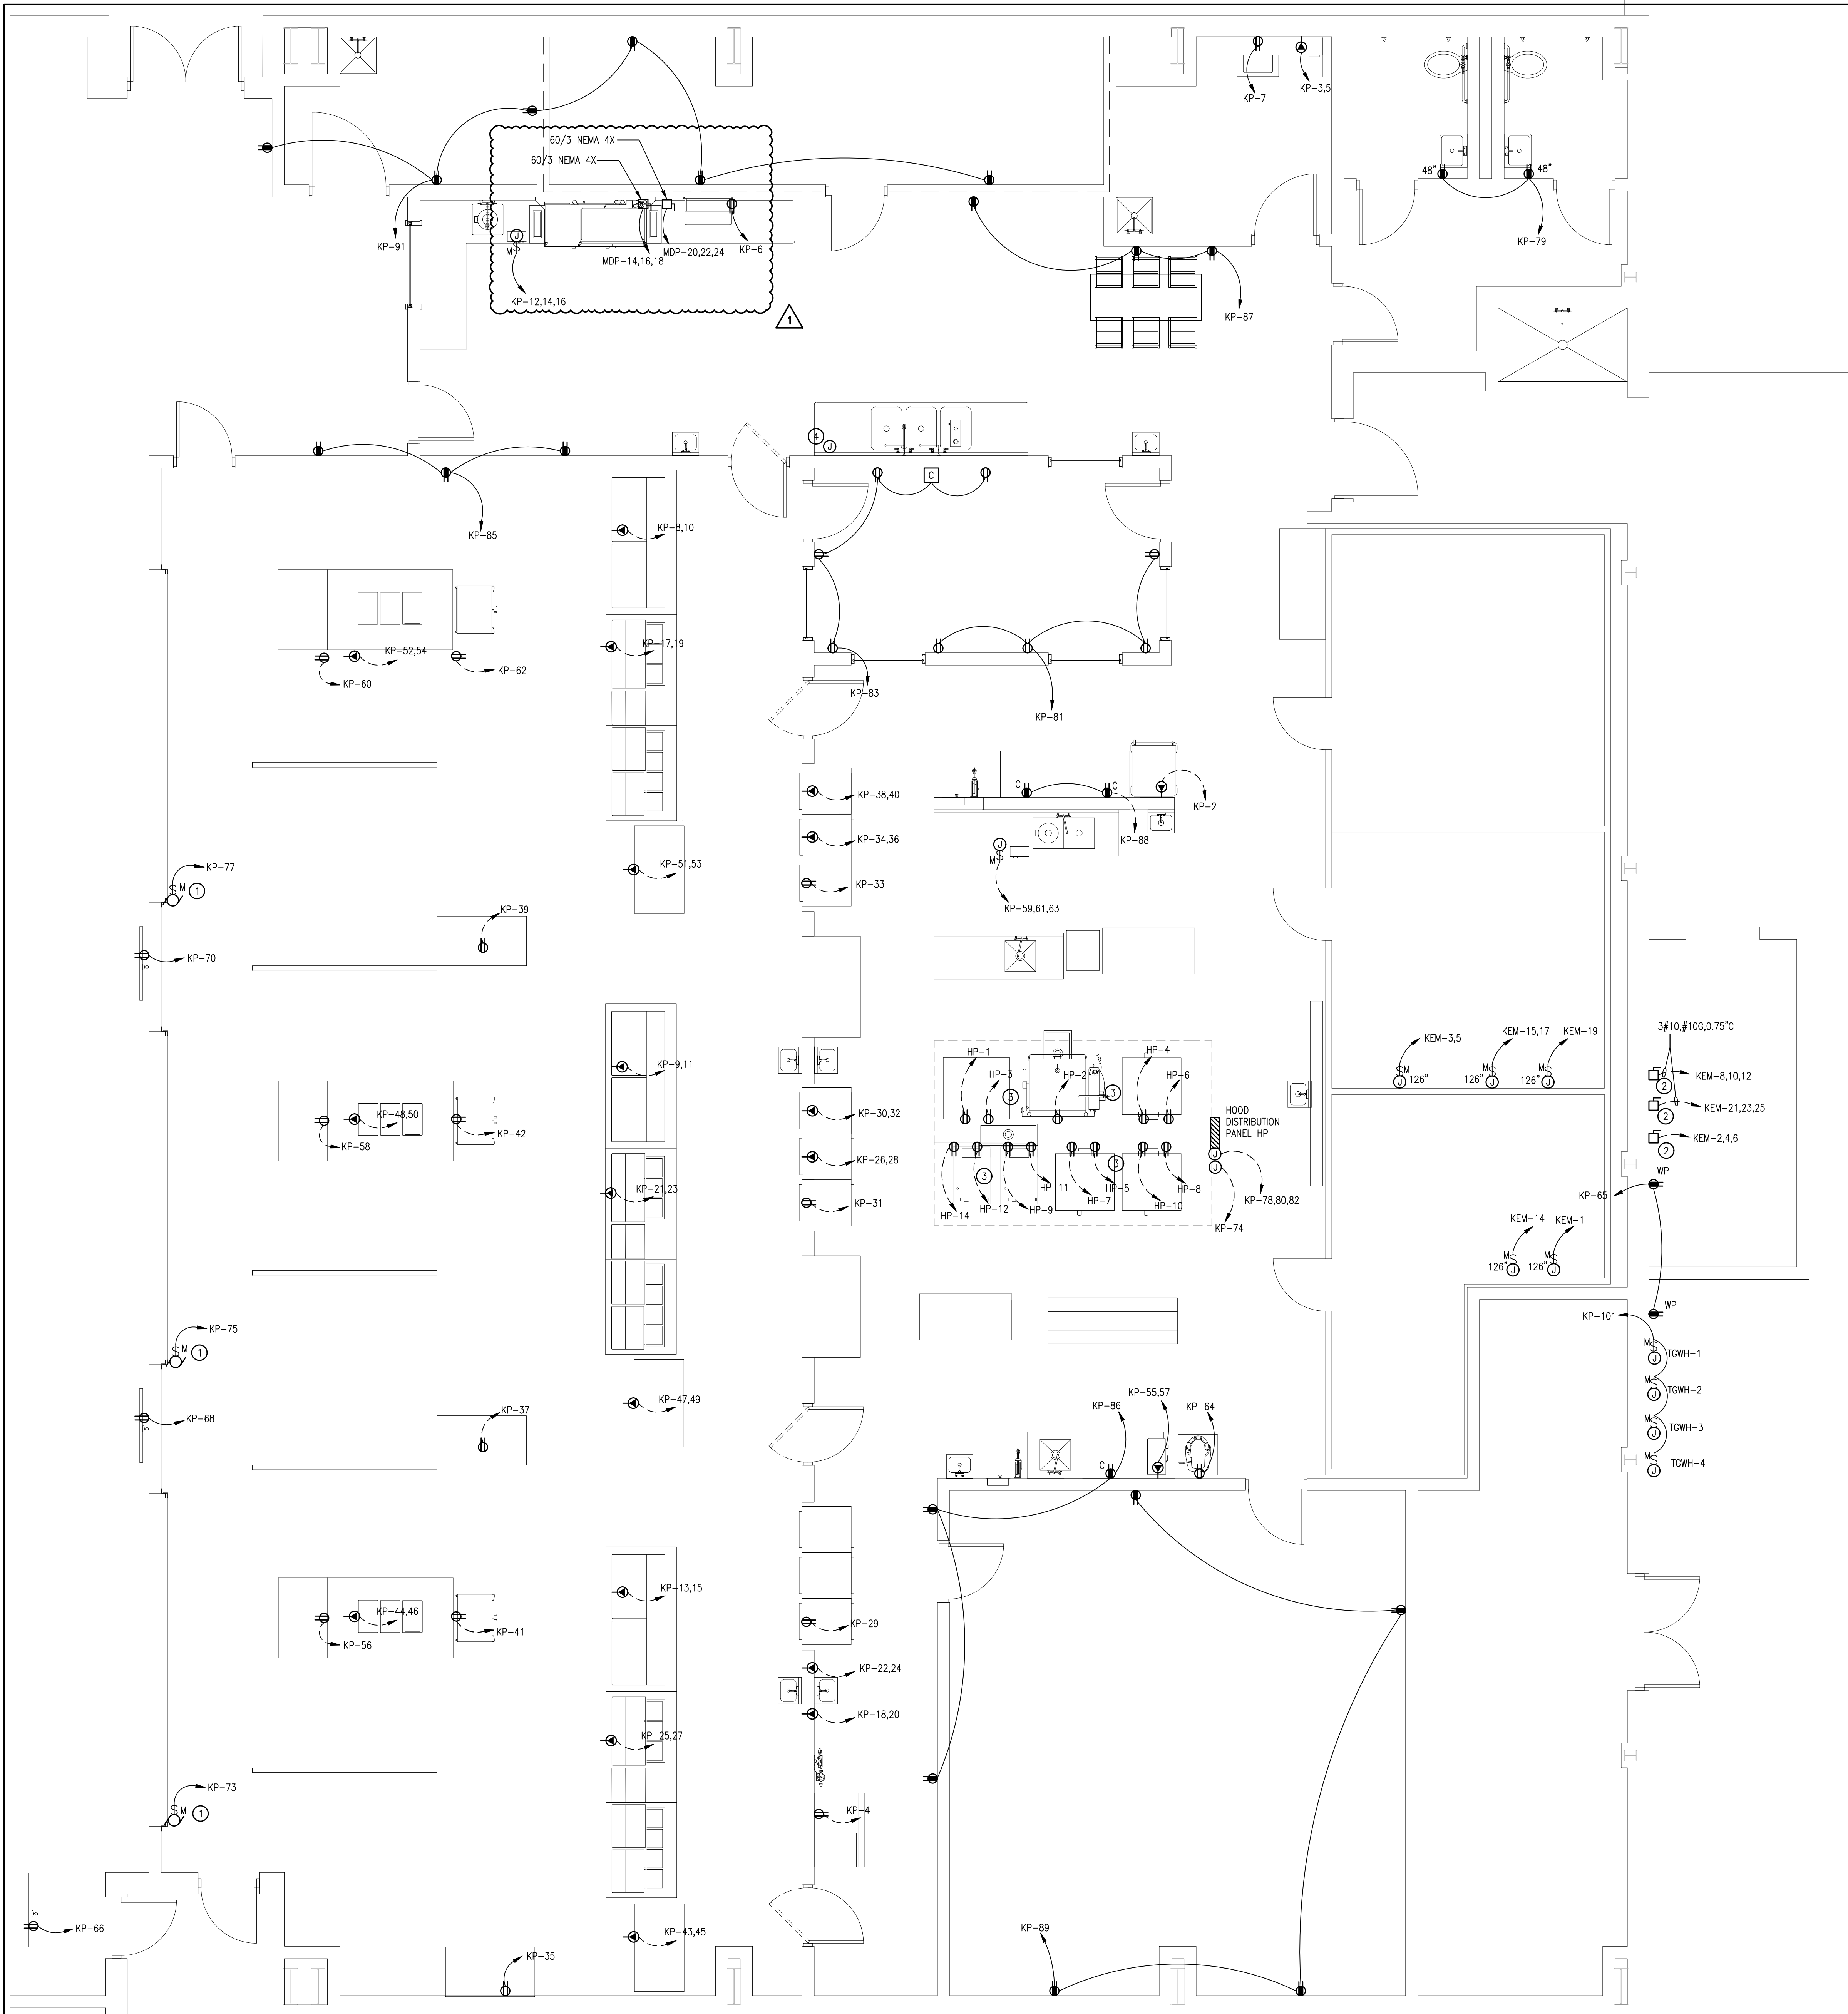

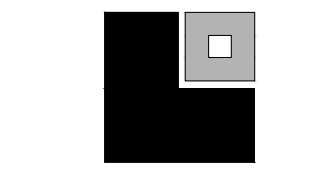


LATHAN  
McKEE  
ARCHITECTS



SITE IMPROVEMENTS AND  
INTERIOR ALTERATIONS TO  
FAIRHOPE HIGH SCHOOL  
ONE PIRATE DRIVE  
FAIRHOPE, ALABAMA 36532  
BALDWIN COUNTY PUBLIC SCHOOLS

SHEET TITLE: SYSTEMS OVERALL NEW WORK PLAN

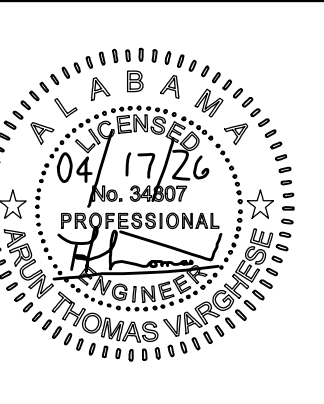

PROJ. MGR.: A. VARGHESE

DRAWN: C. PAGE

DATE: 03/25/26

REVISIONS

#1	04/17/26 DCM COMMENTS
----	-----------------------


COMMENTS

JOB NO. 25-160B

SHEET NO:


E3.0

0 1" 2"

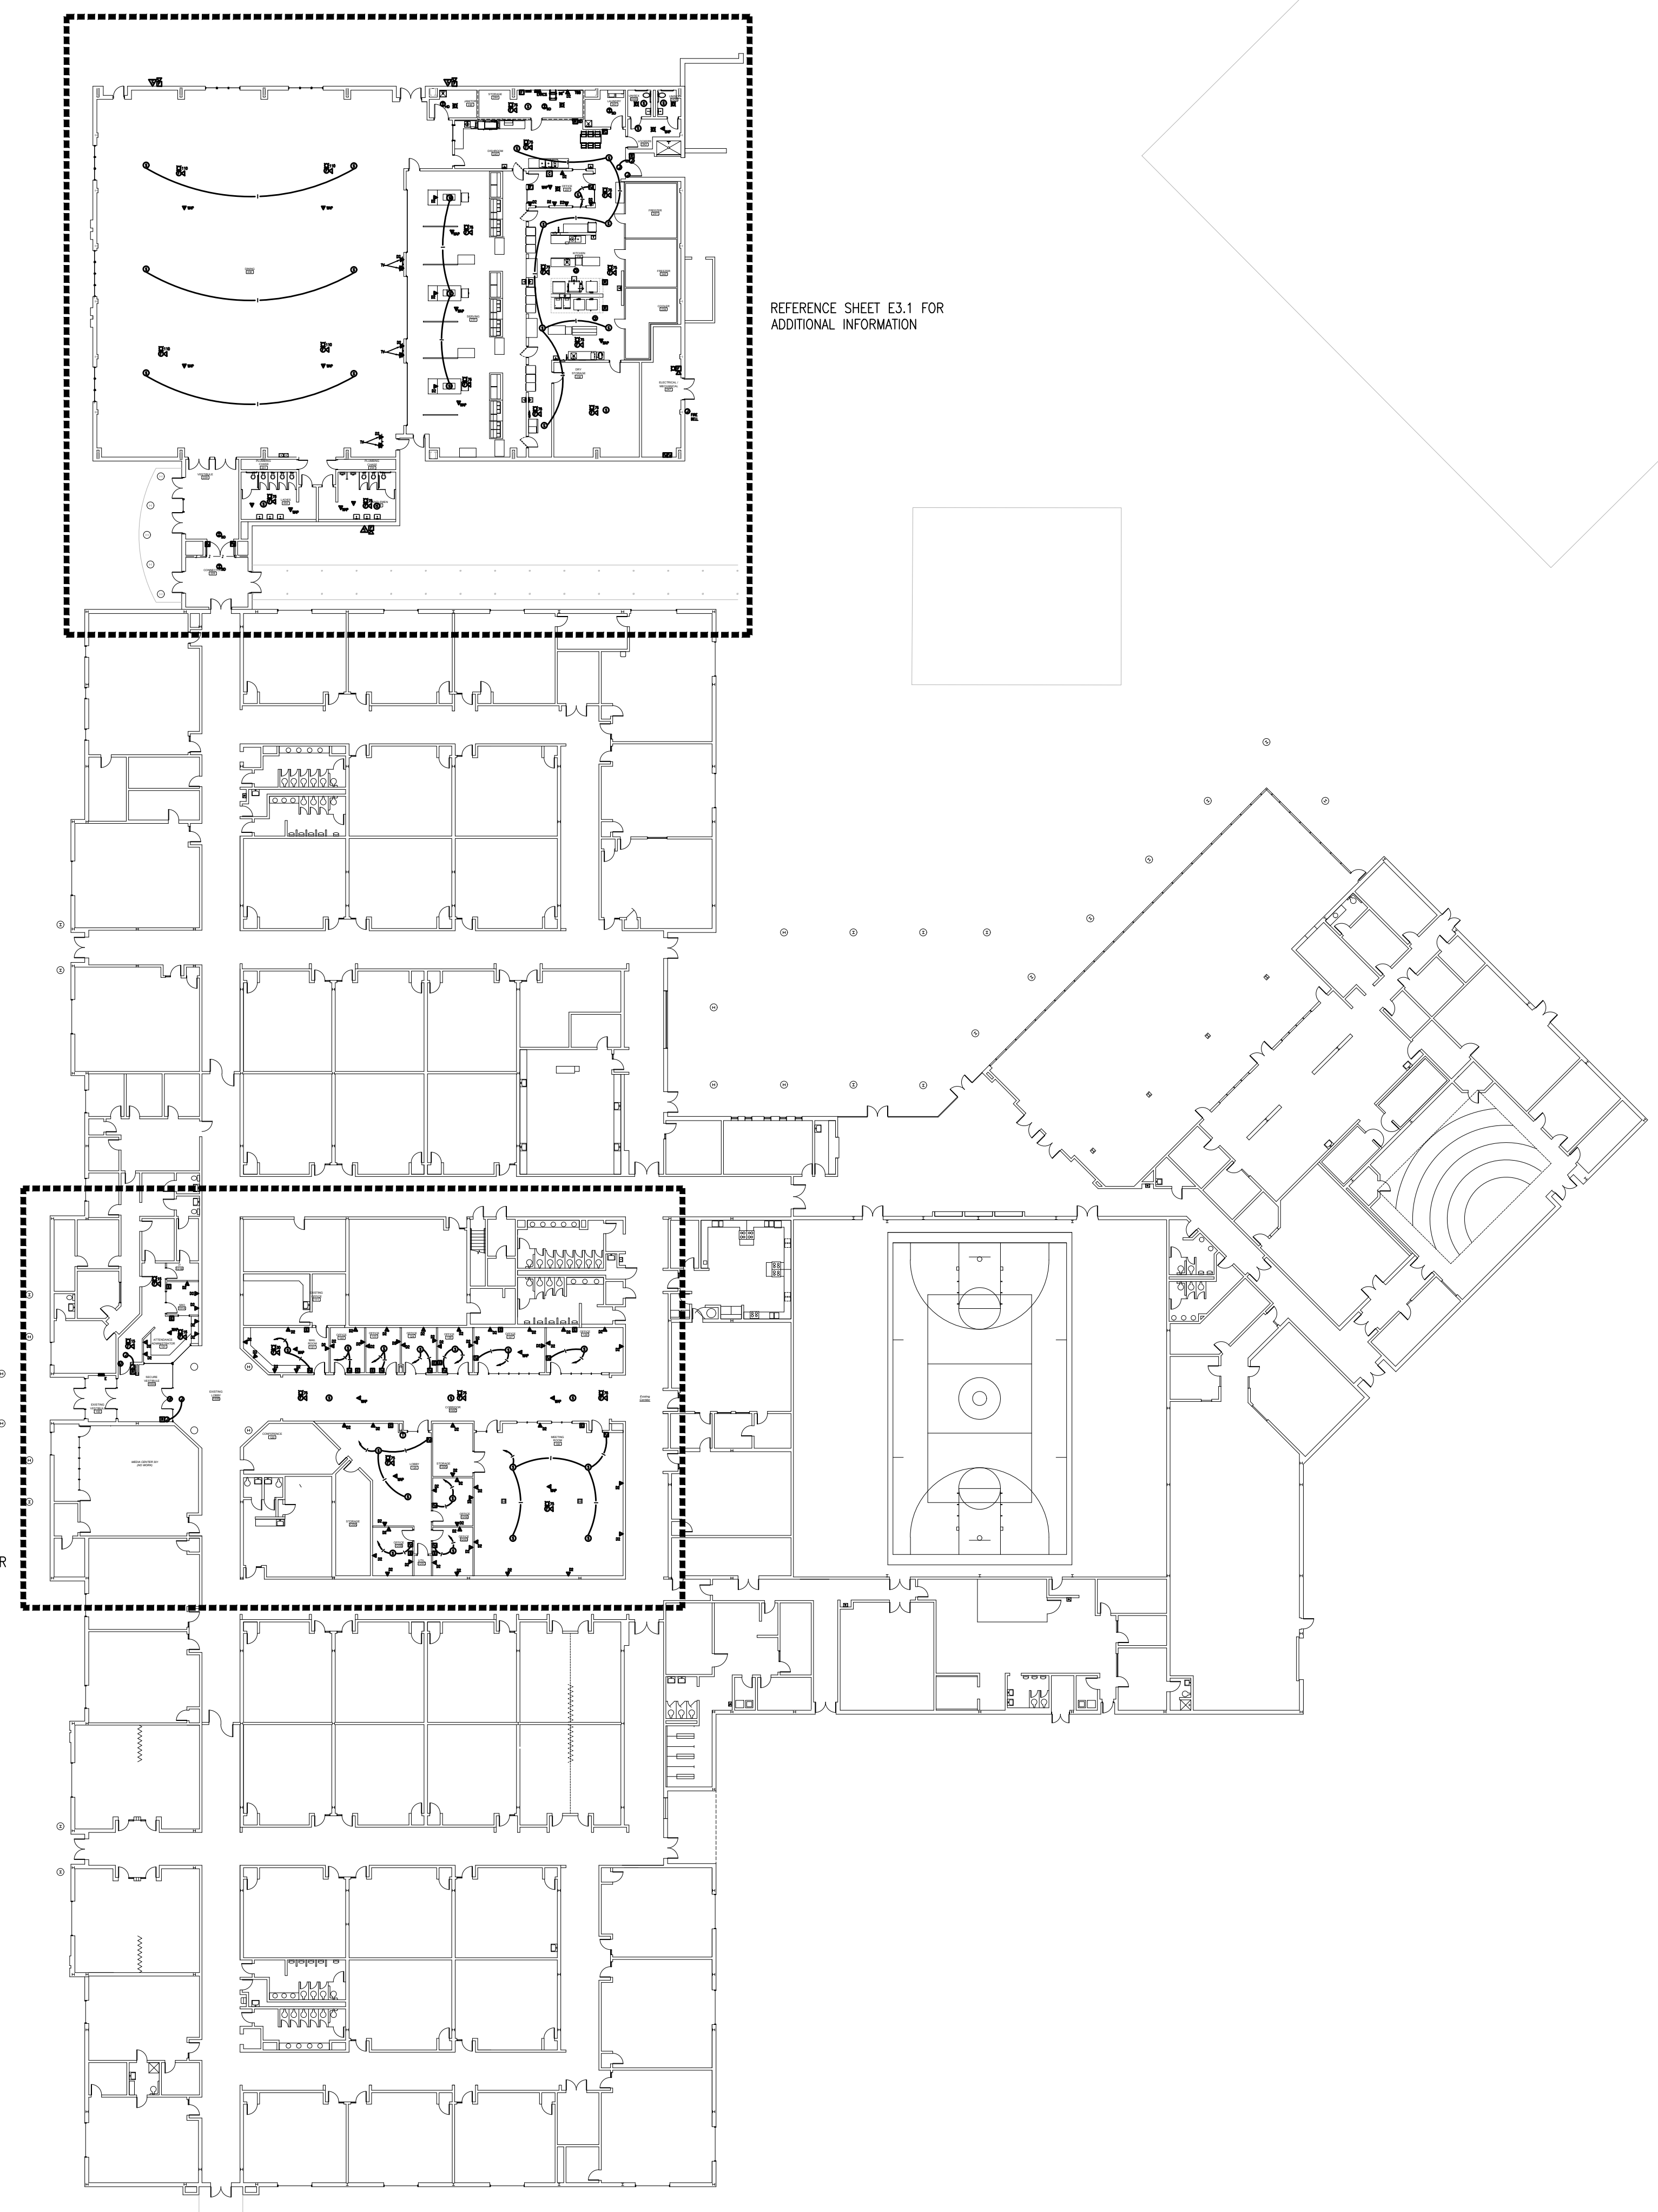

REFERENCE SHEET E3.1 FOR  
ADDITIONAL INFORMATION

REFERENCE SHEET E3.2 FOR  
ADDITIONAL INFORMATION

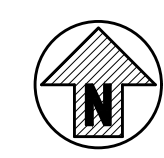

SYSTEMS OVERALL NEW WORK PLAN

SCALE: 1" = 30'-0"



**H.M. YONGE & ASSOCIATES, INC.**  
CONSULTING ENGINEERS / EST. 1988

51 EAST GREGORY STREET PENSACOLA, FLORIDA 32502 PHONE: (904)334-3561  
253 ST. ANTHONY STREET MOBILE, ALABAMA 36603 PHONE: (251)690-7446



PROJ. MGR.:	A. VARGHESE
DRAWN:	C. PAGE
DATE:	03/25/26
REVISIONS	
#1	04/17/26 DCM COMMENTS

JOB NO. 25-160B

SHEET NO:

E3.1

### SYSTEMS PLAN KEYNOTES

- 1 NEW TIME CLOCK. PROVIDE ANY DATA OR POWER CONNECTIONS AS REQUIRED FOR INSTALLATION INCLUDING CONDUIT, WIRING, AND JUNCTION BOXES.
- 2 EMERGENCY RESPONDER RADIO COVERAGE SYSTEM (ERRCS) HEAD END EQUIPMENT. PROVIDE ALL DEDICATED 120V POWER CONNECTIONS AS REQUIRED BY EQUIPMENT VENDOR. ALL WORK ASSOCIATED WITH THE ERRCS SHALL BE CLEARLY MARKED AND PROVIDED AS A SEPARATE LINE ITEM PRICE IN THE BID PACKAGE. REFERENCE 01011 CONTINGENCY ALLOWANCE. IF AFTER LOCAL EMERGENCY AGENCIES HAVE TESTED THE BUILDING AND DETERMINED THAT AN ERRCS IS NOT REQUIRED, THE CONTRACTOR SHALL ISSUE A CREDIT TO THE OWNER FOR ALL WORK ASSOCIATED WITH THE ERRCS.
- 3 FLOW AND TAMPER SWITCHES FOR SPRINKLER SYSTEM AND BACKFLOW PREVENTER. COORDINATE EXACT LOCATION WITH ARCHITECT.
- 4 INTERCOM SYSTEM HOMERUN. ROUTE 3/4" FROM INTERCOM DEVICE TO INTERCOM SYSTEM PATCH PANEL IN CLOSEST TELECOM ROOM. SEE INTERCOM SYSTEM RISER DIAGRAM FOR ADDITIONAL REQUIREMENTS.
- 5 PROVIDE 3/4" X 4" X 8" PLYWOOD BACKBOARD. PROVIDE 6" CLEARANCE ABOVE FLOOR. ALL POWER AND DATA RECEPTACLES SHALL BE FLUSH WITH BACKBOARD. PROVIDE #6 GROUND IN 3/4" EMT CONDUIT FROM SERVING ELECTRICAL PANEL TO BACKBOARD. COIL 10' SLACK AT BACKBOARD. PROVIDE GROUNDING BUS BAR (HARGER GB SERIES) AS REQUIRED BY COMMUNICATIONS CONTRACTOR.
- 6 CABLE TRAY CHATSWORTH #10250-724 OR APPROVED EQUAL WITH SUPPORT HARDWARE AND OTHER ACCESSORIES AS RECOMMENDED BY THE MANUFACTURER. PROVIDE CABLE TRAY WALL ANGLE SUPPORT KIT AS REQUIRED.
- 7 FULL HEIGHT FLOOR MOUNT EQUIPMENT RACK WITH EQUIPMENT MOUNTING HARDWARE AS REQUIRED. REFER TO RACK ELEVATION DETAIL. CONTRACTOR SHALL PROVIDE ALL EQUIPMENT INCLUDING BUT NOT LIMITED TO SWITCHES, ROUTERS, FIBER DRAWERS, PATCH PANELS, JACKS, CORDS, ETC. AS REQUIRED TO INTERFACE WITH EXISTING DATA SYSTEM. INSTALLER SHALL HAVE RACK ON STAFF. SEE SITE PLAN FOR INCOMING FIBER CONNECTION REQUIREMENTS.
- 8 PROVIDE 3/8" FLEX CONDUIT WITH PULL STRING FROM 4" SQUARE BOX WITH 8" OF FOAM BLOCKING LOCATED IN DOOR FRAME AT CENTER HINGE UP TO ABOVE ACCESSIBLE CEILING. FOR ELECTRIC LOCKING DOOR. COORDINATE WITH SECURITY VENDOR.
- 9 PROVIDE 3/8" FLEX CONDUIT WITH PULL STRING FROM 4" SQUARE BOX AT 48" AFF TO 4" SQUARE BOX LOCATED ABOVE ACCESSIBLE CEILING. FOR VIDEO CAMERA INTERCOM DEVICE. COORDINATE WITH SECURITY VENDOR.
- 10 4" SQUARE BOX LOCATED ABOVE DOOR IN ACCESSIBLE CEILING. PROVIDE 3/8" FLEX CONDUIT WITH PULL STRING TO FROM BOX TO CENTER OF 24" FOAM BLOCKING ABOVE DOOR FRAME.
- 11 DATA DROP FOR OWNER FURNISHED OWNER INSTALLED OFOI VAPE DETECTOR DEVICE. DATA CABLE SHALL BE COILED ABOVE CEILING IN THE CENTER OF THE ROOM WITH MINIMUM 10' OF SLACK.
- 12 NEW FIRE ALARM BOOSTER PANEL.

### AUXILIARY GENERAL NOTES:



- a. COORDINATE WITH THE MECHANICAL CONTRACTOR, THE EXACT LOCATION OF THE AIR HANDLER/ROOF TOP UNIT SHUTDOWNS (AT THE CONTROL PANEL OR AT THE UNIT).
- b. VERIFY EXACT NUMBER AND LOCATION OF DUCT DETECTORS FROM MECHANICAL PLAN, NCI RISER DIAGRAM.
- c. VERIFY EXACT NUMBER AND LOCATION OF TAMPER AND FLOW SWITCHES FROM PLUMBING PLANS, NCI RISER DIAGRAM.
- d. VERIFY LOCATION AND MOUNTING HEIGHT OF ALL DEVICES WITH FURNITURE PLAN AND OWNER PRIOR TO ROUGH IN (SPECIFICALLY AT THE FURNITURE IN THE CLASSROOMS).

FOR INTERCOM SPEAKERS NOT INDICATED WITH SPEAKER WIRING: CONTRACTOR SHALL PROVIDE INTERCOM WIRING BETWEEN SPEAKERS. MAXIMUM FOUR SPEAKERS PER INTERCOM CIRCUIT. INTERCOM CIRCUIT HOMERUN SHALL BE RUN BACK TO CLOSEST TELECOM ROOM. CONTRACTOR SHALL TERMINATE WIRING AT INTERCOM EQUIPMENT LOCATED IN COMM ROOM. ALL INTERCOM EQUIPMENT SHALL BE NETWORKED BACK TO THE INTERCOM MASTER CONSOLE LOCATED IN MAIN COMM ROOM M302. INTERCOM SYSTEM REQUIREMENTS SHALL BE COORDINATED WITH THE SPECIFICATIONS AND INTERCOM SYSTEM INSTALLER.

CONTRACTOR SHALL COORDINATE WITH THE ARCHITECTURAL REFLECTED CEILING PLAN FOR ALL CEILING MOUNTED FIRE ALARM INTERCOM, AND DATA DEVICE LOCATIONS, PRIOR TO ANY ROUGH-IN.


PROVIDE TESTING FOR A NEW ERRCS SYSTEM.

PROVIDE AN ALLOWANCE OF \$150,000.00 FOR A NEW ERRCS SYSTEM.

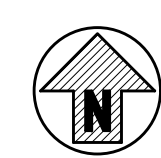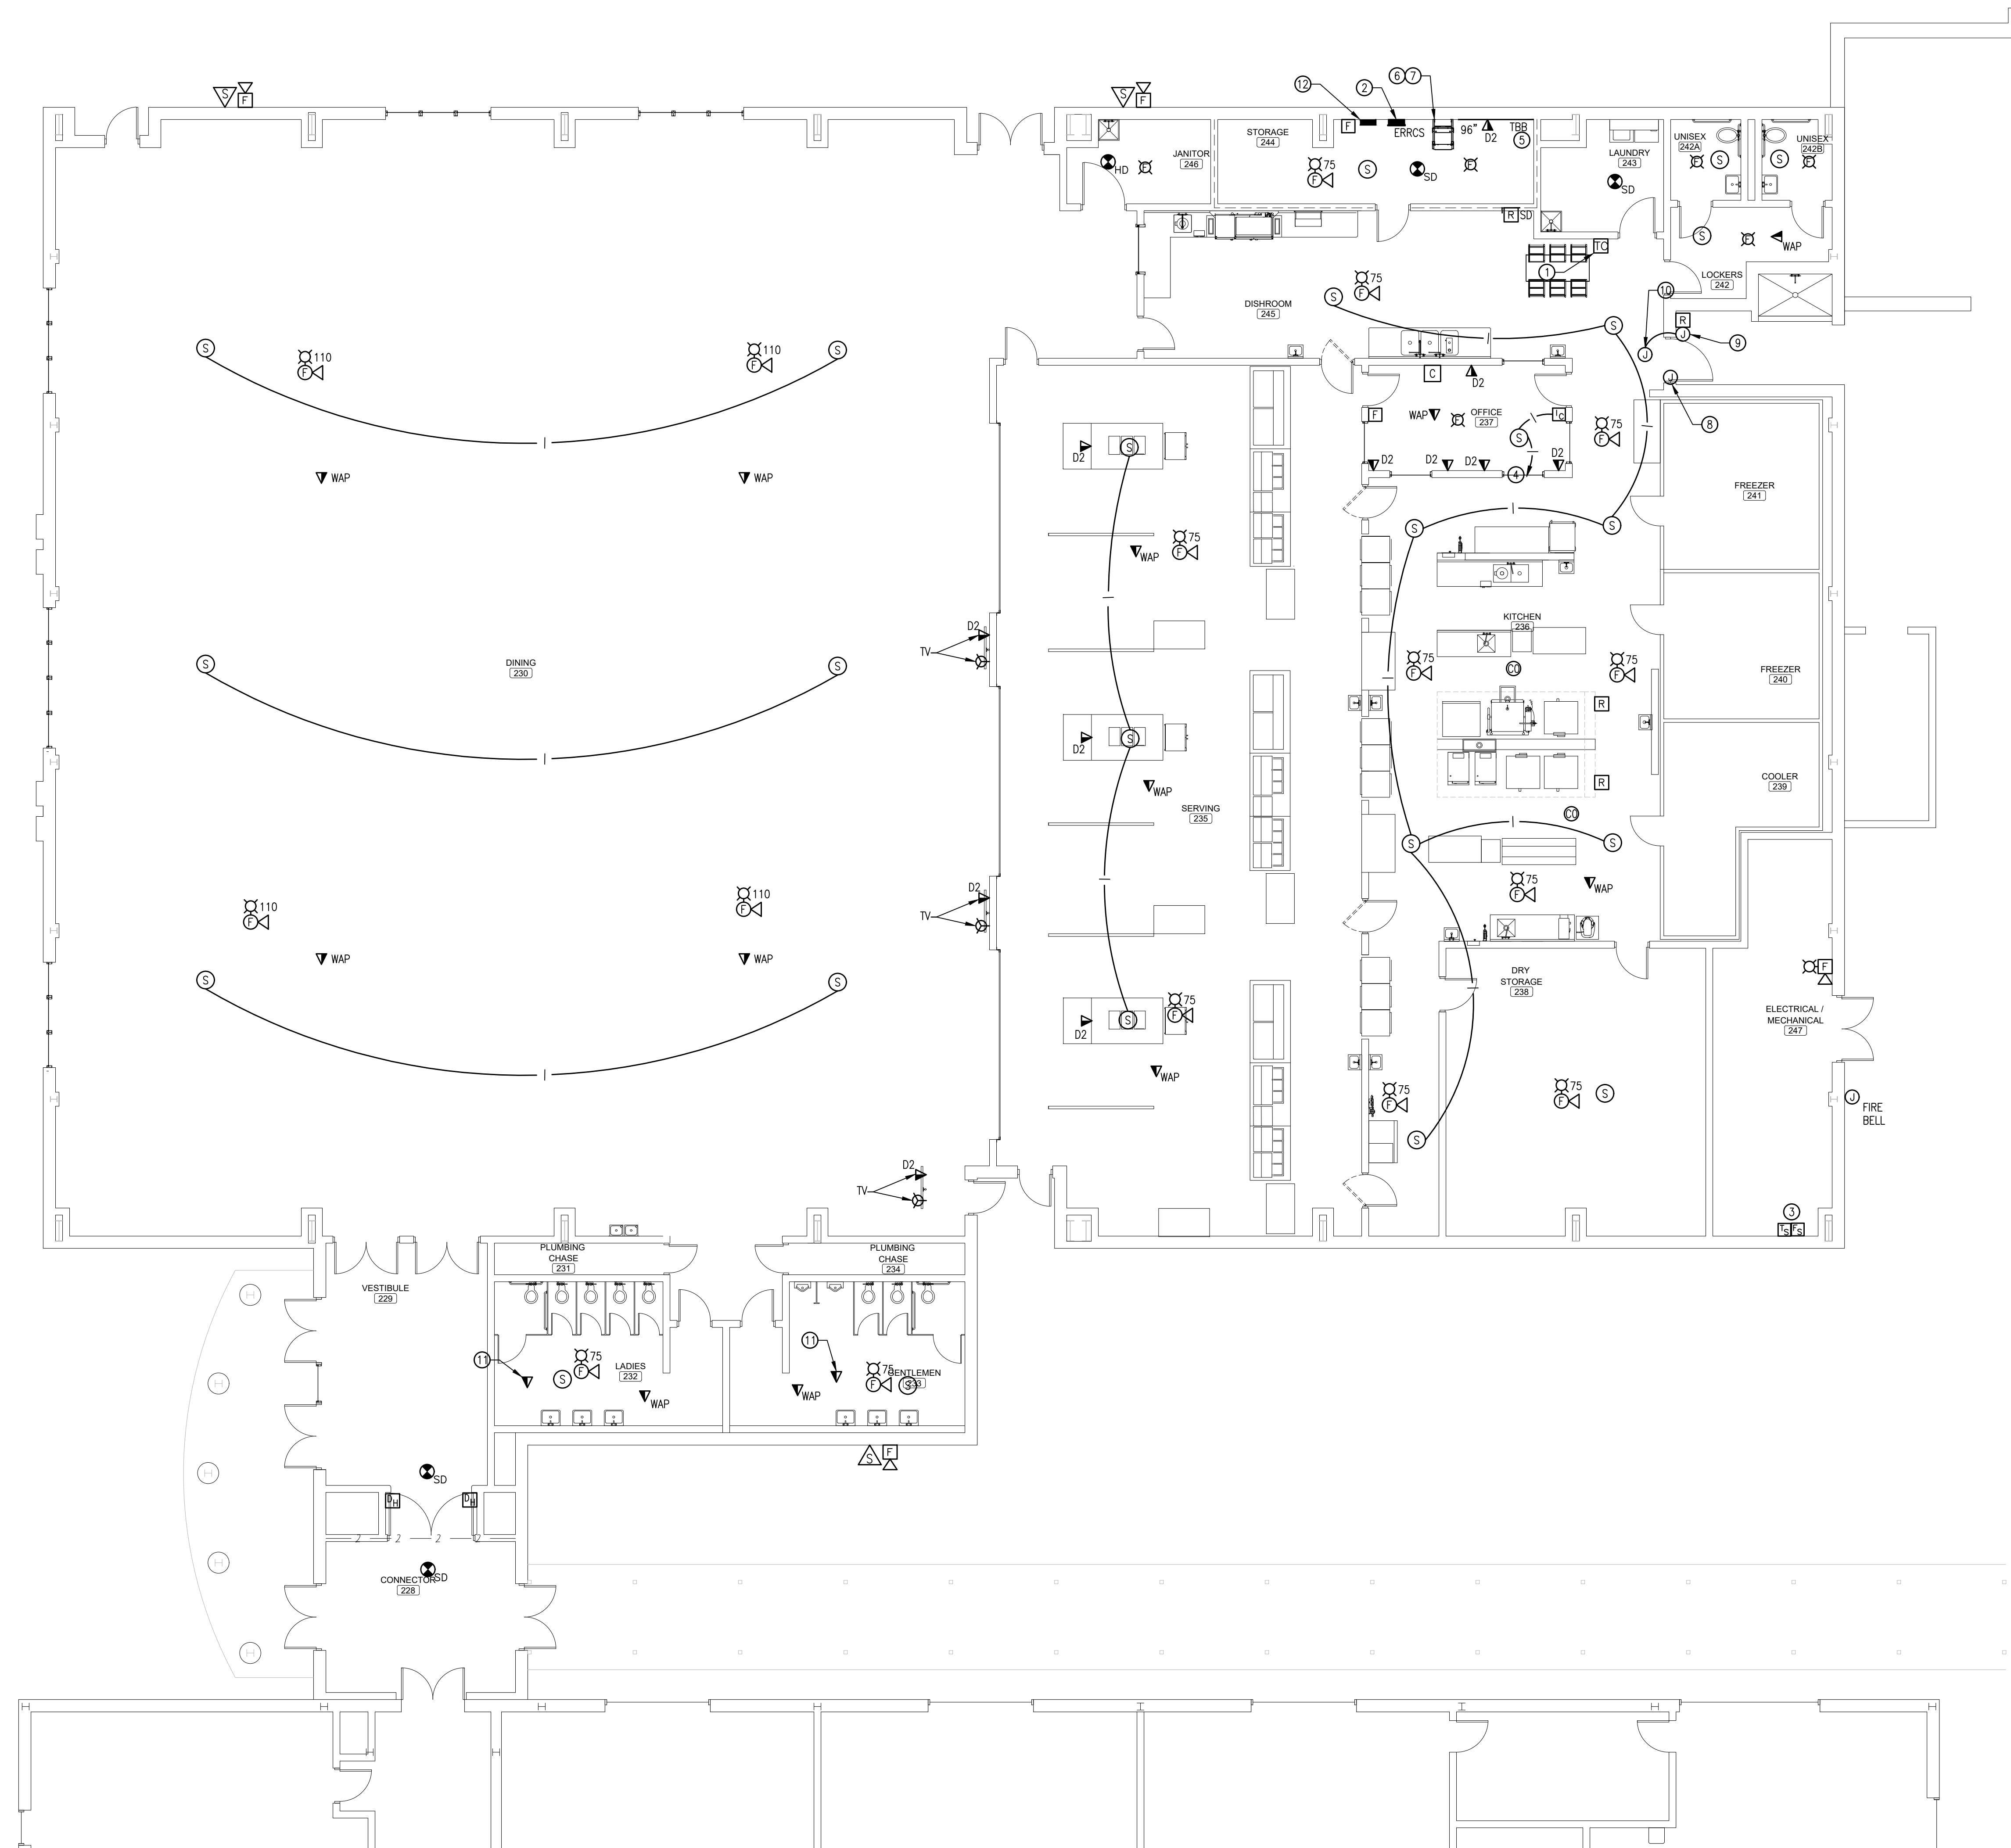


### SYSTEMS NEW WORK PLAN - CAFETERIA-KITCHEN BUILDING

SCALE: 1/8" = 1'-0"

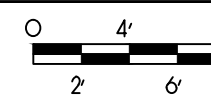

H.M. YONGE & ASSOCIATES, INC.  
CONSULTING ENGINEERS / EST. 1988  
51 EAST GREGORY STREET PENSACOLA, FLORIDA 32502  
253 ST. ANTHONY STREET MOBILE, ALABAMA 36603  
PHONE: 904-934-2061 PHONE: 251-950-7446

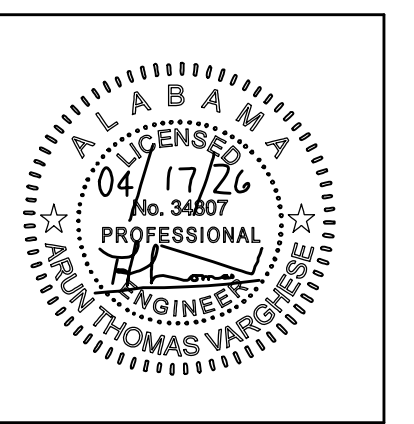


PROJ. MGR.:	A. VARGHESE
DRAWN:	C. PAGE
DATE:	03/25/26
REVISIONS	
#1	04/17/26 DCM COMMENTS

JOB NO. **25-160B**


SHEET NO:

**E3.2**

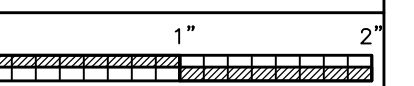

**SYSTEMS PLAN KEYNOTES**

- ① APPROXIMATE LOCATION OF EXISTING INTERCOM MASTER EQUIPMENT. FIELD VERIFY EXACT LOCATION FOR INTERCOM TIE-INS.
- ② INTERCOM SYSTEM HOMERUN. ROUTE 3/4" FROM INTERCOM DEVICE TO INTERCOM SYSTEM PATCH PANEL IN CLOSEST TELECOM ROOM. SEE INTERCOM SYSTEM RISER DIAGRAM FOR ADDITIONAL REQUIREMENTS.
- ③ PROVIDE 3/8" FLEX CONDUIT WITH PULL STRING FROM 4" SQUARE BOX WITH 8" OF FOAM BLOCKING LOCATED IN DOOR FRAME AT CENTER HINGE UP TO ABOVE ACCESSIBLE CEILING. FOR ELECTRIC LOCKING DOOR. COORDINATE WITH SECURITY VENDOR.
- ④ PROVIDE 3/8" FLEX CONDUIT WITH PULL STRING FROM 4" SQUARE BOX AT 48" AFF TO 4" SQUARE BOX LOCATED ABOVE ACCESSIBLE CEILING. FOR VIDEO CAMERA INTERCOM DEVICE. COORDINATE WITH SECURITY VENDOR.
- ⑤ 4" SQUARE BOX LOCATED ABOVE DOOR IN ACCESSIBLE CEILING. PROVIDE 3/8" FLEX CONDUIT WITH PULL STRING TO FROM BOX TO CENTER OF 24" FOAM BLOCKING ABOVE DOOR FRAME.
- ⑥ NEW LOCATION FOR EXISTING HVAC TEMPERATURE CONTROLLER. PROVIDE ANY NEW CONDUIT AND WIRING AS REQUIRED FOR RELOCATION. COORDINATE FINAL LOCATION WITH MECHANICAL CONTRACTOR PRIOR TO ANY ROUGH-IN.
- ⑦ EXISTING FIRE ALARM CONTROL PANEL. FIELD VERIFY EXACT LOCATION.

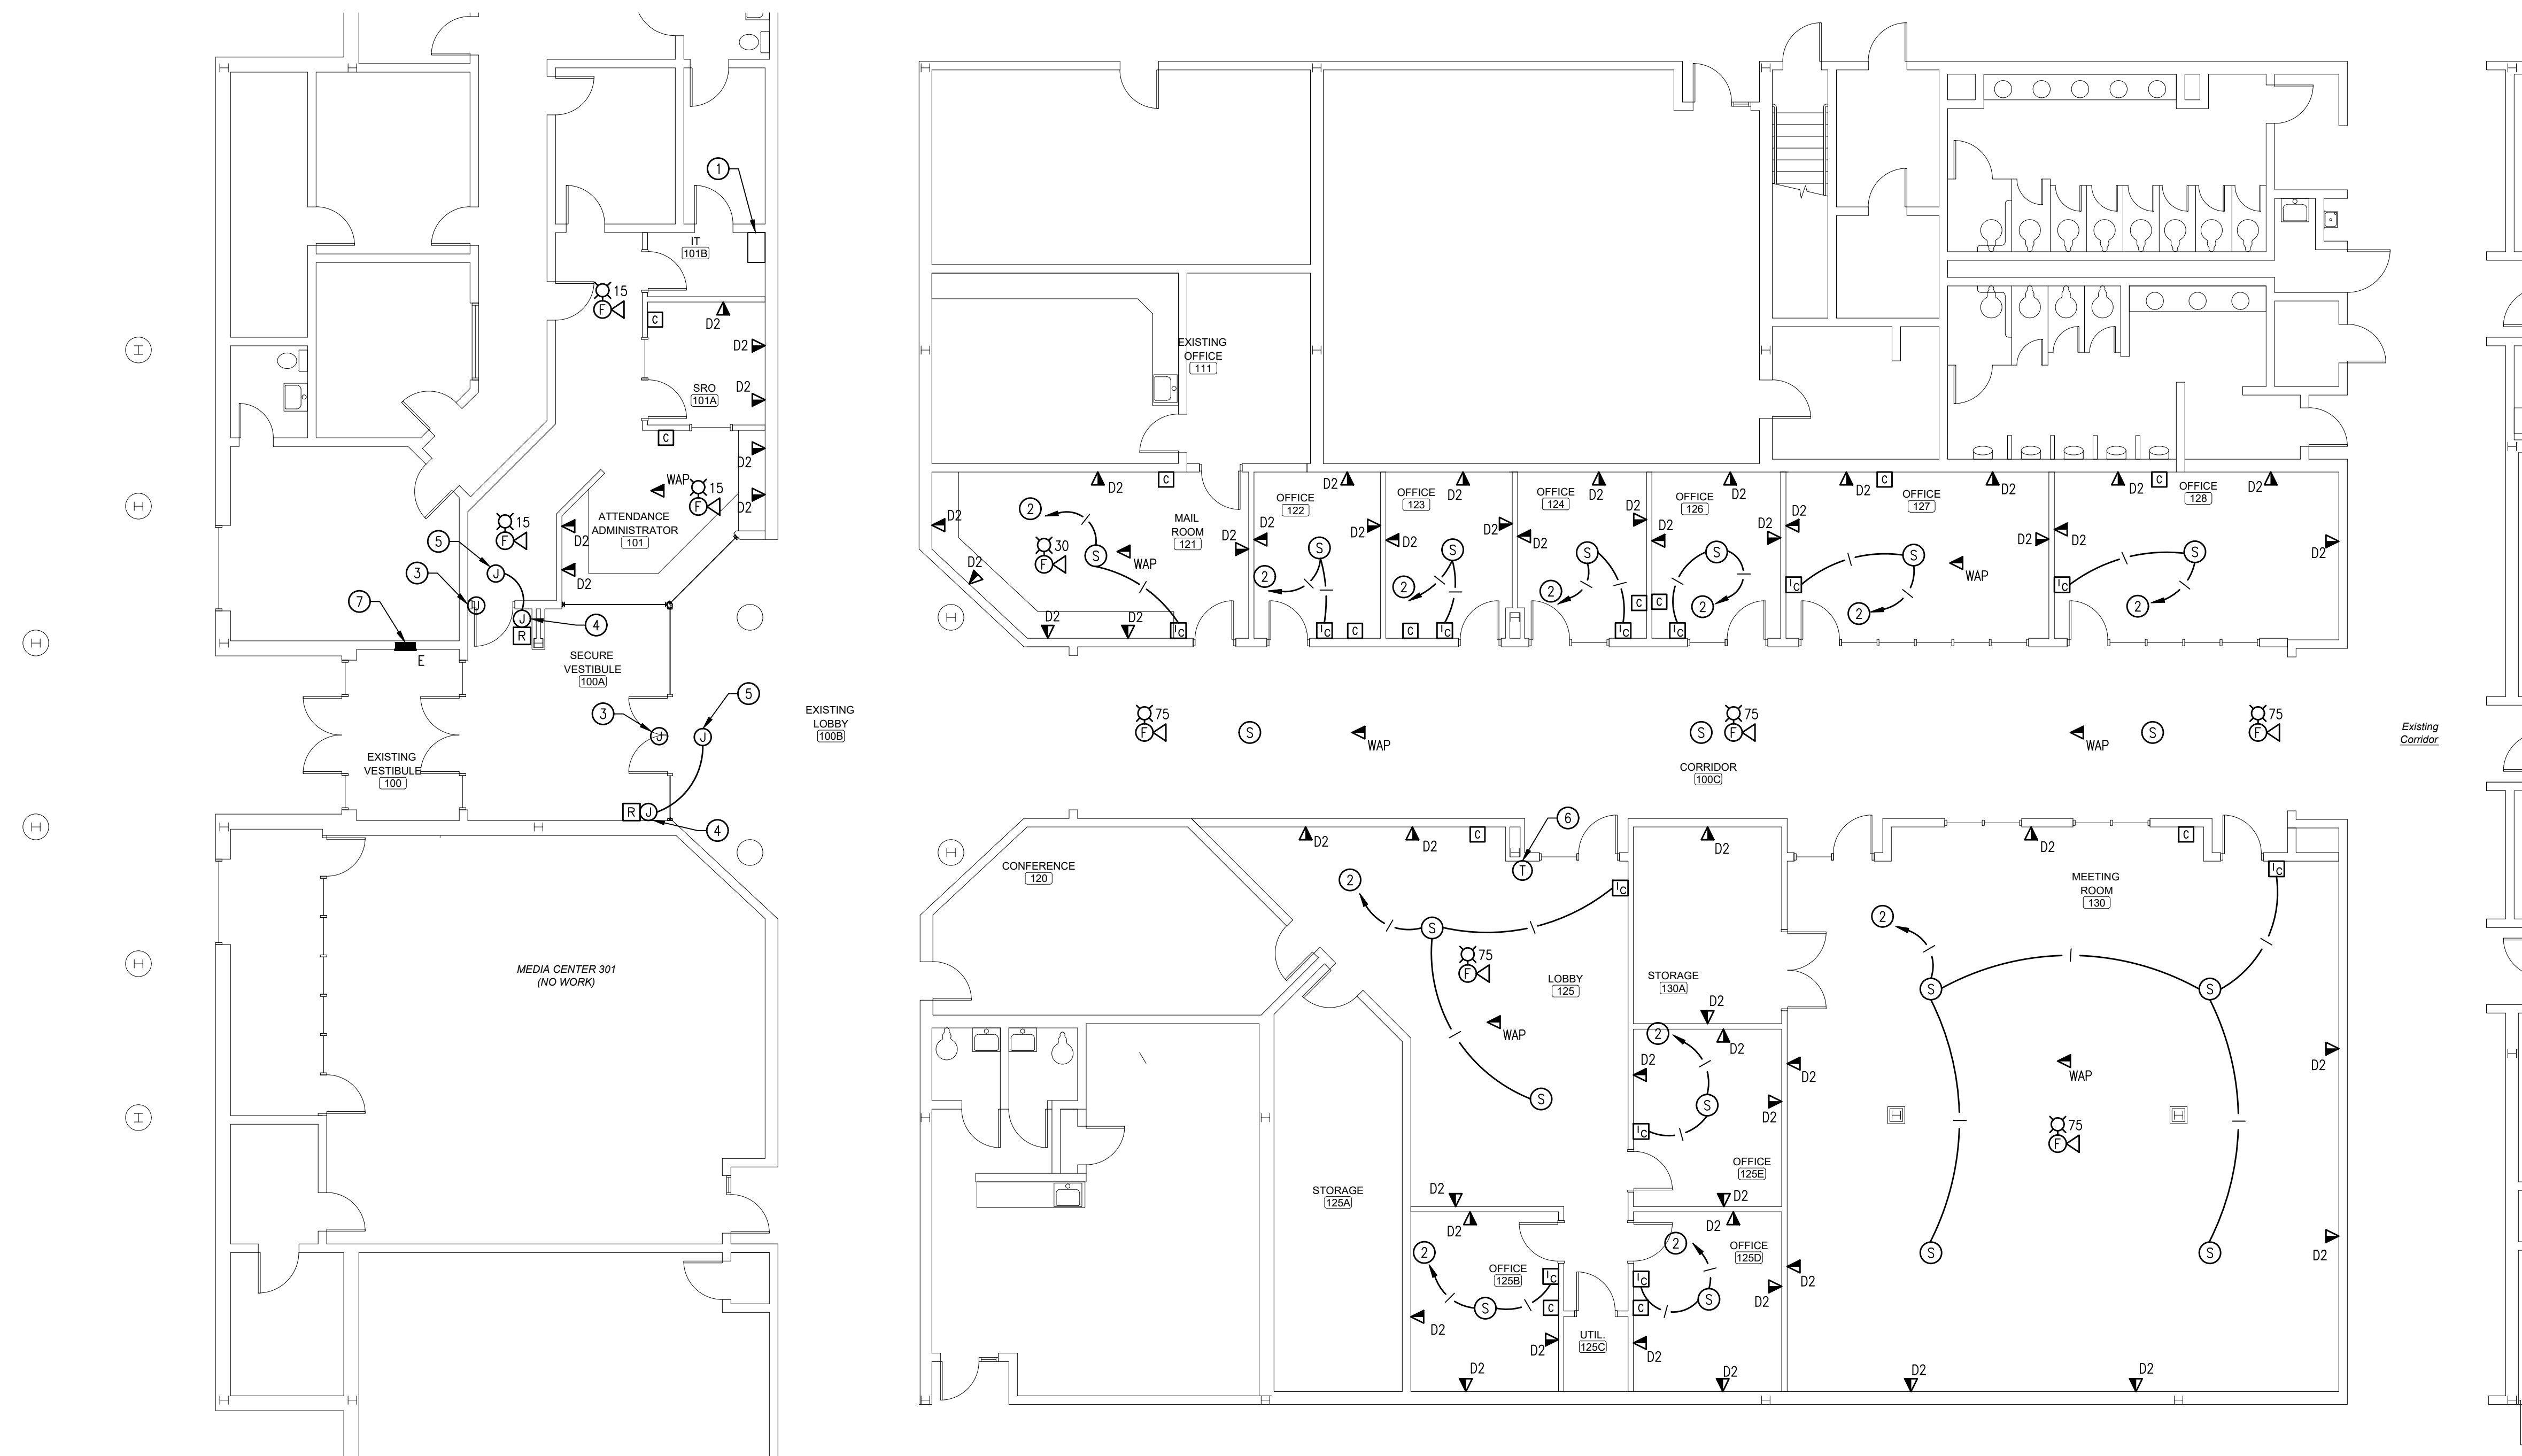

**SYSTEMS NEW WORK PLAN -  
MEDIA CENTER**  
SCALE: 1/8" = 1'-0"

**H.M. YONGE & ASSOCIATES, INC.**  
CONSULTING ENGINEERS / EST. 1988

51 EAST GREGORY STREET PENSACOLA, FLORIDA 32502 PHONE: (904)334-2661

253 ST. ANTHONY STREET MOBILE, ALABAMA 36603 PHONE: (251)690-7446





PROJ. MGR.:	A. VARGHESE
DRAWN:	C. PAGE
DATE:	03/25/26
REVISIONS	
#1	04/17/26 DCM COMMENTS

JOB NO. 25-160B

SHEET NO:

**E3.3**

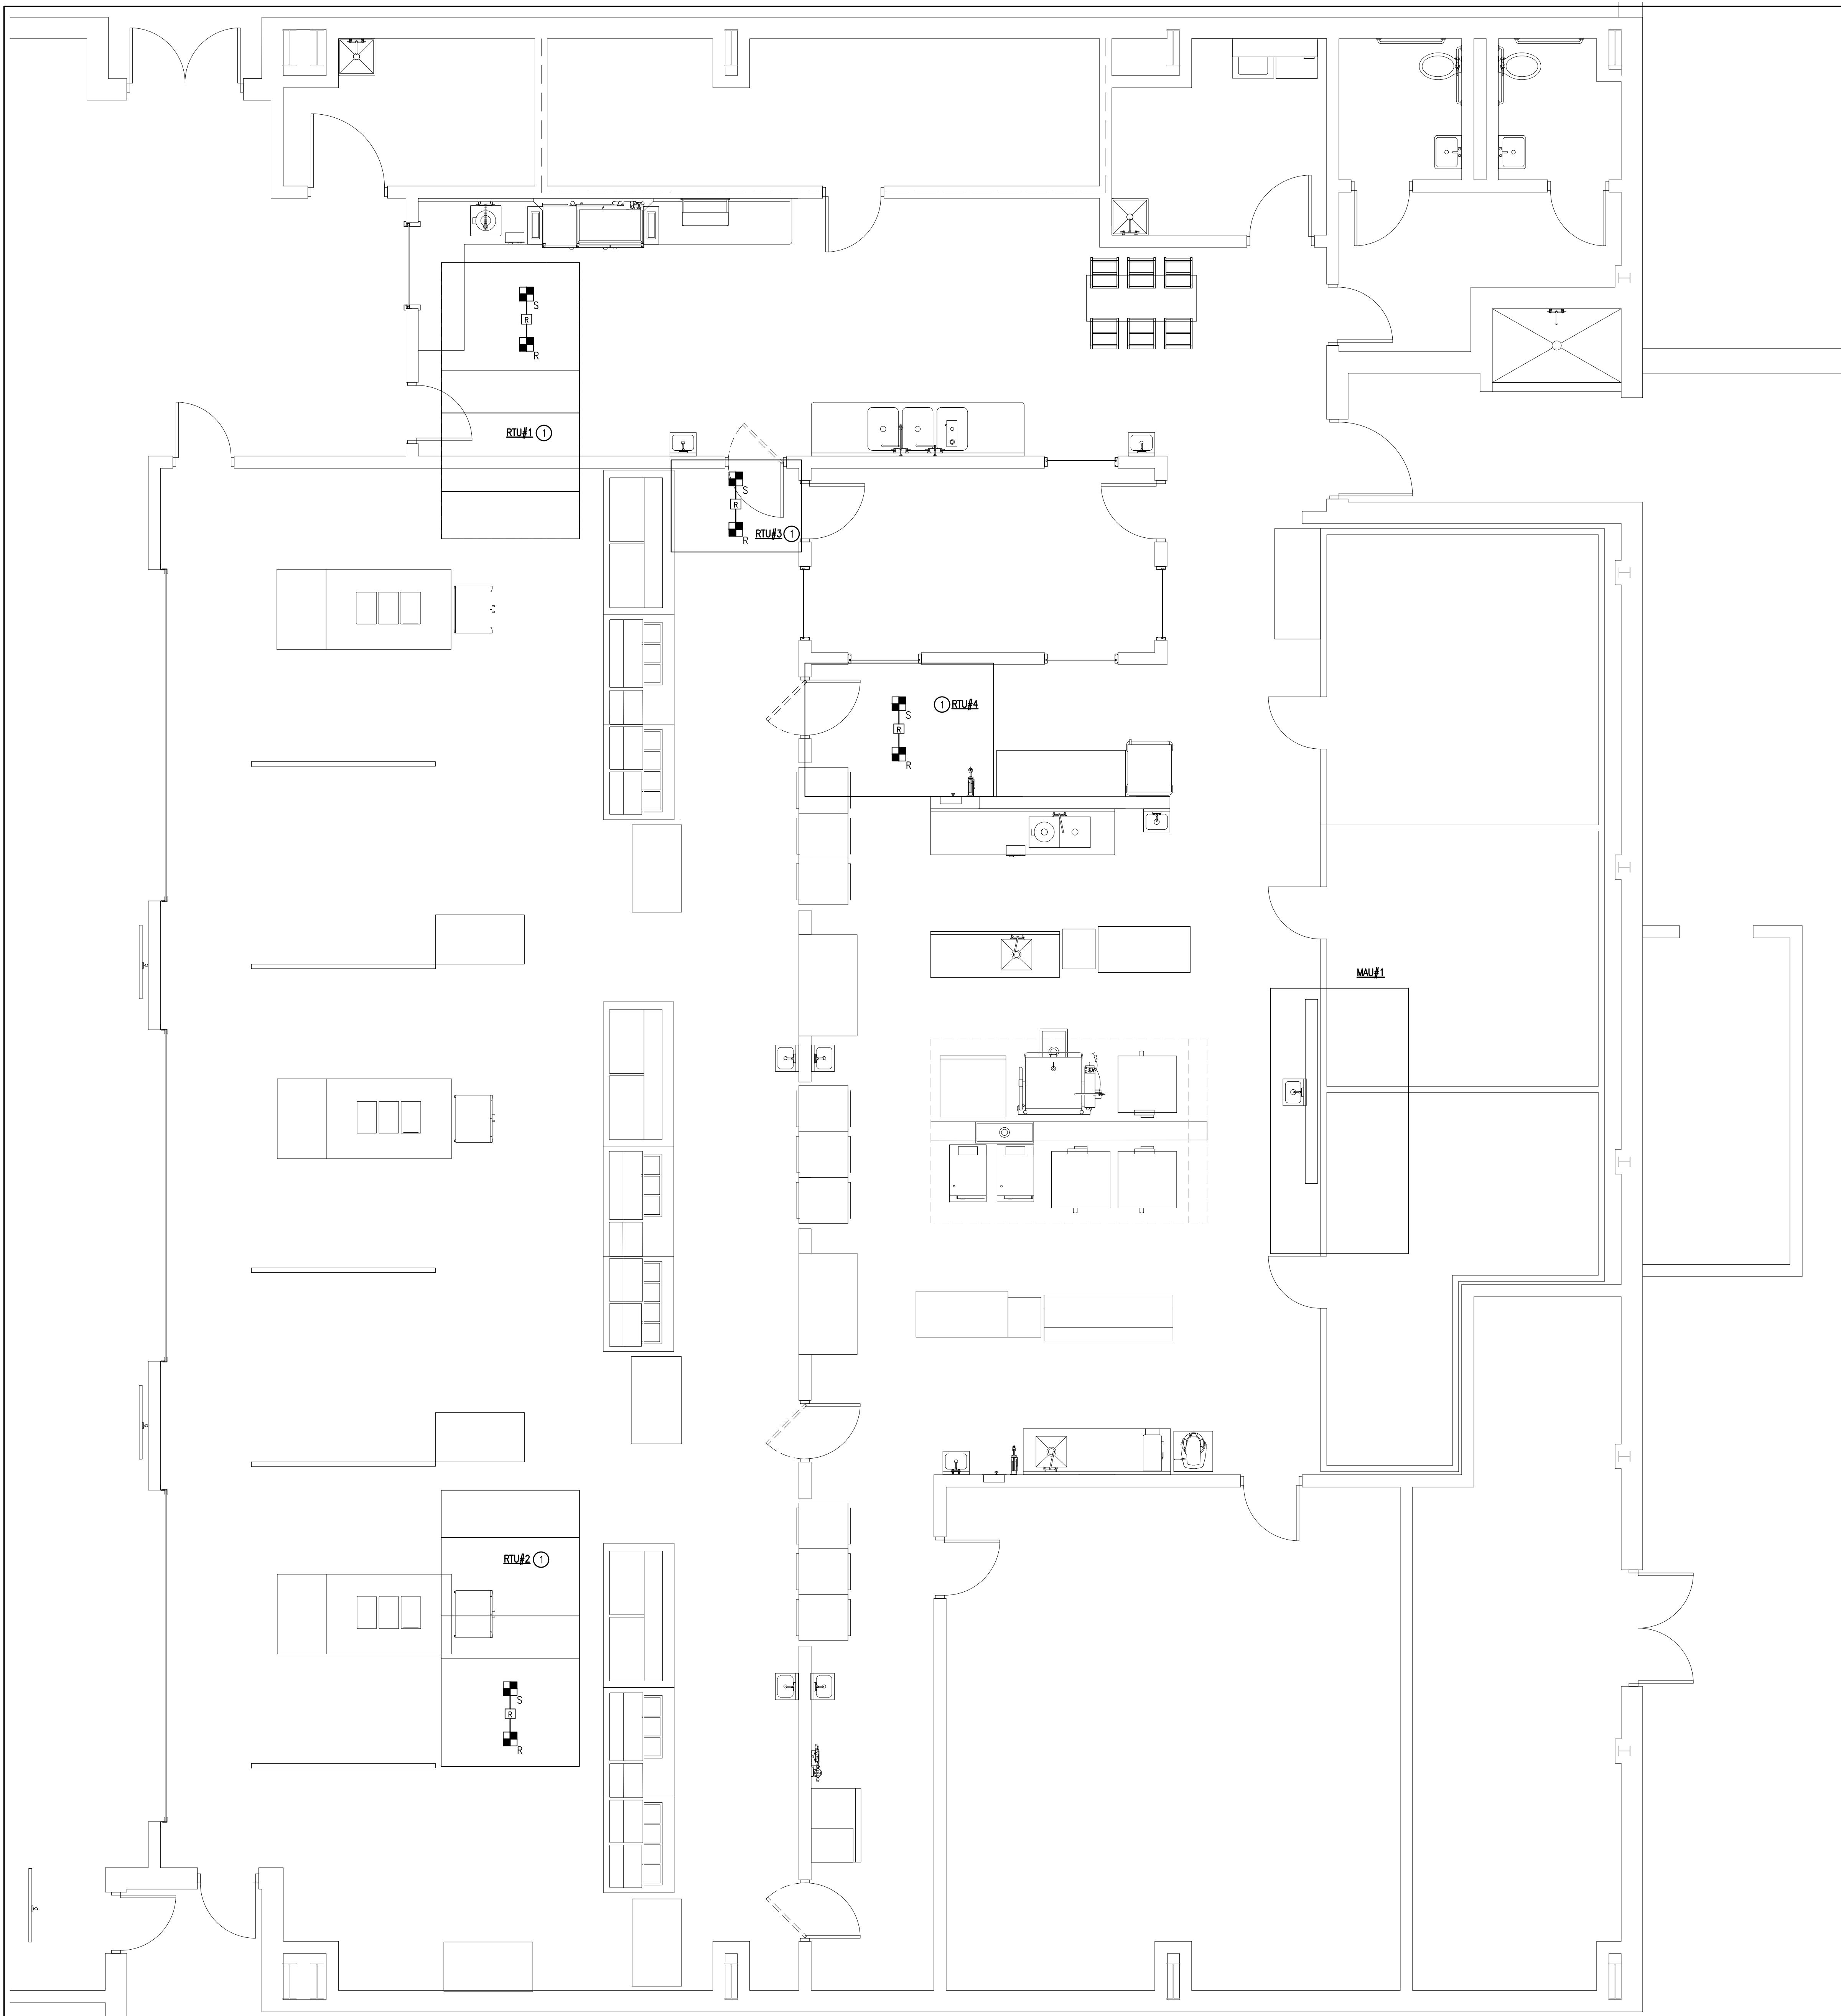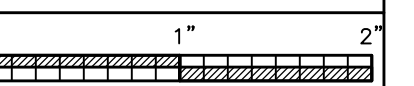


**SYSTEMS PLAN KEYNOTES**

- ① PROVIDE SUPPLY AND RETURN DUCT DETECTORS FOR NEW ROOF TOP UNIT. SUPPLY AND RETURN DETECTORS SHALL BE INTERLOCKED WITH THE FIRE ALARM CONTROL PANEL. SEE FIRE ALARM RISER ON SHEET E5.1 FOR MORE INFORMATION.

**HOOD CONTROL  
SEQUENCE OF  
OPERATION**


	EXHAUST FAN TURNS ON/STAYS ON	SUPPLY FAN TURNS ON	SUPPLY FAN TURNS OFF	SUPPRESSION SYSTEM ACTIVATES	ALARM SIGNAL SENT TO FACP	GAS SUPPLY SHUTS DOWN UNDER HOOD	ALL ELECTRICAL EXCEPT LIGHTING SHUTS DOWN UNDER HOOD
DUCT THERMAL SENSOR ACTIVATES	X	X					
FAN SWITCH ON HOOD	X	X					
SUPPRESSION SYSTEM FUSIBLE LINK OPERATES	X	X	X	X	X	X	X
SUPPRESSION SYSTEM MANUAL PULL OPERATES	X	X	X	X	X	X	X

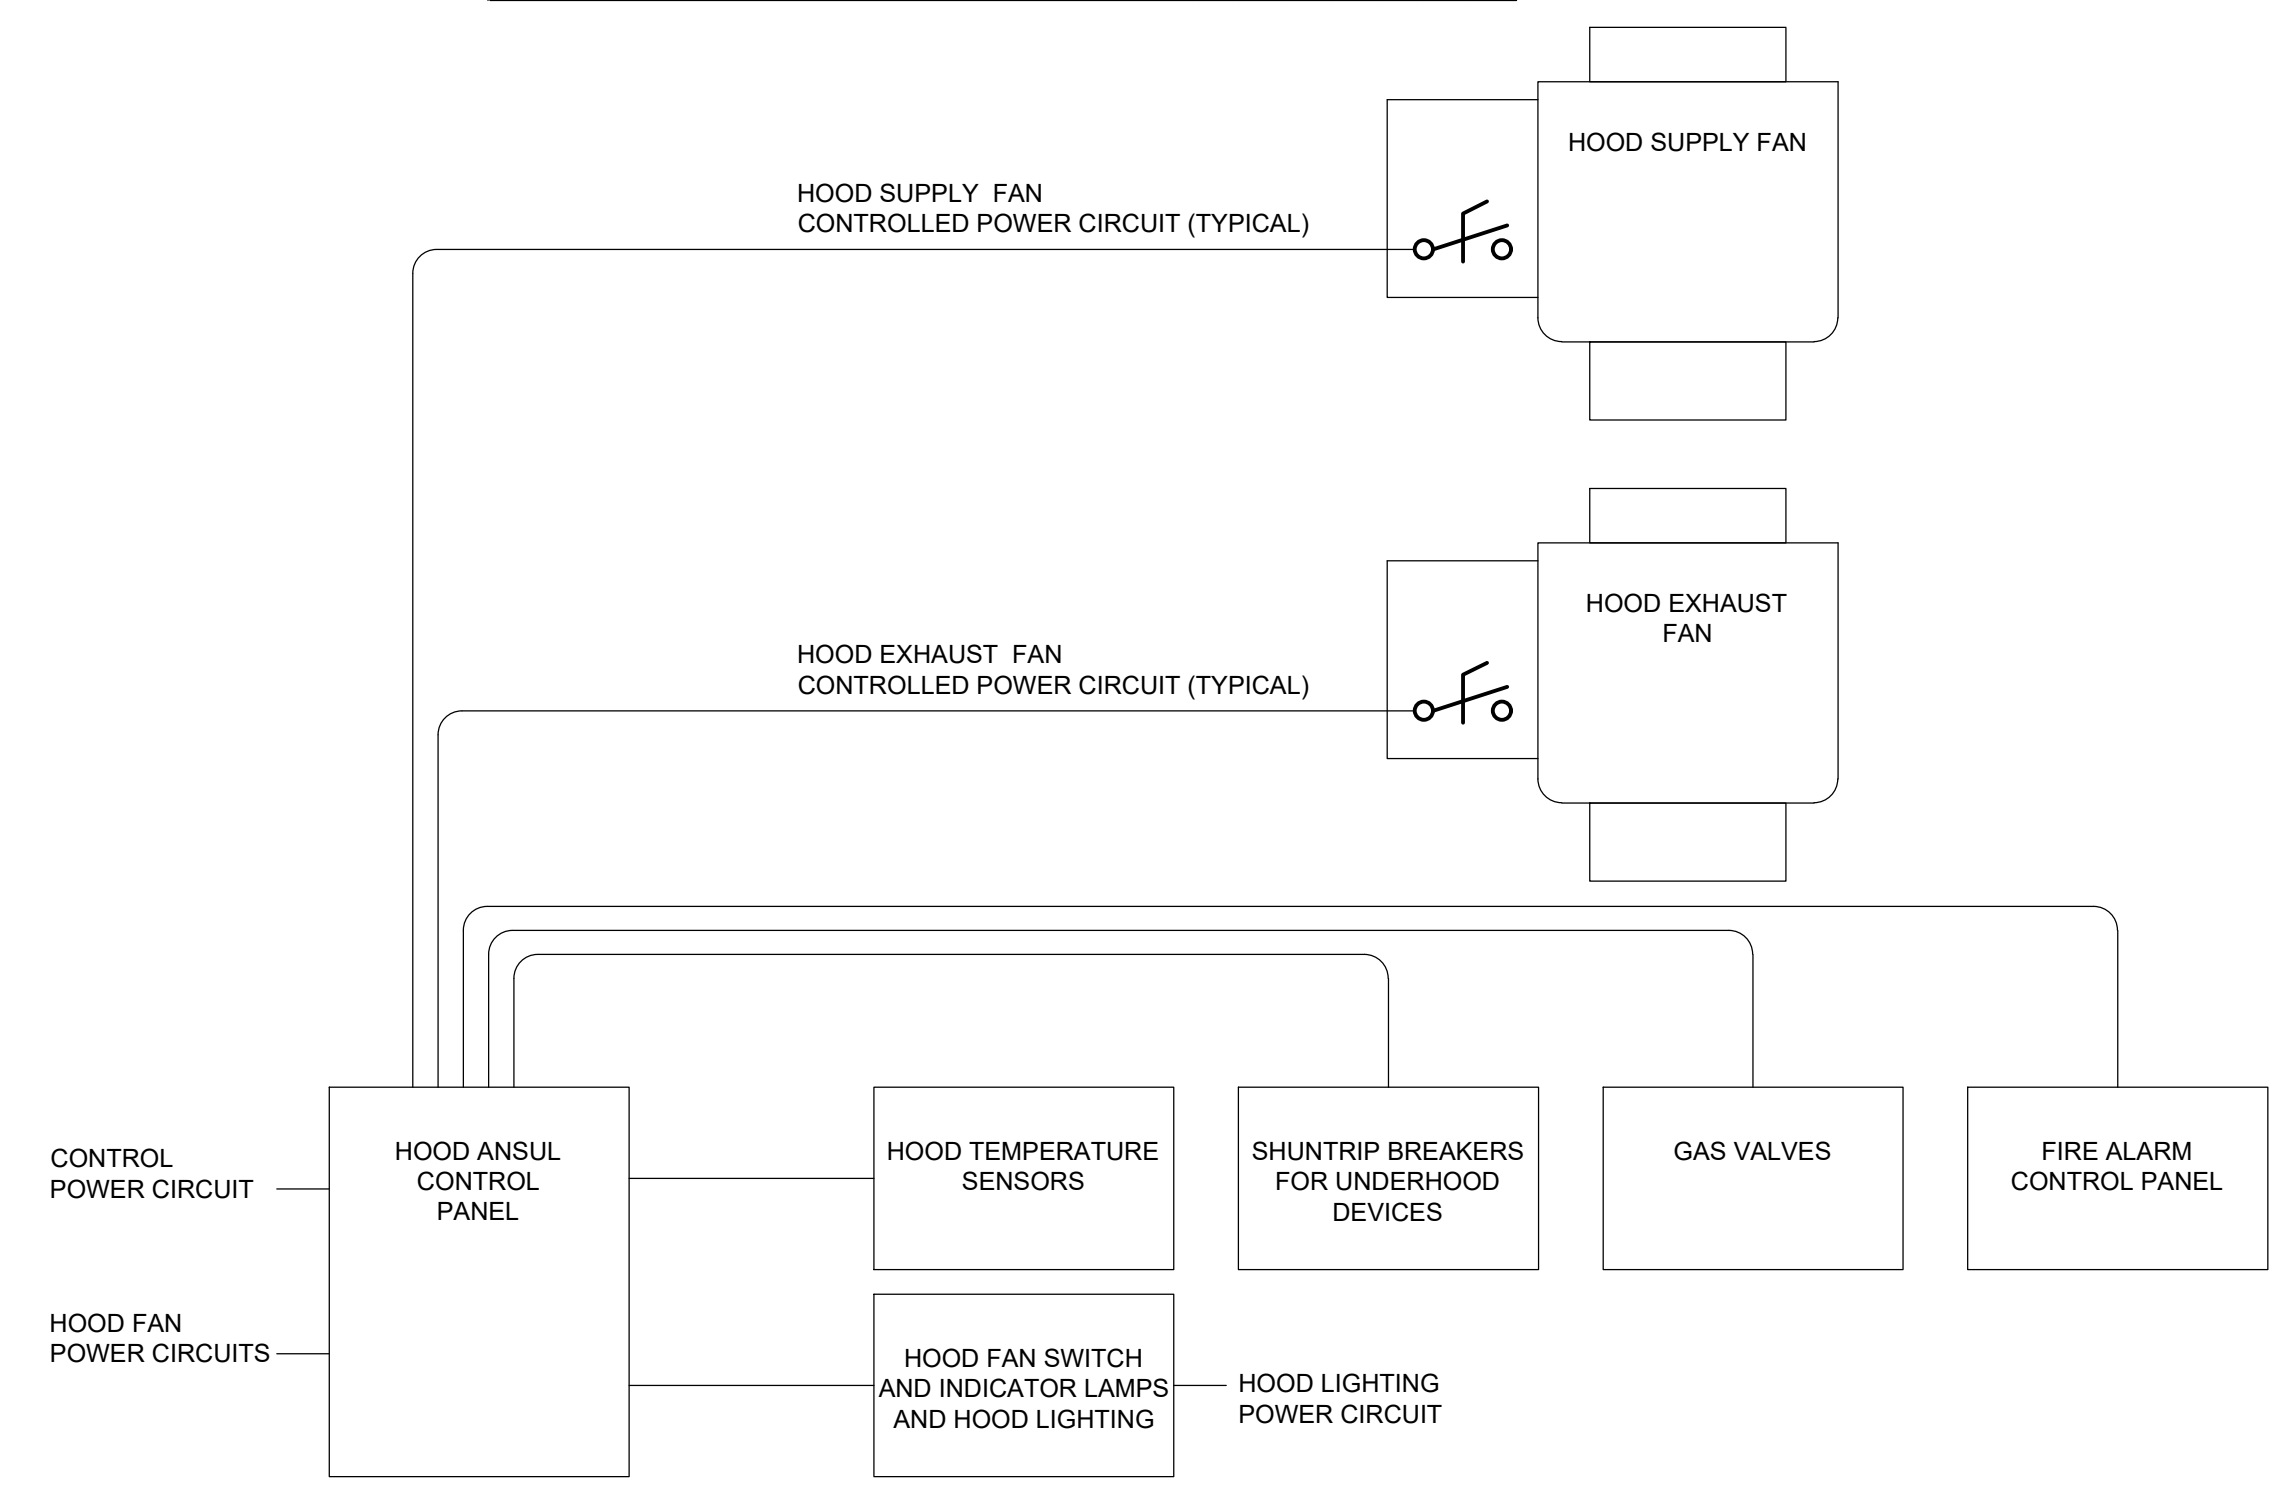

**HOOD CONTROL DIAGRAM**  
NOT TO SCALE



**SYSTEMS NEW WORK  
PLAN - KITCHEN**  
SCALE: 1/4" = 1'-0"

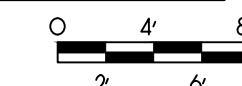

**H.M. YONGE & ASSOCIATES, INC.**  
CONSULTING ENGINEERS • EST. 1988


51 EAST GREGORY STREET  
PENSACOLA, FLORIDA 32502  
PHONE: 150534-2061

253 ST. ANTHONY STREET  
MOBILE, ALABAMA 36603  
PHONE: 1251690-7446



SITE IMPROVEMENTS AND INTERIOR ALTERATIONS TO FAIRHOPE HIGH SCHOOL  
ONE PIRATE DRIVE, FAIRHOPE, ALABAMA 36530  
BALDWIN COUNTY PUBLIC SCHOOLS

SHEET TITLE: ELECTRICAL PANEL SCHEDULES

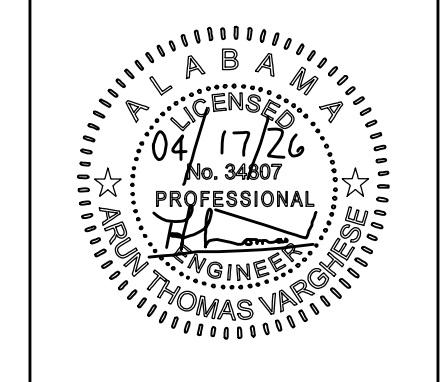

PROJ. MGR.: A. VARGHESE  
DRAWN: C. PAGE

DATE: 03/25/26  
REVISIONS  
#1 04/17/26 DCM COMMENTS

JOB NO. 25-160B

SHEET NO:

E4.0

NEMA 1, SURFACE MOUNT PANEL MDP SCHEDULE 42,000 AIC RATING						
CKT NO.	LOAD DESCRIPTION	BREAKER POLE AMP	KVA	BREAKER AMP POLE	LOAD DESCRIPTION	CKT NO.
1	RTU#1	3 90	62.1	90 3	RTU#2	2
3						4
5						6
7	RTU#3	3 60	25.1	28.0 70 3	RTU#4	8
9						10
11						12
13	PANEL KDP THRU XFMR	3 450	197.2	25.4 40 3	DISHWASHER (G)	14
15						16
17						18
19	WH-1	3 20	6.0	33.3 50 3	DISHWASHER BOOSTER HEATER (G)	20
21						22
23						24
25	PANEL LK	3 60	7.0	20 3	SPARE	26
27						28
29						30
31	SPARE	3 20	-	20 3	SPARE	32
33						34
35						36
37	SPARE	3 20	-	20 3	SPARE	38
39						40
41						42

CONNECTED LOAD 446.2 KVA

(G) INDICATES GFCI TYPE BREAKER.




NEMA 1, SURFACE MOUNT PANEL KDP SCHEDULE 10,000 AIC RATING						
CKT NO.	LOAD DESCRIPTION	BREAKER POLE AMP	KVA	BREAKER AMP POLE	LOAD DESCRIPTION	CKT NO.
1						2
3	PANEL KEM THROUGH ATS	3 125	29.7	162.1 600 3	PANEL KP	4
5						6
7						8
9	SPACE	3	5.4	60 3	PANEL RL	10
11						12

CONNECTED LOAD 197.2 KVA

NEMA 1, RECESSED MOUNT PANEL KP SCHEDULE 10,000 AIC RATING															
CKT NO.	LOAD DESCRIPTION	BREAKER POLE AMP	KVA	BREAKER AMP POLE	LOAD DESCRIPTION	CKT NO.	CKT NO.	LOAD DESCRIPTION	BREAKER POLE AMP	KVA	BREAKER AMP POLE	LOAD DESCRIPTION	CKT NO.		
1	FLY FAN	1 20	0.6	2.0 30 1	PROOFING CABINET (G)	2	55	HOT WATER DISPENSER (G)	2 30	5.0	1.0 20 1	CASHER LINE (G)	56		
3	CLOTHES DRYER (G)	2 30	4.4	1.0 15 1	ICE MACHINE (G)	4	57				1.0 20 1	CASHER LINE (G)	58		
5					0.5 20 1	DISH DRYER (G)	6	59	DISPOSAL (G)	3 20	2.4	1.0 20 1	CASHER LINE (G)	60	
7	WASHER (G)	1 20	1.2	1.0 20 2	COLD FOOD LINE (G)	8	61				0.7 20 1	REFRIG (G)	62		
9	COLD FOOD LINE (G)	2 20	1.0								0.7 20 1	MIXER (G)	64		
11					5.0 20 3	DISPOSAL	12	65	HVAC MAINT. RECS	1 20	0.4	0.4 20 1	MENU BOARD (G)	66	
13	COLD FOOD LINE (G)	2 20	1.0								0.4 20 1	MENU BOARD (G)	68		
15											0.4 20 1	MENU BOARD (G)	70		
17	HOT FOOD LINE (G)	2 20	1.0	1.5 20 2	PASSTHRU WARMER (G)	18	71	SPARE	1 20	-	1.0 20 1	STORAGE, RESTROOM RECS (G)	72		
19											1.0 20 1	UTILITY DISTRIBUTION (S)	74		
21	HOT FOOD LINE (G)	2 20	1.0	1.5 20 2	PASSTHRU WARMER (G)	22	75	MOTORIZED DOOR (G)	1 20	1.0	-	-	1	SHUNT TRIP	76
23											8.6 60 3	HOOD PANEL HP (S)	78		
25	HOT FOOD LINE (G)	2 20	1.0	1.5 20 2	PASSTHRU WARMER (G)	26	79	UNISEX RESTROOM RECS	1 20	0.4					80
27											1 20	0.8			82
29	PASSTHRU FRIDGE (G)	1 20	1.3	1.5 20 2	PASSTHRU WARMER (G)	30	83	OFFICE OUTLETS	1 20	1.0	-	-	1	SHUNT TRIP	84
31	PASSTHRU FRIDGE (G)	1 20	1.3								1 20	0.6	0.6 20 1	CONVENIENCE OUTLETS	86
33	PASSTHRU FRIDGE (G)	1 20	1.3	1.5 20 2	PASSTHRU WARMER (G)	34	87	CONVENIENCE OUTLETS	1 20	0.8	0.4 20 1	CONVENIENCE OUTLETS	88		
35	MILK COOLER (G)	1 20	0.9								1 20	0.8	0.4 20 1	CONVENIENCE OUTLETS	90
37	MILK COOLER (G)	1 20	0.9	1.5 20 2	PASSTHRU WARMER (G)	38	91	JANITOR, LAUNDRY RECS	1 20	1.2	2.7 20 3	KEF#1	92		
39	MILK COOLER (G)	1 20	0.9								3 250	70.8			94
41	REFRIG (G)	1 20	0.7	0.7 20 1	REFRIG (G)	42	95	MUA#1 (S)							96
43	REFRIG SERVING TABLE (G)	2 20	2.3	2.0 20 2	CONDIMENT LINE (G)	44	97								98
45															100
47	REFRIG SERVING TABLE (G)	2 20	2.3	2.0 20 2	CONDIMENT LINE (G)	48	101	TOWH-1 THROUGH -4	1 20	0.5					102
49											1 20	0.1	0.7 20 1	DEF#1	104
51	REFRIG SERVING TABLE (G)	2 20	2.3	2.0 20 2	CONDIMENT LINE (G)	52	105	DUMPSTER PAD REC	1 20	0.2	0.2 20 1	SOLENOID VALVE	106		
53											1 20	-	20 1	SPARE	108

CONNECTED LOAD 162.3 KVA

(L) INDICATES LOCKABLE BREAKER.  
(G) INDICATES GFCI TYPE BREAKER.  
(S) INDICATES BREAKER WITH SHUNT TRIP MODULE, CONTRACTOR TO PROVIDE SPACE IN PANELBOARD AS NECESSARY FOR MOUNTING OF SHUNT TRIP ACCESSORY.  
PANELBOARD LAYOUT INCLUDING SHUNT TRIP UNIT LOCATION SHALL BE INCLUDED IN THE SHOP DRAWINGS. PROVIDE INTERLOCK CONNECTIONS TO HOOD CONTROL PANEL AS REQUIRED.

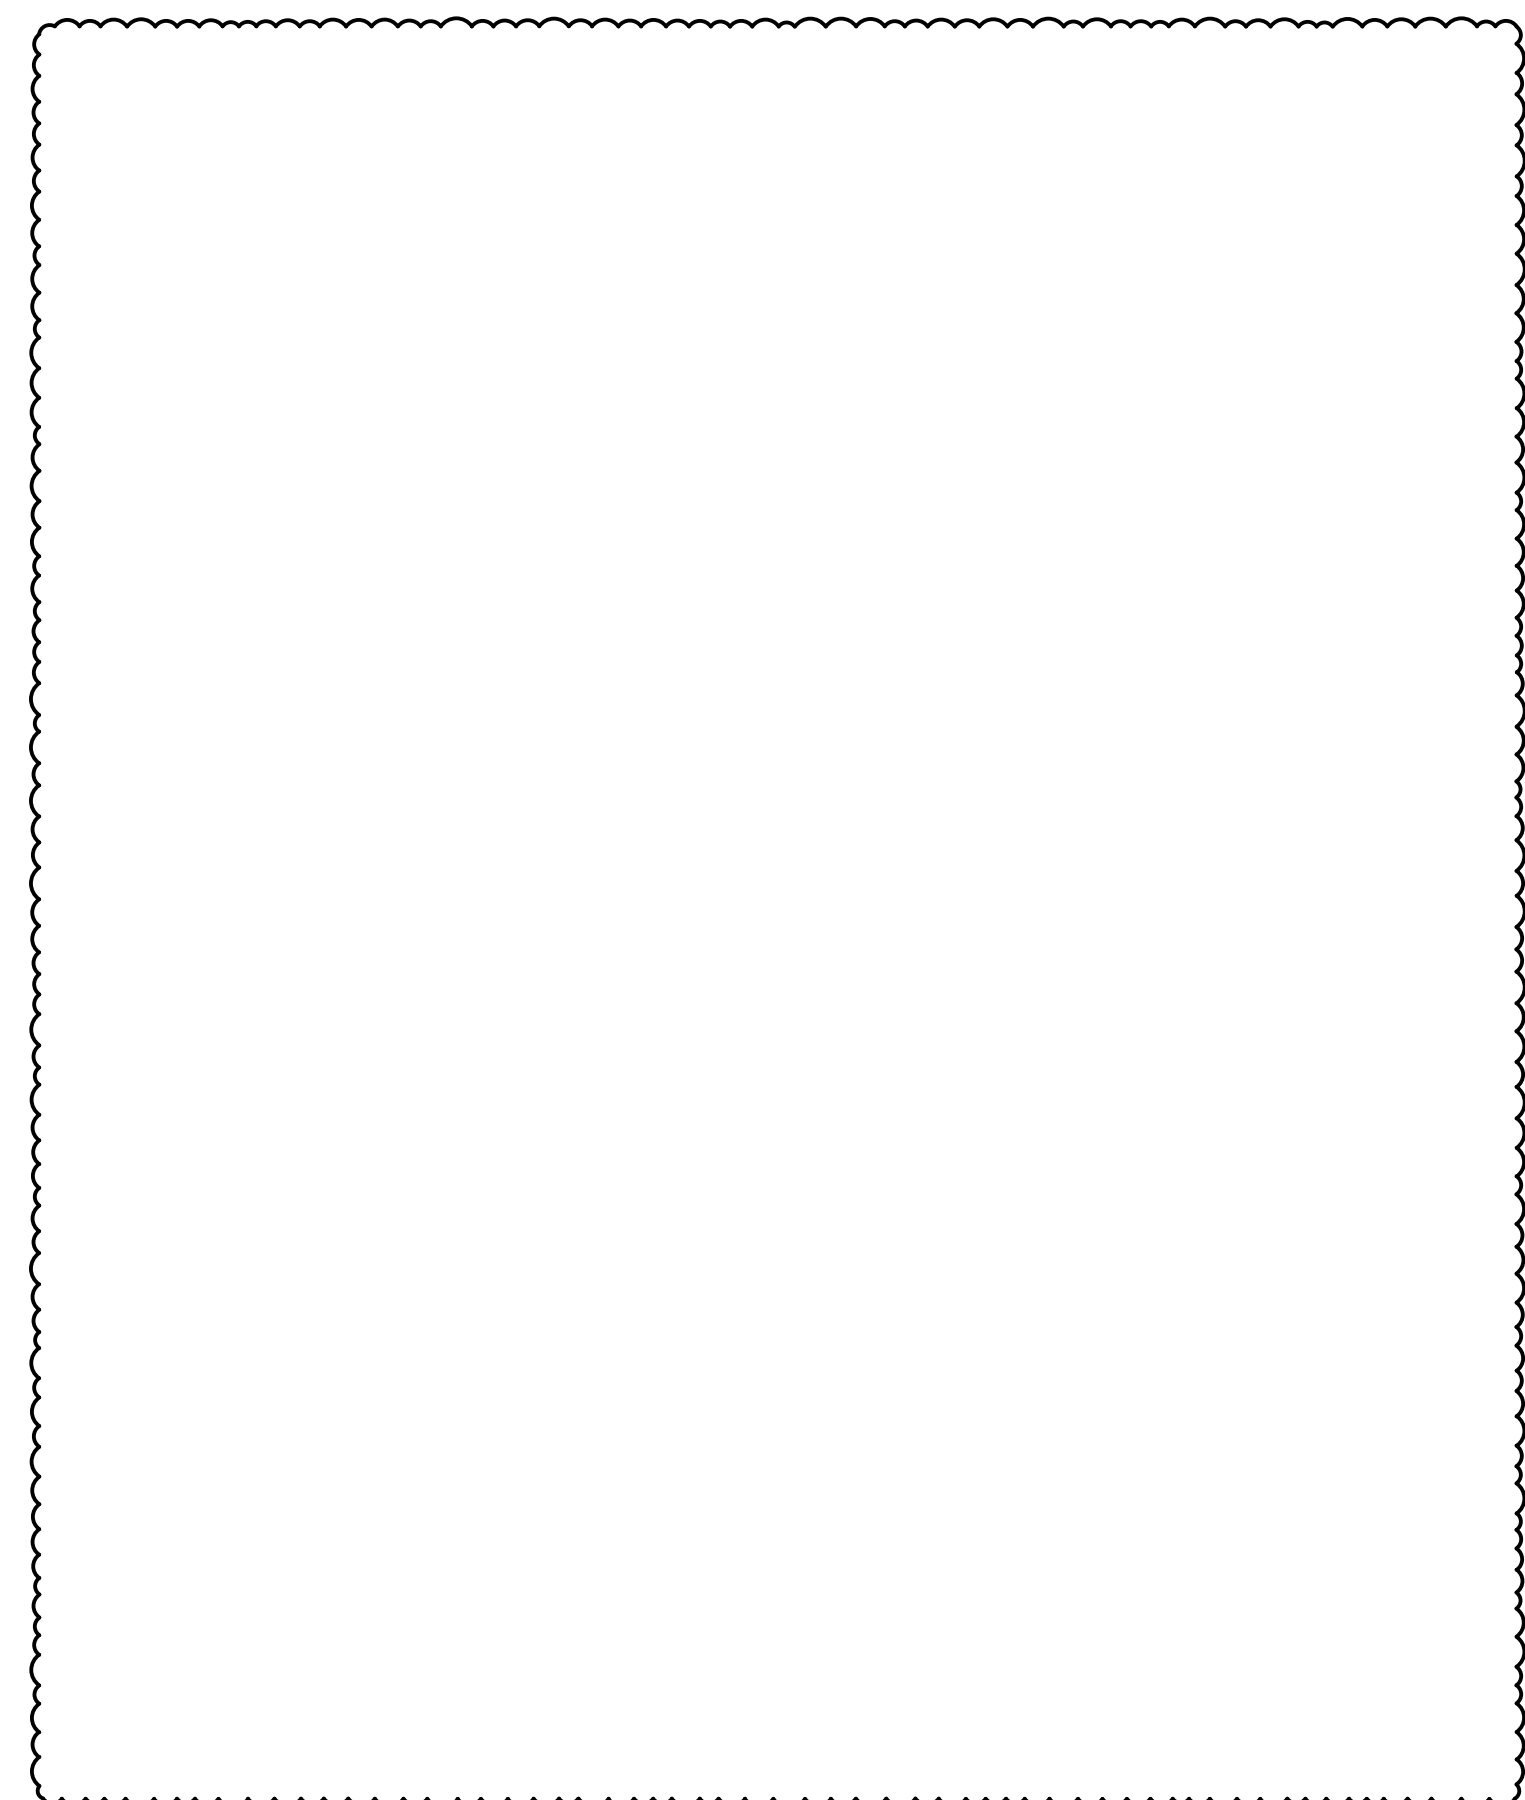

EQUIPMENT ELECTRICAL SCHEDULE							
MARK	ITEM	VOLTAGE/ $\phi$	DISCONNECT SWITCH	CONDUCTORS	FEEDER	GROUND	CONDUIT
RTU#1	ROOFTOP UNIT	480/3	100/3 N3R	3#3	#8		1.25" C
RTU#2	ROOFTOP UNIT	480/3	100/3 N3R	3#3	#8		1.25" C
RTU#3	ROOFTOP UNIT	480/3	60/3 N3R	3#6	#10		1.00" C
RTU#4	ROOFTOP UNIT	480/3	100/3 N3R	3#4	#8		1.25" C
MUA#1	MAKE UP AIR UNIT	208/3	400/3 N3R	3#250	#4		3.00" C
ATU#1	AIR TERMINAL UNIT	277/1	INTEGRAL	2#12	#12		0.75" C
EF#1	EXHAUST FAN	120/1	LIGHT SWITCH	2#12	#12		0.75" C
EF#2	EXHAUST FAN	120/1	LIGHT SWITCH	2#12	#12		0.75" C
EF#3	EXHAUST FAN	120/1	LIGHT SWITCH	2#12	#12		0.75" C
EF#4	EXHAUST FAN	120/1	LIGHT SWITCH	2#12	#12		0.75" C
EF#5	EXHAUST FAN	120/1	LIGHT SWITCH	2#12	#12		0.75" C
EF#6	EXHAUST FAN	120/1	LIGHT SWITCH	2#12	#12		0.75" C
EF#7	EXHAUST FAN	120/1	T-SWIT	2#12	#12		0.75" C
FF#1	FLY FAN	120/1	DOOR SWITCH	2#12	#12		0.75" C
KEF#1	KITCHEN EXHAUST FAN	208/3	30/3 N3R	3#12	#12		0.75" C
KEF#2	KITCHEN EXHAUST FAN	208/3	30/3 N3R	3#12	#12		0.75" C
DEF#1	DISHWASHER EXHAUST FAN	120/1	30/1 N3R	2#12	#12		0.75" C
TOWH-1	TANKLESS GAS WATER HEATER	120/1	MECH SWITCH	2#12	#12		0.75" C
TOWH-2	TANKLESS GAS WATER HEATER	120/1	MECH SWITCH	2#12	#12		0.75" C
TOWH-3	TANKLESS GAS WATER HEATER	120/1	MECH SWITCH	2#12	#12		0.75" C
TOWH-4	TANKLESS GAS WATER HEATER	120/1	MECH SWITCH	2#12	#12		0.75" C
WH-1	WATER HEATER	480/3	30/3 N3R	3#12	#12		0.75" C

NEMA 1, RECESSED MOUNT PANEL LK SCHEDULE 10,000 AIC RATING							
CKT NO.	LOAD DESCRIPTION	BREAKER POLE AMP	KVA	BREAKER AMP POLE	LOAD DESCRIPTION	CKT NO.	
1	BLDG EXTERIOR LTS	1 20	1.2	0.8 20 1	RESTROOMS, ENTRY LOBBY LTS	2	
3	CAFETERIA LTS	1 20	2.0	0.8 20 1	SERVING LTS	4	
5	DRY STOR., ELEC. LTS	1 20	0.6	0.6 20 1	RR, LAUNDRY, STORAGE LTS	6	
7	KITCHEN LTS	1 20	1.0	-	20 1	SPARE	8
9	SPARE	1 20	-	-	20 1	SPARE	10
11	SPARE	1 20	-	-	20 1	SPARE	12
13	SPARE	1 20	-	-	20 1	SPARE	14
15	SPARE	1 20	-	-	20 1	SPARE	16
17	SPARE	1 20	-	-	20 1	SPARE	18

CONNECTED LOAD 7.0 KVA

NEMA 1, RECESSED MOUNT PANEL RL SCHEDULE 10,000 AIC RATING							
CKT NO.	LOAD DESCRIPTION	BREAKER POLE AMP	KVA	BREAKER AMP POLE	LOAD DESCRIPTION	CKT NO.	
1	EWC	(G) 1 20	1.2	1.0 20 1	FIRE ALARM BOOSTER PANEL (L)	2	
3	LADIES 514 REC	1 20	0.2	0.8 20 1	CAFETERIA RECS	4	
5	GENTLEMEN 515 REC	1 20	0.2	0.8 20 1	CAFETERIA RECS	6	
7	HVAC MAINTANANCE RECS	1 20	0.8	0.4 20 1	LOBBY 511 RECS	8	
9	ERRCS PANEL	1 20	1.0	0.2 20 1	SMOKE DAMPERS	10	
11	TBB	1 20	0.4	0.4 20 1	STORAGE REC	12	
13	DOOR INTERLOCKING HARDWARE	1 20	0.2	-	20 1	SPARE	14
15	SPARE	1 20	-	-	20 1	SPARE	16
17	SPARE	1 20	-	-	20 1	SPARE	18


CONNECTED LOAD 7.6 KVA

(G) INDICATES GFCI TYPE BREAKER.  
(L) INDICATES LOCKABLE TYPE BREAKER.

NEMA 1 LOAD CENTER HP* SCHEDULE 10,000 AIC RATING							
CKT NO.	LOAD DESCRIPTION	BREAKER POLE AMP	KVA	BREAKER AMP POLE	LOAD DESCRIPTION	CKT NO.	
1	COMBI OVEN (G)	1 20	1.6	0.4 20 1	BRAISING PAN (G)	2	
3	COMBI OVEN (G)	1 20	1.6	0.7 20 1	DOUBLE STACK OVEN (G)	4	
5	DOUBLE STACK OVEN (G)	1 20	0.7	0.7 20 1	DOUBLE STACK OVEN (G)	6	
7	DOUBLE STACK OVEN (G)	1 20	0.7	0.7 20 1	DOUBLE STACK OVEN (G)	8	
9	DOUBLE CONVECTION STEAMER (G)	1 20	0.2	0.7 20 1	DOUBLE STACK OVEN (G)	10	
11	DOUBLE CONVECTION STEAMER (G)	1 20	0.2	0.2 20 1	DOUBLE CONVECTION STEAMER (G)	12	
13	SPARE	1 20	-	0.2 20 1	DOUBLE CONVECTION STEAMER (G)	14	
15	SPARE	1 20	-	-	20 1	SPARE	16
17	SPARE	1 20	-	-	20 1	SPARE	18

CONNECTED LOAD 8.6 KVA

(G) INDICATES GFCI TYPE BREAKER.  
(\*) PANEL IS SUPPLIED THROUGH SHUNT TRIP BREAKER IN PANEL KP.

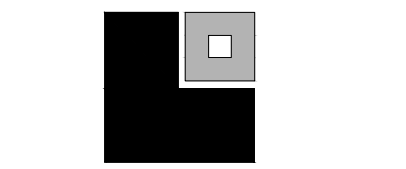


**LATHAN  
McKEE**  
ARCHITECTS



**SITE IMPROVEMENTS AND  
INTERIOR ALTERATIONS TO  
FAIRHOPE HIGH SCHOOL**  
ONE PIRATE DRIVE  
FAIRHOPE, ALABAMA 36532  
BALDWIN COUNTY PUBLIC SCHOOLS

SHEET TITLE: ELECTRICAL PANEL SCHEDULES

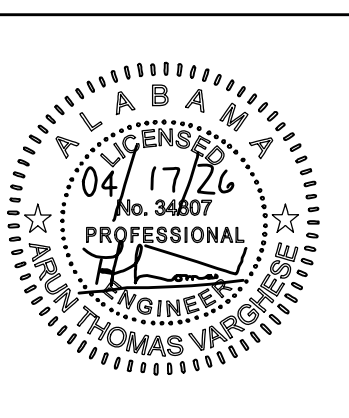


PROJ. MGR.:	A. VARGHESE
DRAWN:	C. PAGE
DATE:	03/25/26
REVISIONS	
#1	04/17/26 DCM COMMENTS

JOB NO. 25-160B

SHEET NO:

**E4.1**

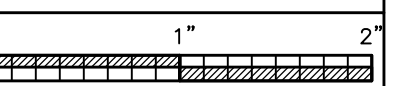

H.M. YONGE & ASSOCIATES, INC.  
CONSULTING ENGINEERS / EST. 1988  
51 EAST GREGORY STREET PENSACOLA, FLORIDA 32502  
PHONE: 1505434-2061 253 ST. ANTHONY STREET MOBILE, ALABAMA 36603  
PHONE: 1251690-7446

**EXIST. PANEL P2 SCHEDULE (SEC 3)**

250A M.L.O. 208Y/120V 3ø 4W 22,000 AIC RATING

CKT NO.	LOAD DESCRIPTION	BREAKER POLE	AMP	KVA	BREAKER AMP	POLE	LOAD DESCRIPTION	CKT NO.
73	PLUG MOLD RM. 225	(E)	1	20	1.0	1.1	20 1	RECS CR. 229 (E) 74
75	PLUG MOLD RM. 225	(E)	1	20	1.0	0.6	20 1	RECS CR. 229 COMPUTER (E) 76
77	RECS RM. 153+154	(E)	1	20	0.9	0.7	20 1	RECS GYMNASIUM (E) 78
79	RECS RM. 262+263	(E)	1	20	0.5	0.7	20 1	RECS GYMNASIUM (E) 80
81	SCORE BOARD CONTROL	(E)	1	20	0.2	1.0	20 1	GYM AMPLIFIER (E) 82
83	RECS ELEC. RM.	(E)	1	20	0.7	1.6	20 1	SCORE BOARD POWER (E) 84
85	RECS RM. 227	(E)	1	20	0.7	-	20 1	SPARE (E) 86
87	RECS RM. 226+228	(E)	1	20	0.7	-	20 1	SPARE (E) 88
89	SPARE	(E)	1	20	-	-	20 1	SPARE (E) 90
91	SPARE	(E)	1	20	-	0.8	20 1	ADMINISTRATOR 101 RECS (N) 92
93	SPARE	(E)	1	20	-	0.8	20 1	MEETING ROOM 130 RECS (N) 94
95	SPARE	(E)	1	20	-	0.8	20 1	MEETING ROOM 130 RECS (N) 96
97	LOBBY 125 RECS	(N)	1	20	1.0	0.8	20 1	OFFICE 125E RECS (N) 98
99	CORRIDOR 100C RECS	(N)	1	20	1.0	0.8	20 1	OFFICE 125D RECS (N) 100
101	HVAC MAINT. REC	(N)	1	20	0.2	0.8	20 1	OFFICE 125B RECS (N) 102
103	SPACE	-	-	-	-	-	-	SPACE (E) 104
105	SPACE	-	-	-	-	-	-	SPACE (E) 106
107	SPACE	-	-	-	-	-	-	SPACE (E) 108

CONNECTED LOAD ... KVA

(E) INDICATES EXISTING BREAKER AND CIRCUIT SHALL REMAIN.  
(N) INDICATES NEW BREAKER AND CIRCUIT SHALL REPLACE EXISTING.

**EXIST. PANEL P2 SCHEDULE (SEC 2)**

250A M.L.O. 208Y/120V 3ø 4W 22,000 AIC RATING

CKT NO.	LOAD DESCRIPTION	BREAKER POLE	AMP	KVA	BREAKER AMP	POLE	LOAD DESCRIPTION	CKT NO.
37	RECS MEZZANINE	(E)	1	20	0.5	1.0	20 1	HAIR DRYER RM. 235 (E) 38
39	RECS CORRIDOR	(E)	1	20	0.9	1.0	20 1	HAIR DRYER RM. 235 (E) 40
41	RECS RM. 221	(E)	1	20	0.7	1.0	20 1	HAIR DRYER RM. 235 (E) 42
43	COKE DISPENSER RM. 220	(E)	1	20	1.2	0.7	20 1	E.W.C. (E) 44
45	ICE MAKER RM. 220	(E)	2	20	2.4	0.9	20 1	RECS RM. 236+241 (E) 46
47					1.1	20 1	RECS RM. 239 (E) 48	
49	SMALL APP. RM. 220	(E)	1	20	1.5	5.0	30 2	DRYER RM. 237 (E) 50
51	PLUGMOLD RM. 225	(E)	1	20	1.0	-	-	52
53	PLUGMOLD RM. 225	(E)	1	20	1.0	1.5	20 1	CLOTHES WASHER RM. 237 (E) 54
55	PLUGMOLD RM. 225	(E)	1	20	1.0	0.5	20 1	RECS RM. 242 (E) 56
57	PLUGMOLD RM. 225	(E)	1	20	1.0	0.4	20 1	RECS RM. 245 (E) 58
59	PLUGMOLD RM. 225	(E)	1	20	1.0	5.0	30 2	DRYER RM. 247 (E) 60
61	PLUGMOLD RM. 225	(E)	1	20	1.0	-	-	62
63	PLUGMOLD RM. 225	(E)	1	20	1.0	1.5	20 1	CLOTHES WASHER RM. 287 (E) 64
65	PLUGMOLD RM. 225	(E)	1	20	1.0	0.5	20 1	RECS RM. 250+251 (E) 66
67	PLUGMOLD RM. 225	(E)	1	20	1.0	0.7	20 1	RECS RM. 249 (E) 68
69	PLUGMOLD RM. 225	(E)	1	20	1.0	0.7	20 1	E.W.C. (E) 70
71	PLUGMOLD RM. 225	(E)	1	20	1.0	0.7	20 1	E.W.C. (E) 72

CONNECTED LOAD ... KVA

(E) INDICATES EXISTING BREAKER AND CIRCUIT SHALL REMAIN.  
(N) INDICATES NEW BREAKER AND CIRCUIT SHALL REPLACE EXISTING.

**EXIST. PANEL P2 SCHEDULE (SEC 1)**

250A M.B. 208Y/120V 3ø 4W 22,000 AIC RATING

CKT NO.	LOAD DESCRIPTION	BREAKER POLE	AMP	KVA	BREAKER AMP	POLE	LOAD DESCRIPTION	CKT NO.
1	RECS CR.104	(E)	1	20	0.9	0.6	20 1	MAIL ROOM 121 RECS (N) 2
3	RECS CR.104	(E)	1	20	0.9	0.6	20 1	MAIL ROOM 121 RECS (N) 4
5	RECS CR.104	(E)	1	20	0.9	0.8	20 1	SRO OFFICE RECS (N) 6
7	RECS CR.104	(E)	1	20	0.9	0.8	20 1	OFFICE 128 RECS (N) 8
9	RECS CR.104	(E)	1	20	0.9	0.8	20 1	OFFICE 127 RECS (N) 10
11	RECS CR.104	(E)	1	20	0.9	0.8	20 1	OFFICE 126 RECS (N) 12
13	RECS CR.104	(E)	1	20	0.9	0.8	20 1	OFFICE 124 RECS (N) 14
15	RECS CR.104	(E)	1	20	0.9	0.8	20 1	OFFICE 123 RECS (N) 16
17	RECS CR.108	(E)	1	20	1.1	0.8	20 1	OFFICE 122 RECS (N) 18
19	RECS CORRIDOR	(E)	1	20	0.9	3.0	20 2	XEROX 1075 RM.150 (E) 20
21	RECS CORRIDOR	(E)	1	20	0.9	-	-	22
23	CR.164	(E)	2	20	2.0	1.5	20 1	SMALL APP. RM 150 (E) 24
25					0.9	20 1	RECS RM. 150 (E) 26	
27	RECS CR.164	(E)	1	20	0.7	0.7	20 1	RECS RM. 168 (E) 28
29	RECS CR.164	(E)	1	20	0.7	0.9	20 1	RECS RM. 165+167 (E) 30
31	RECS CR.164	(E)	1	20	0.7	0.7	20 1	E.W.H. (E) 32
33	RECS CR.164	(E)	1	20	0.7	0.4	20 1	EF-4.5,24 (E) 34
35	RECS CR.164	(E)	1	20	0.7	1.0	20 1	EF-10,11 (E) 36

CONNECTED LOAD ... KVA

(E) INDICATES EXISTING BREAKER AND CIRCUIT SHALL REMAIN.  
(N) INDICATES NEW BREAKER AND CIRCUIT SHALL REPLACE EXISTING.

**EXIST. PANEL L2 SCHEDULE (SEC 1)**

600A M.L.O. 480Y/277V 3ø 4W 22,000 AIC RATING

CKT NO.	LOAD DESCRIPTION	BREAKER POLE	AMP	KVA	BREAKER AMP	POLE	LOAD DESCRIPTION	CKT NO.
1	LTS RM 165,167,168	(E)	1	20	2.4	0.9	2.3 1	LTS RM 152 (E) 2
3	LTS CR. 164	(E)	1	20	3.4	0.4	20 1	LTS OFFICES, HALL, MAIL RM (N) 4
5	LTS CORRIDOR	(E)	1	20	3.9	3.3	20 1	LTS RM 151,152,166 (E) 6
7	LTS CORRIDOR	(E)	1	20	2.5	3.7	20 1	LTS RM 150 (E) 8
9	LTS BATHROOMS, RM 154	(E)	1	20	2.6	3.2	20 1	LTS CR. 104 (E) 10
11	LTS RMS 220,221,261,MEZZ	(E)	1	20	3.0	2.3	20 1	LTS CR. 108, RM. 101 (E) 12
13	LTS GYM	(E)	1	20	2.3	2.8	20 1	LTS CR. 225 (E) 14
15	LTS GYM	(E)	1	20	2.3	3.5	20 1	LTS RM. 236 (E) 16
17	LTS GYM	(E)	1	20	2.3	2.8	20 1	LTS CR. 229 (E) 18
19	LTS GYM	(E)	1	20	2.3	2.0	20 1	LTS RM. 231,242 (E) 20
21	LTS GYM	(E)	1	20	2.3	3.0	20 1	LTS RMS 249 THRU 252 (E) 22
23	LTS RM. 260	(E)	1	20	2.3	3.1	20 1	LTS RM. 245 (E) 24
25	SPARE	(E)	1	20	-	2.3	20 1	LTS CR. 222 (E) 26
27	SPARE	(E)	1	20	-	-	-	SPACE (E) 28
29	SPARE	(E)	1	20	-	-	-	SPACE (E) 30
31	AHU#2	(E)	3	60	7.5	7.5	60 3	AHU#3 (E) 32
33								34
35								36

CONNECTED LOAD 79.9 KVA

(E) INDICATES EXISTING BREAKER AND CIRCUIT SHALL REMAIN.  
(N) INDICATES NEW BREAKER AND CIRCUIT SHALL REPLACE EXISTING.




PROJ. MGR.:	A. VARGHESE
DRAWN:	C. PAGE
DATE:	03/25/26
REVISIONS	
#1	04/17/26 DCM COMMENTS

JOB NO. 25-160B

SHEET NO:

E5.0

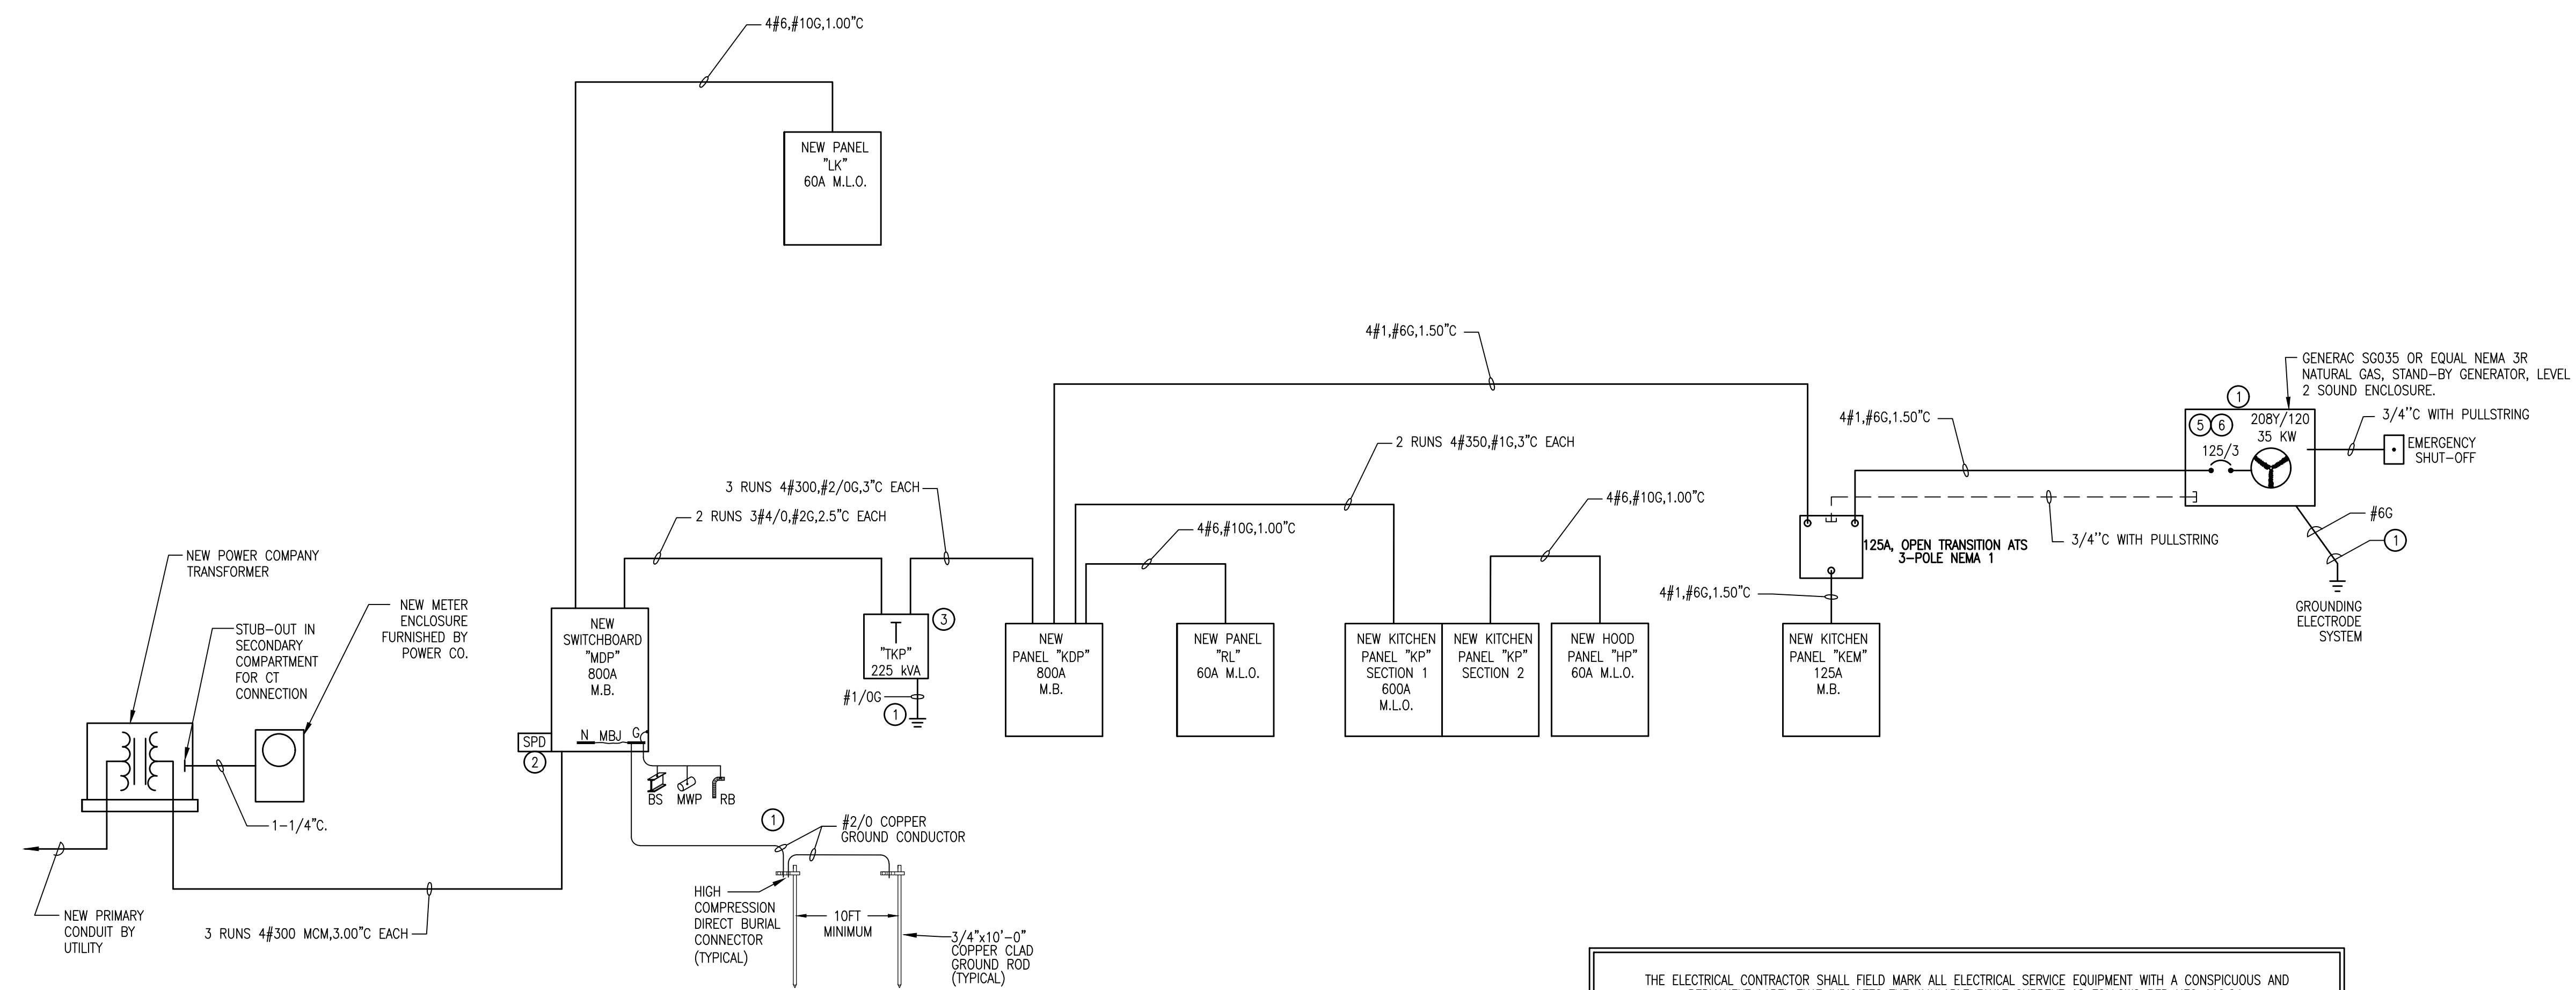

**ELECTRICAL SINGLE LINE DIAGRAM**

SCALE: NOT TO SCALE

**ELECTRICAL SINGLE LINE DIAGRAM: GENERAL NOTE**

1. CONTRACTOR SHALL ADD 30,000\$ TO THE BID PRICING FOR ELECTRICAL SERVICE RELATED COSTS.

**SINGLE LINE DIAGRAM KEYNOTES:**

- ① GROUNDING ELECTRODE SYSTEM SHALL BE IN ACCORDANCE WITH NEC 2020 ARTICLE 250.
- ② PROVIDE EXTERNAL, SERVICE ENTRANCE RATED, CATEGORY-C SURGE PROTECTION DEVICE, 10-MODE, 240KA PER PHASE.
- ③ TRANSFORMER SHALL BE INSTALLED WITH A CLASS 155 OR HIGHER INSULATION SYSTEM IN ACCORDANCE WITH NEC 450.21 (B) FOR CODE COMPLIANT INSTALLATION IN A ROOM THAT DOES NOT HAVE A MINIMUM FIRE RATING OF (1) HOUR.
- ④ NOT USED.
- ⑤ COORDINATE WITH GENERATOR INSTALLER FOR LOAD STEP SEQUENTIAL STARTING REQUIREMENTS. LIGHTING AND MISCELLANEOUS LOADS SHALL BE LOAD STEP #1, COOLER SHALL BE LOAD STEP #2, AND FREEZER SHALL BE LOAD STEP #3. PROVIDE ALL HARDWARE AND CONNECTIONS AS FOR LOAD SEQUENCING AS RECOMMENDED BY GENERATOR INSTALLER.
- ⑥ PROVIDE LIGHT FIXTURES AND 120V 20A GFCI MAINTENANCE RECEPTACLE INSIDE GENERATOR ENCLOSURE. PROVIDE ALL CONNECTIONS AS REQUIRED FOR BATTERY CHARGER, BLOCK HEATER, LIGHTS, AND RECEPTACLE FROM GENERATOR TO EMERGENCY PANEL; SEE PANEL SCHEDULE.

THE ELECTRICAL CONTRACTOR SHALL FIELD MARK ALL ELECTRICAL SERVICE EQUIPMENT WITH A CONSPICUOUS AND PERMANENT LABEL THAT INDICATES THE AVAILABLE FAULT CURRENT AS FOLLOWS PER NEC 110.24:

"Panel XX"  
"Maximum available fault current = ### Amps"  
"Month DD, Year"

THE LABEL SHOULD BE OF SUFFICIENT DURABILITY TO WITHSTAND THE ENVIRONMENT INVOLVED.

THE ELECTRICAL CONTRACTOR SHALL FIELD MARK ALL PANEL BOARDS IN AREA OF WORK THAT ARE TO REMAIN TO INDICATE ORIGIN OF POWER SUPPLY.

NOTE: ALL EQUIPMENT THAT IS LIKELY TO REQUIRE EXAMINATION, ADJUSTMENT, SERVICING, OR MAINTENANCE WHILE ENERGIZED SHALL BE PROVIDED WITH A LABEL IN ACCORDANCE WITH NEC 110.16. THE EQUIPMENT MANUFACTURER SHALL PROVIDE AN ARC FLASH HAZARD ANALYSIS TO DETERMINE THE LEVEL OF PERSONAL PROTECTIVE EQUIPMENT (PPE) REQUIRED FOR EACH PIECE OF EQUIPMENT. LABEL SHALL INCLUDE:


1. AT LEAST ONE OF THE FOLLOWING:
  - A. AVAILABLE INCIDENT ENERGY AND THE CORRESPONDING WORKING DISTANCE
  - B. MINIMUM ARC RATING OF CLOTHING
  - C. REQUIRED LEVEL OF PPE
  - D. HIGHEST HAZARD/RISK CATEGORY (HRC) FOR THE EQUIPMENT
2. NOMINAL SYSTEM VOLTAGE
3. ARC FLASH BOUNDARY

ELECTRICAL CONTRACTOR SHALL COORDINATE WITH MECHANICAL CONTRACTOR TO ENSURE THE OVER CURRENT PROTECTION FOR THE SPECIFIC HVAC EQUIPMENT MEETS THE MANUFACTURER AND THE NATIONAL ELECTRICAL CODE REQUIREMENTS.

THE ELECTRICAL CONTRACTOR SHALL FIELD MARK ALL PANEL BOARDS WITH ORIGIN OF POWER SUPPLY, VIA MECHANICALLY FASTENED PHEENOLIC LABEL.

THE ELECTRICAL CONTRACTOR SHALL DISTINCTLY LABEL ALL SERVICES FOR EACH BUILDING ON THE PROPERTY SUCH THAT THEY CORRESPOND WITH THE RESPECTIVE BUILDING THEY SERVE. FOR EXAMPLE, IF THERE ARE TWO BUILDINGS AND SERVICES, THEY SHALL BE LABELED AS "BUILDING 1 OF 2", "BUILDING 2 OF 2".




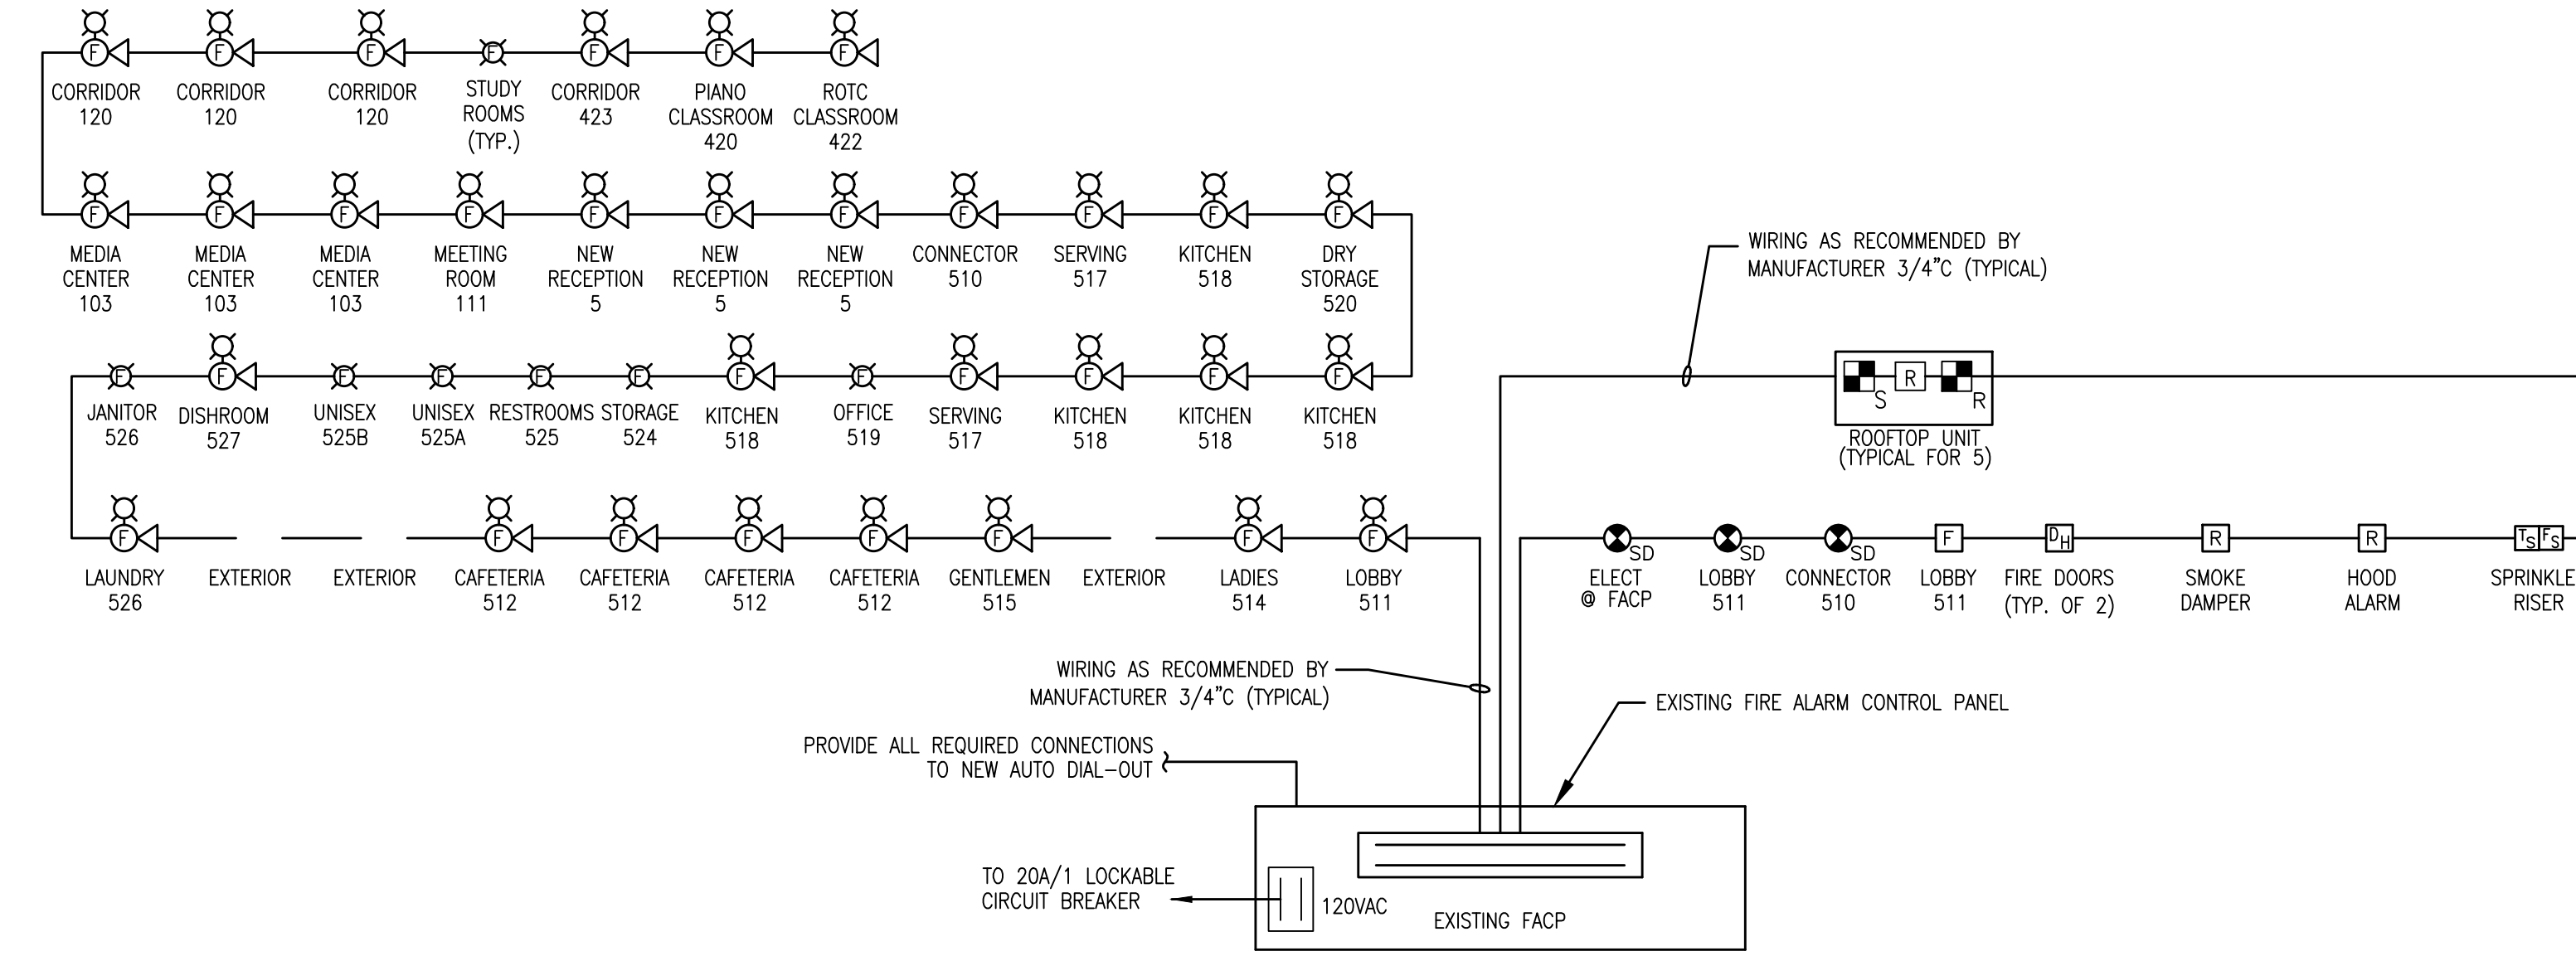

**FIRE ALARM SYSTEM RISER DIAGRAM**  
NOT TO SCALE

**FIRE ALARM SYSTEM GENERAL NOTES:**

- VERIFY EXACT NUMBER OF DEVICES FROM FLOOR PLAN, NOT RISER DIAGRAM.
- THE NAC CIRCUITS ARE SHOWN DIAGRAMATIC. MAXIMUM NUMBER OF DEVICES ON ANY CIRCUIT IS LIMITED. PROVIDE ADDITIONAL HARDWARE AS REQUIRED.
- SLC LOOP TO CONNECT ALL FIRE ALARM SYSTEM DEVICES FROM FLOOR PLANS. PROVIDE ADDITIONAL LOOP(S) AS REQUIRED.
- BATTERY CABINETS AND NAC EXPANDERS SHALL BE LOCATED BELOW OR ADJACENT TO FIRE ALARM CONTROL PANEL.
- ALL FIRE ALARM WORK SHALL BE PERFORMED BY QUALIFIED PERSONNEL AS DEFINED IN NFPA 72 (LATEST EDITION) SECTION(S) 4.3.3 AND 4.4.4.2. SHOP DRAWINGS SHALL COMPLY WITH NFPA 72 SECTION 4.5.1.1.
- SPLICING OF FIRE ALARM WIRING IS STRICTLY PROHIBITED.
- UPON PROJECT COMPLETION THE CAMPUS WIDE FIRE ALARM SYSTEM SHALL BE RECERTIFIED AND TESTED. PROVIDE WITH A RECORD OF COMPLETION AS REQUIRED IN NFPA 72 SECTION 4.5.2.
- THE FIRE ALARM INSTALLER SHALL BE LICENSED AS A CERTIFIED FIRE ALARM CONTRACTOR. THE CONTRACTOR MUST HAVE A NICET LEVEL III TECHNICIAN IN A POSITION OF RESPONSIBILITY, AND THE LICENSE SHALL BE ISSUED IN THE NAME OF THE CERTIFICATE HOLDER AND THE CONTRACTOR. TECHNICIANS WORKING FOR THE CERTIFIED CONTRACTOR MUST HOLD A CURRENT NICET LEVEL II, OR EQUIVALENT, CERTIFICATION. CONTRACTORS WISHING TO BID ON FIRE ALARM WORK SHALL SHOW EVIDENCE AT THE PRE-BID CONFERENCE THAT HE/SHE MEETS THE CERTIFICATION REQUIREMENTS AND HOLD A PERMIT ISSUED BY THE STATE OF ALABAMA FIRE MARSHAL.
- THE FIRE ALARM SYSTEM SHALL BE MONITORED BY AN APPROVED SUPERVISING STATION IN ACCORDANCE WITH NFPA 72. AUTOMATIC TELEPHONE DIALING DEVICES USED TO TRANSMIT AN EMERGENCY ALARM SHALL NOT BE CONNECTED TO ANY FIRE DEPARTMENT TELEPHONE NUMBER UNLESS APPROVED BY THE FIRE CHIEF.

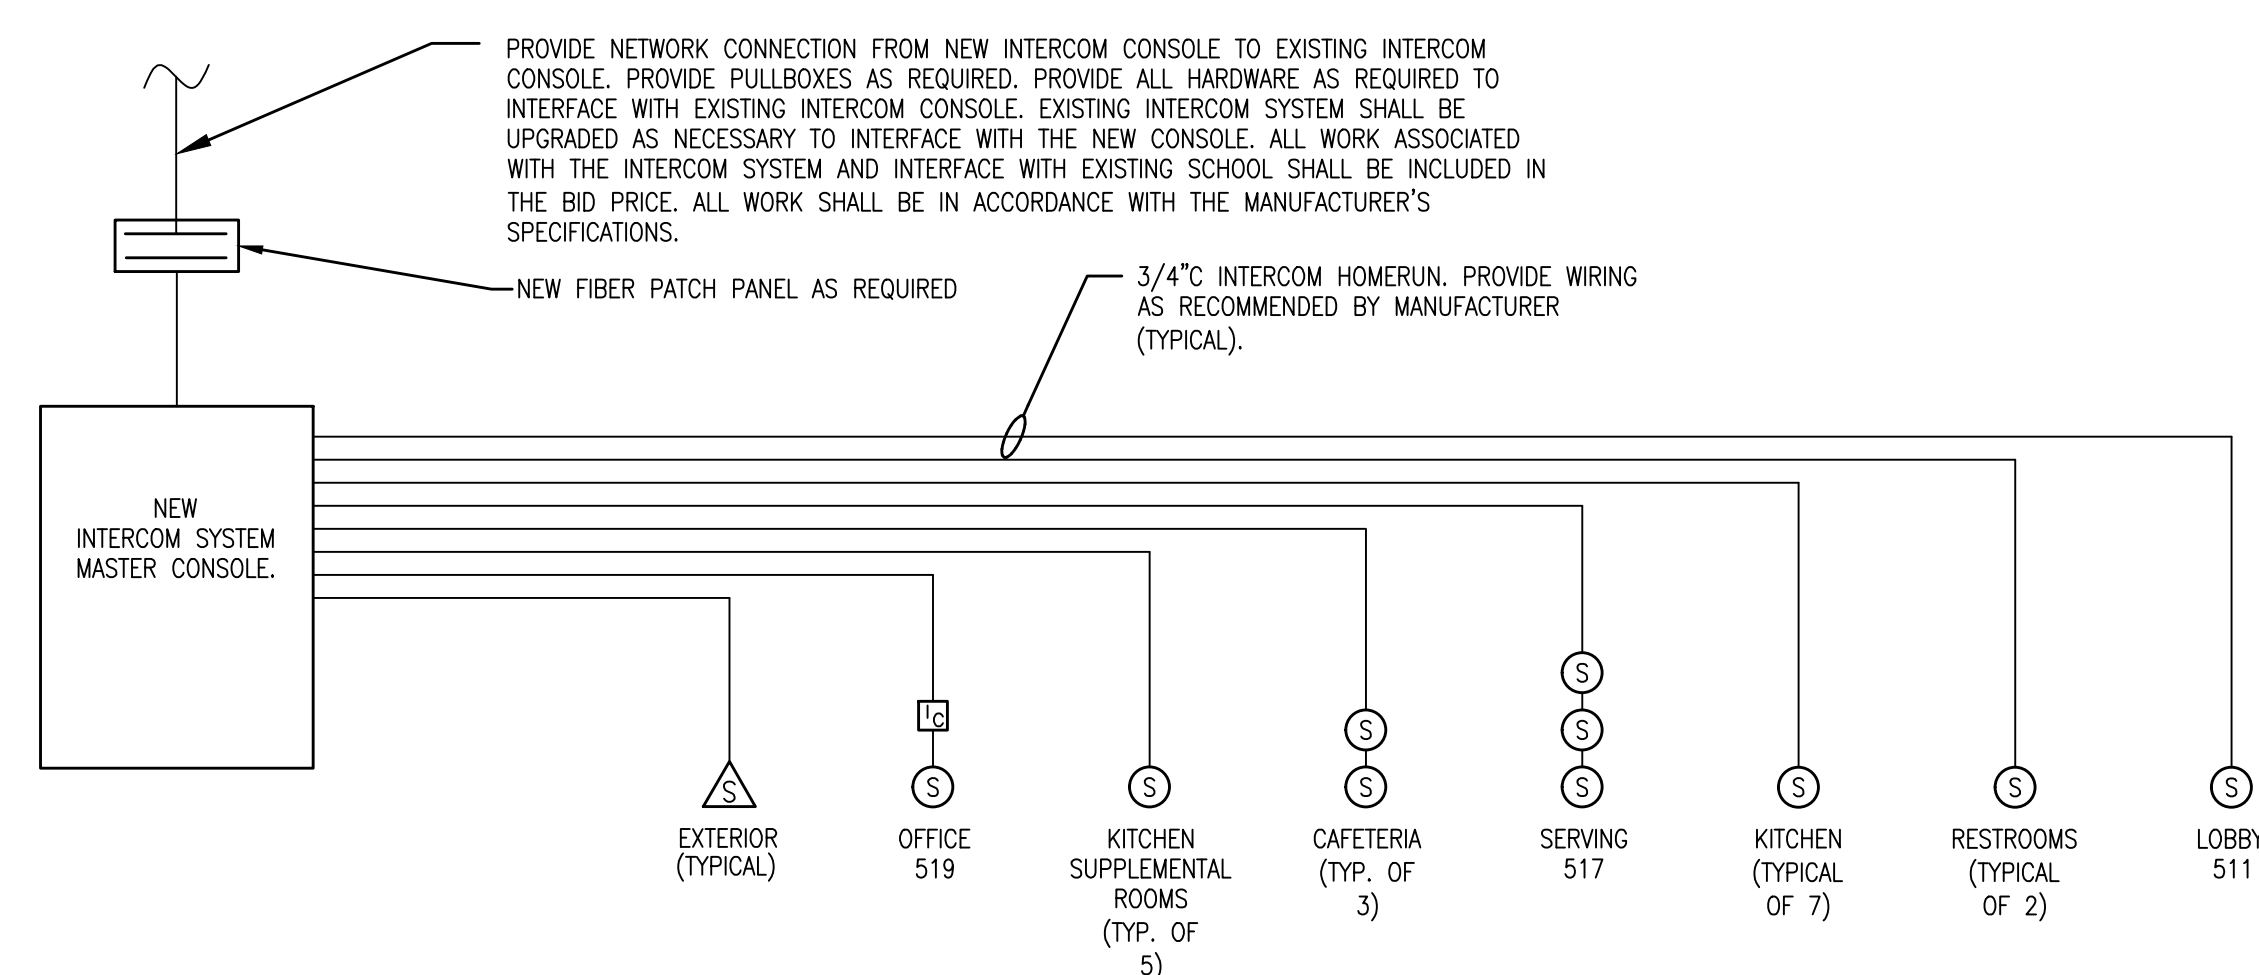


**INTERCOM RISER DIAGRAM**  
NOT TO SCALE

**GENERAL NOTE:**

- VERIFY EXACT NUMBER OF DEVICES FROM FLOOR PLAN, NOT RISER.

SHEET TITLE: INTERCOM AND FIRE ALARM RISER DIAGRAMS

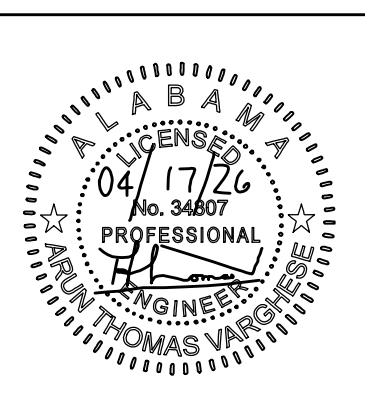




PROJ. MGR.:	A. VARGHESE
DRAWN:	C. PAGE
DATE:	03/25/26
REVISIONS	
#1	04/17/26 DCM COMMENTS

JOB NO. 25-160B


SHEET NO:

**E5.1**

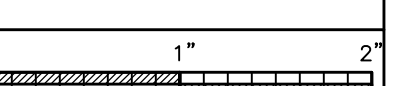


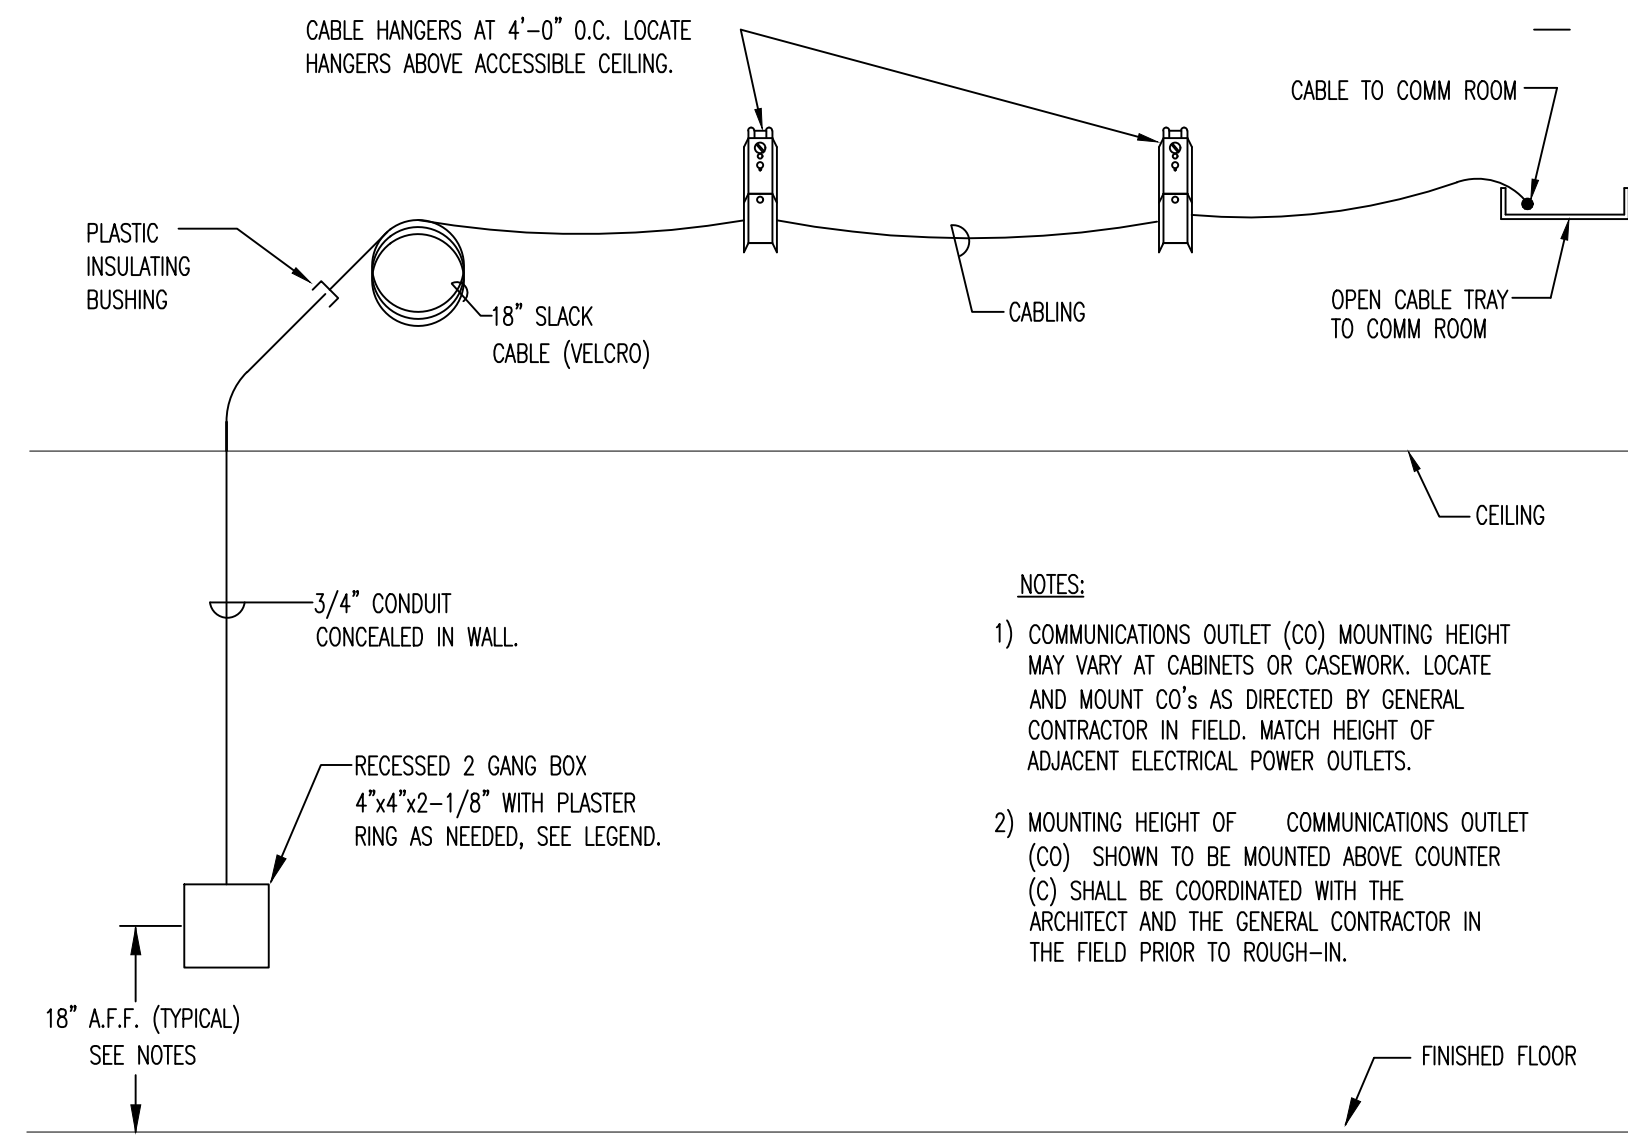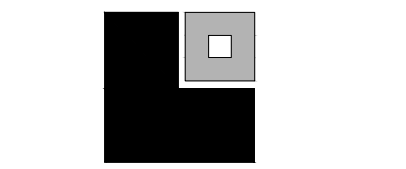


**TYPICAL COMMUNICATIONS OUTLET  
ROUGH-IN MOUNTING DETAIL**  
NOT TO SCALE

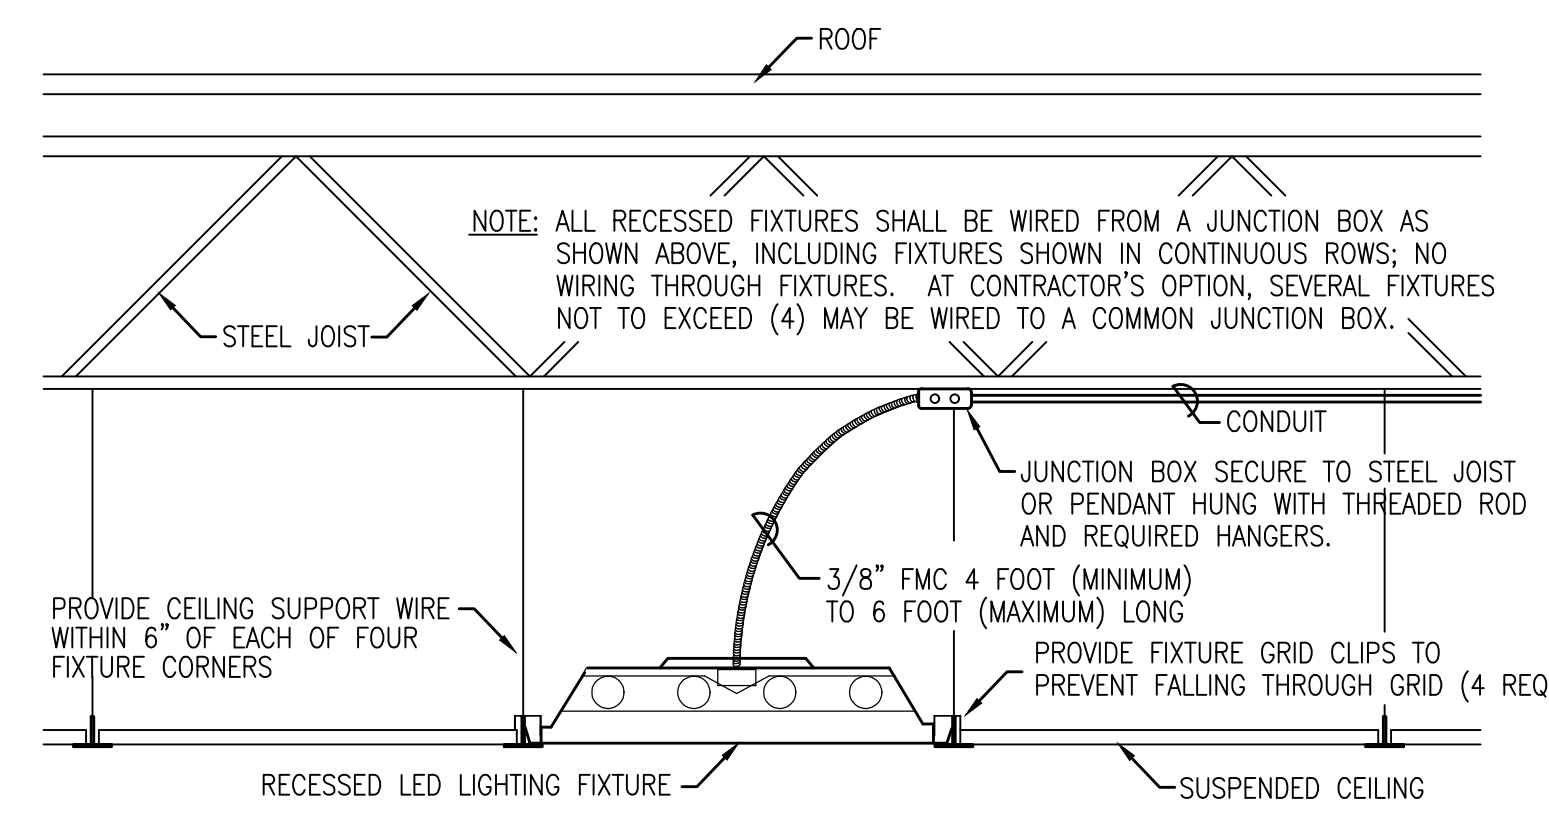


**TYPICAL RECESSED FIXTURE INSTALLATION DETAIL**  
NOT TO SCALE

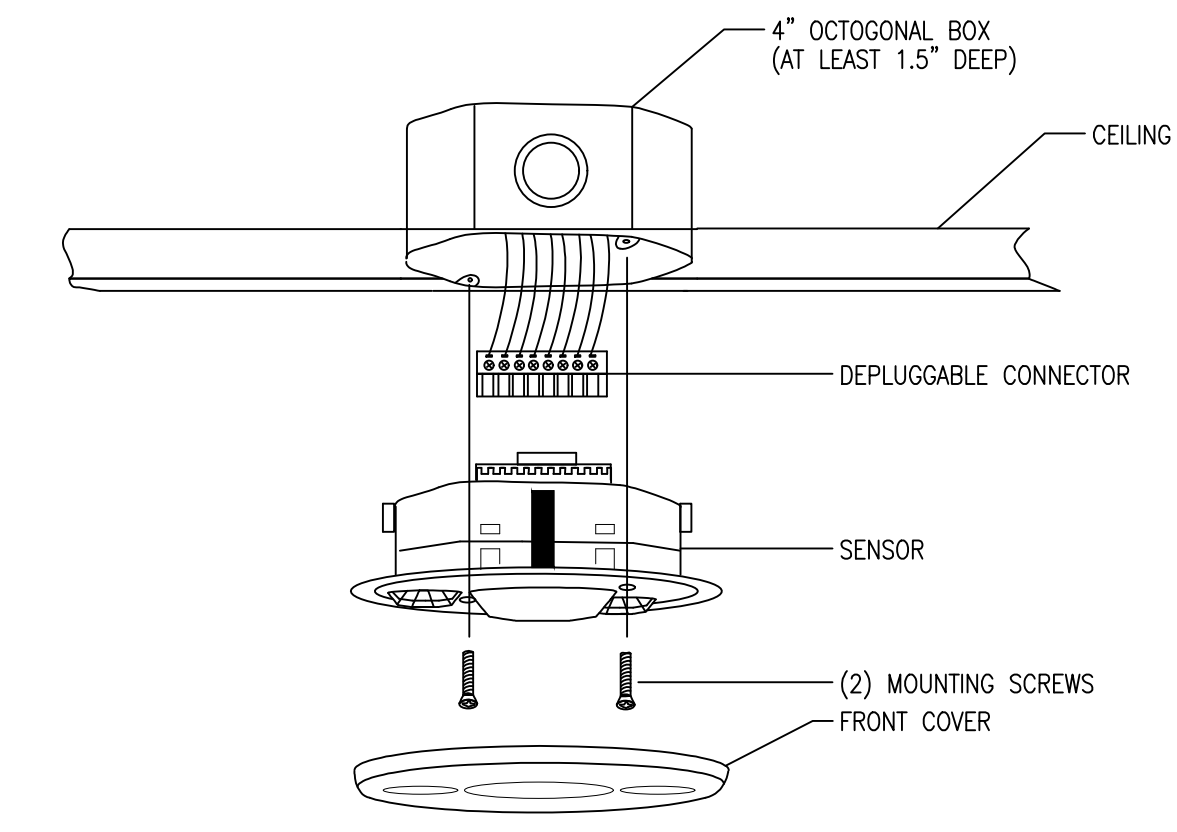


**DUAL TECHNOLOGY MOUNTING  
DETAIL - CEILING MOUNT**  
NOT TO SCALE

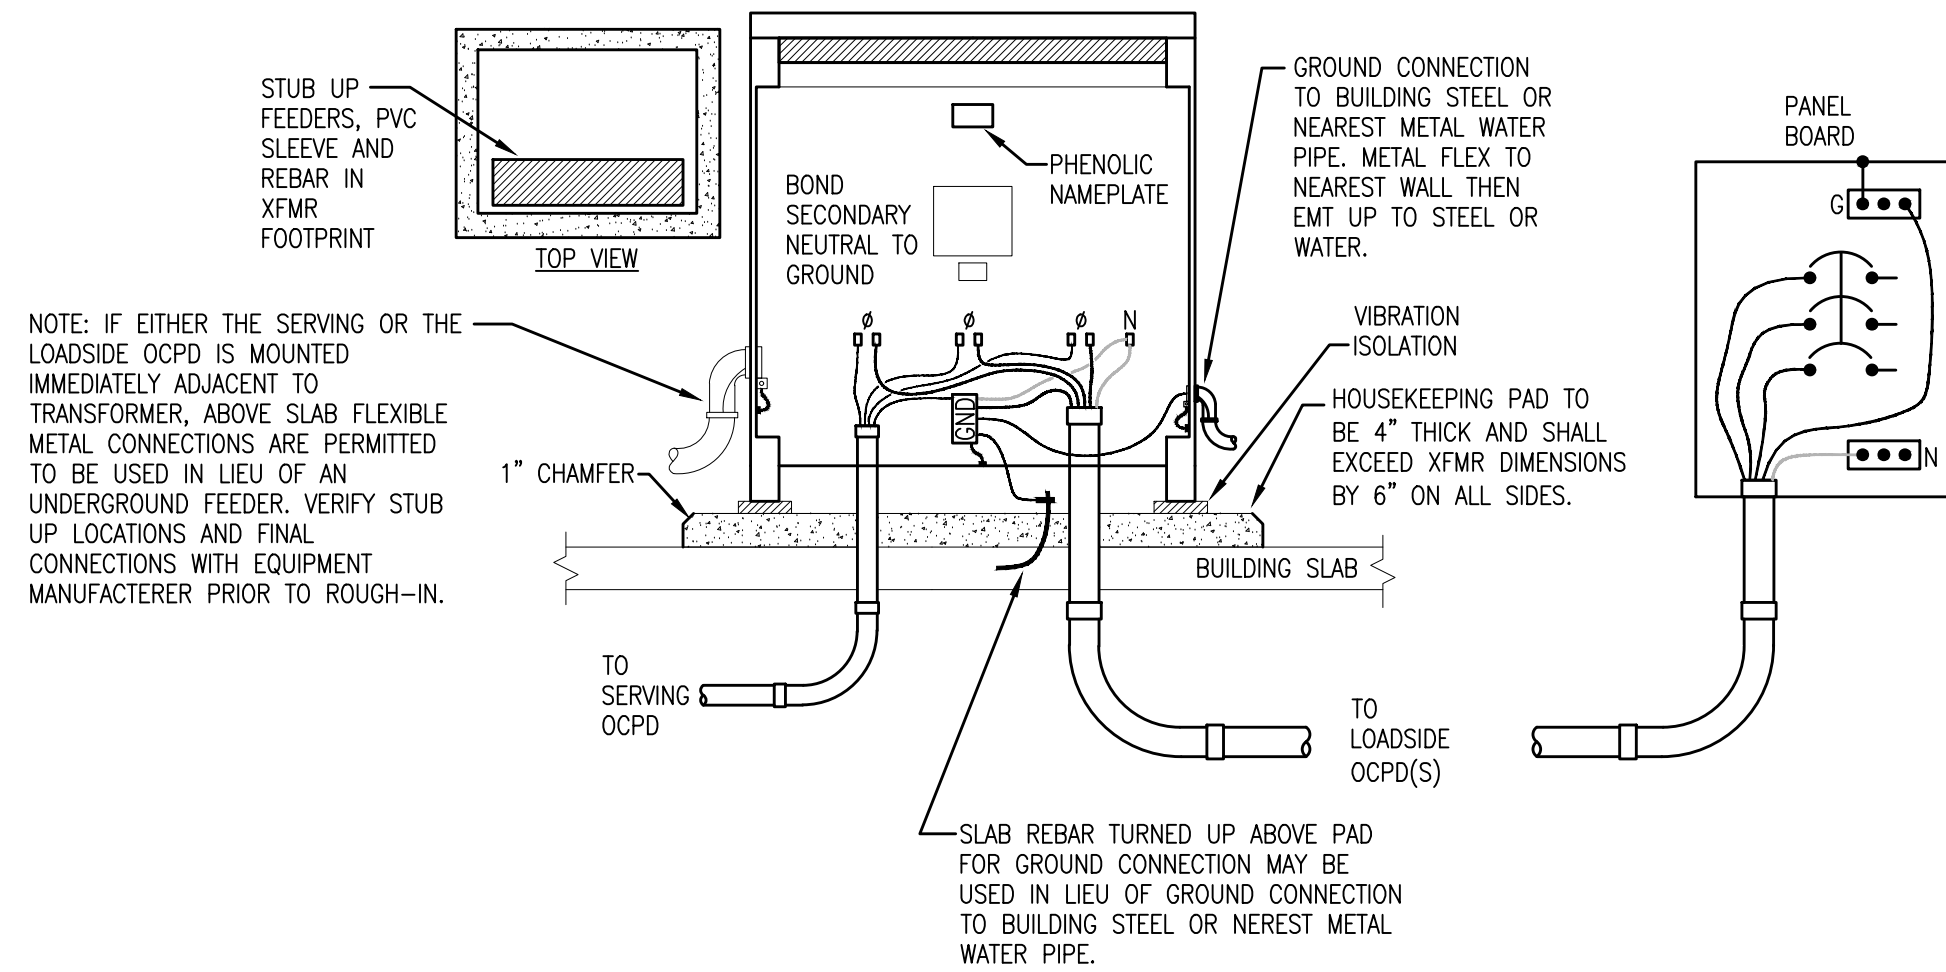


**FLOOR MOUNTED TRANSFORMER DETAIL**  
NOT TO SCALE

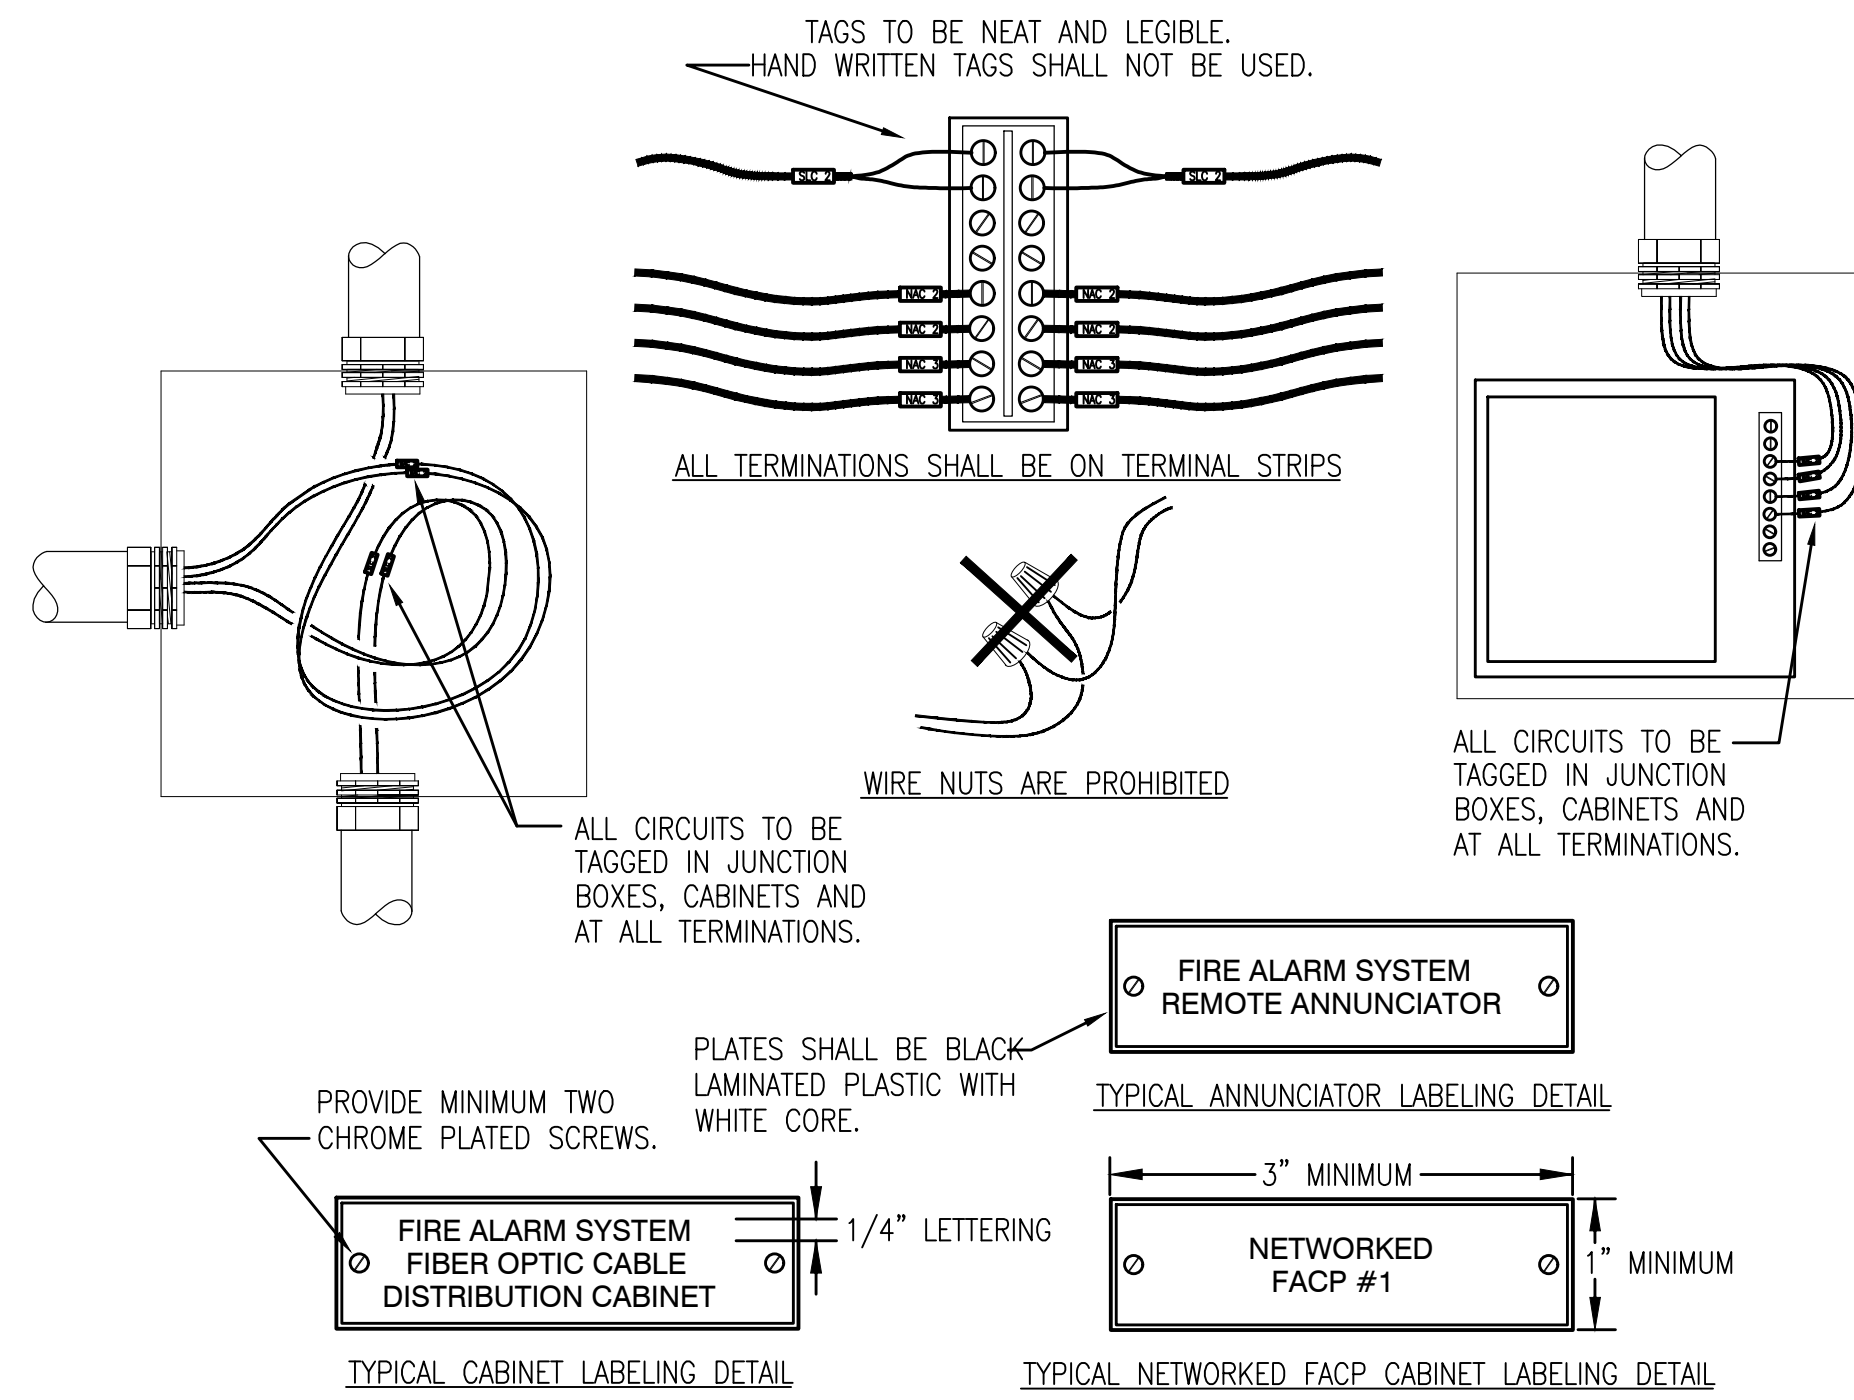


**FIRE ALARM SYSTEM LABELING DETAIL**  
NOT TO SCALE

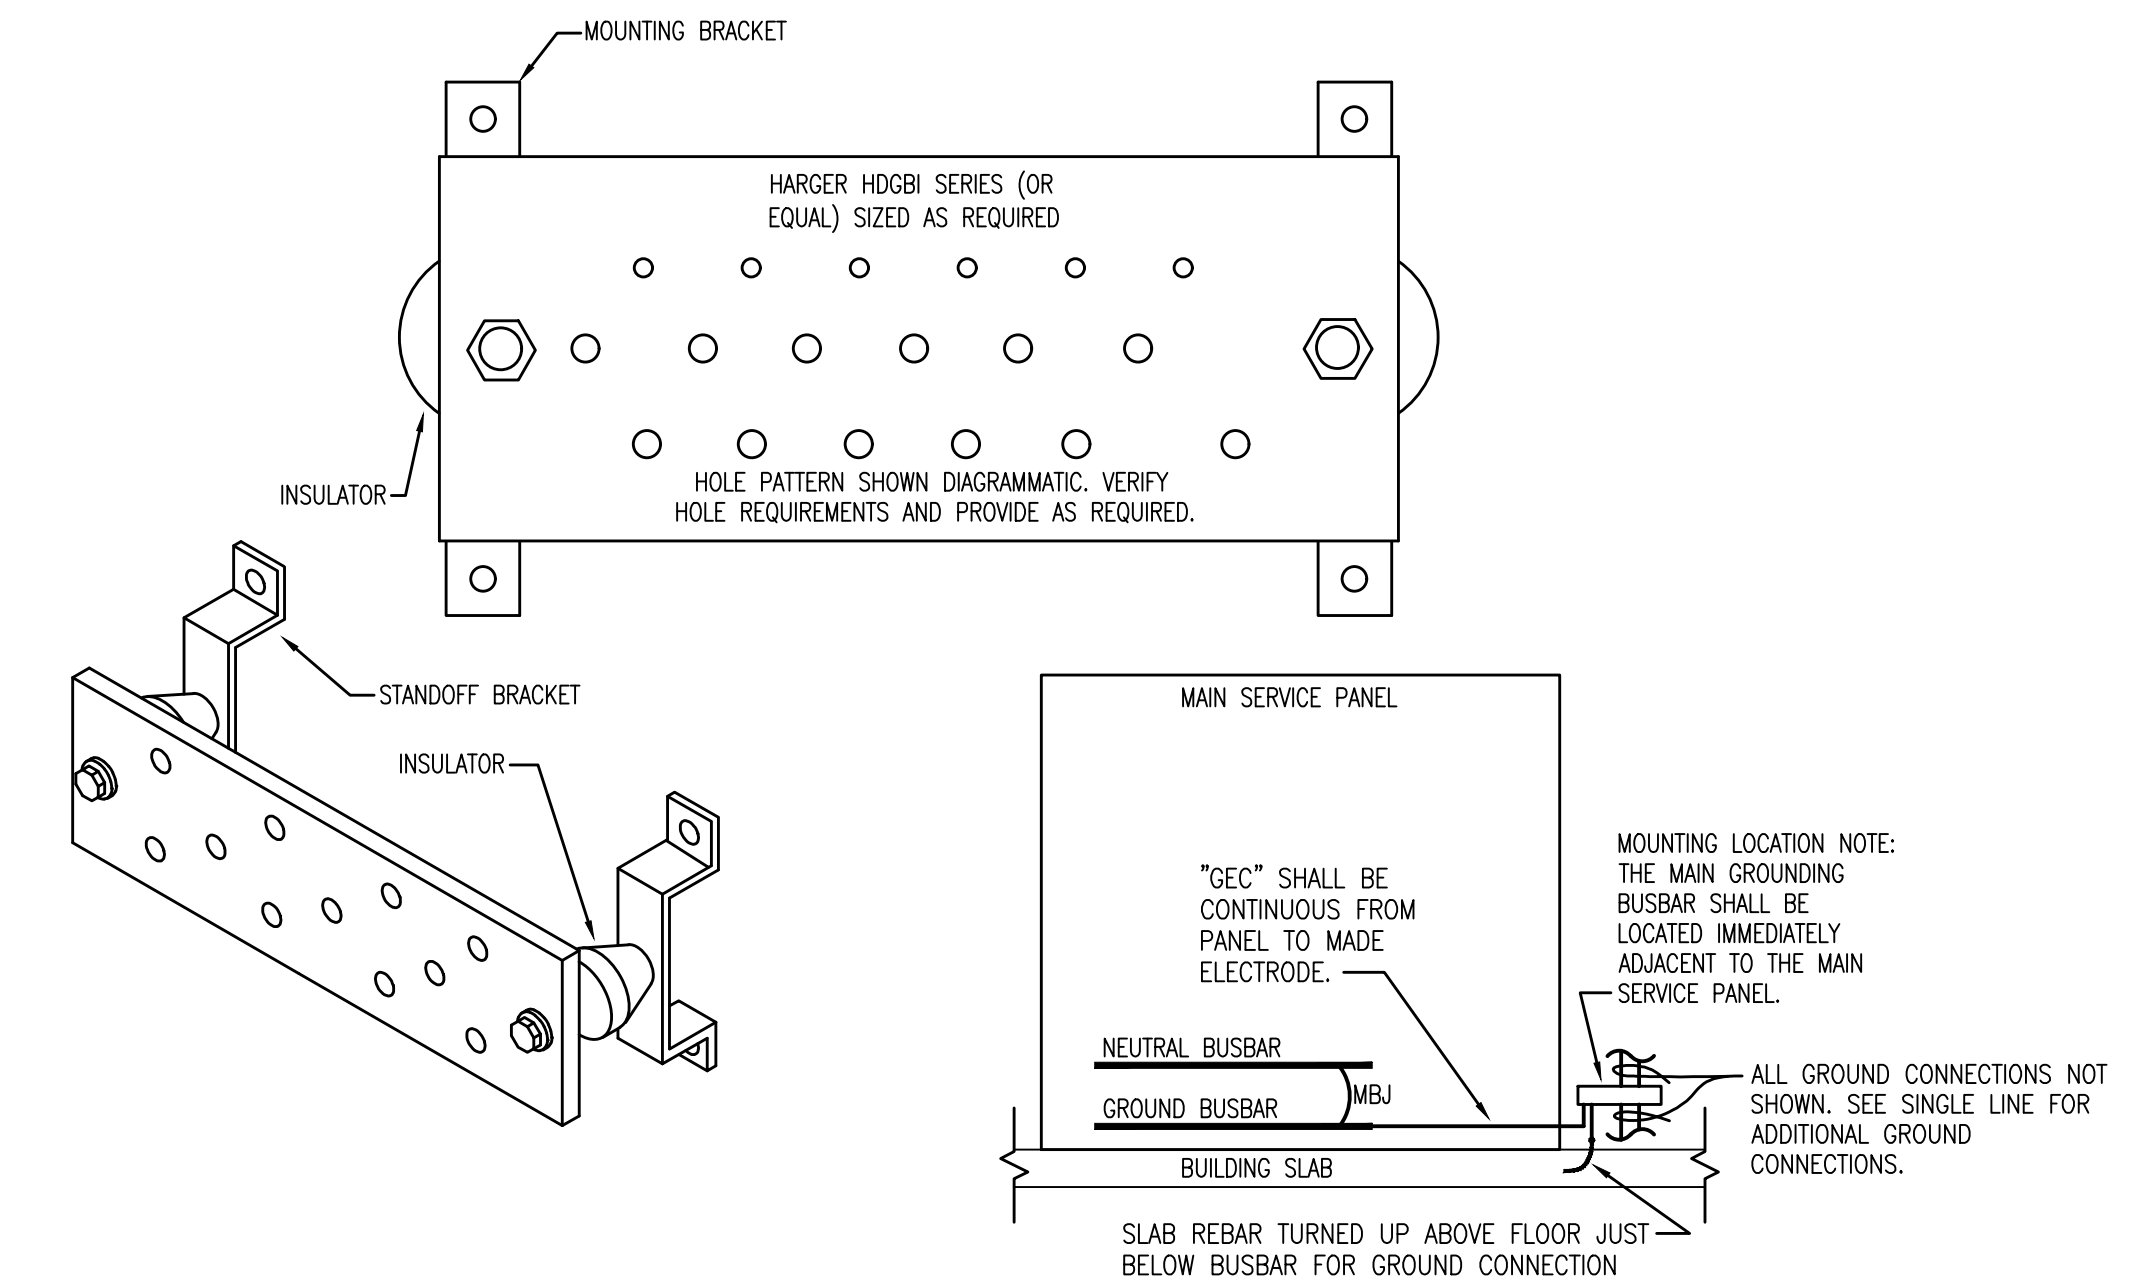

**MAIN GROUNDING BUSBAR DETAIL**  
NOT TO SCALE

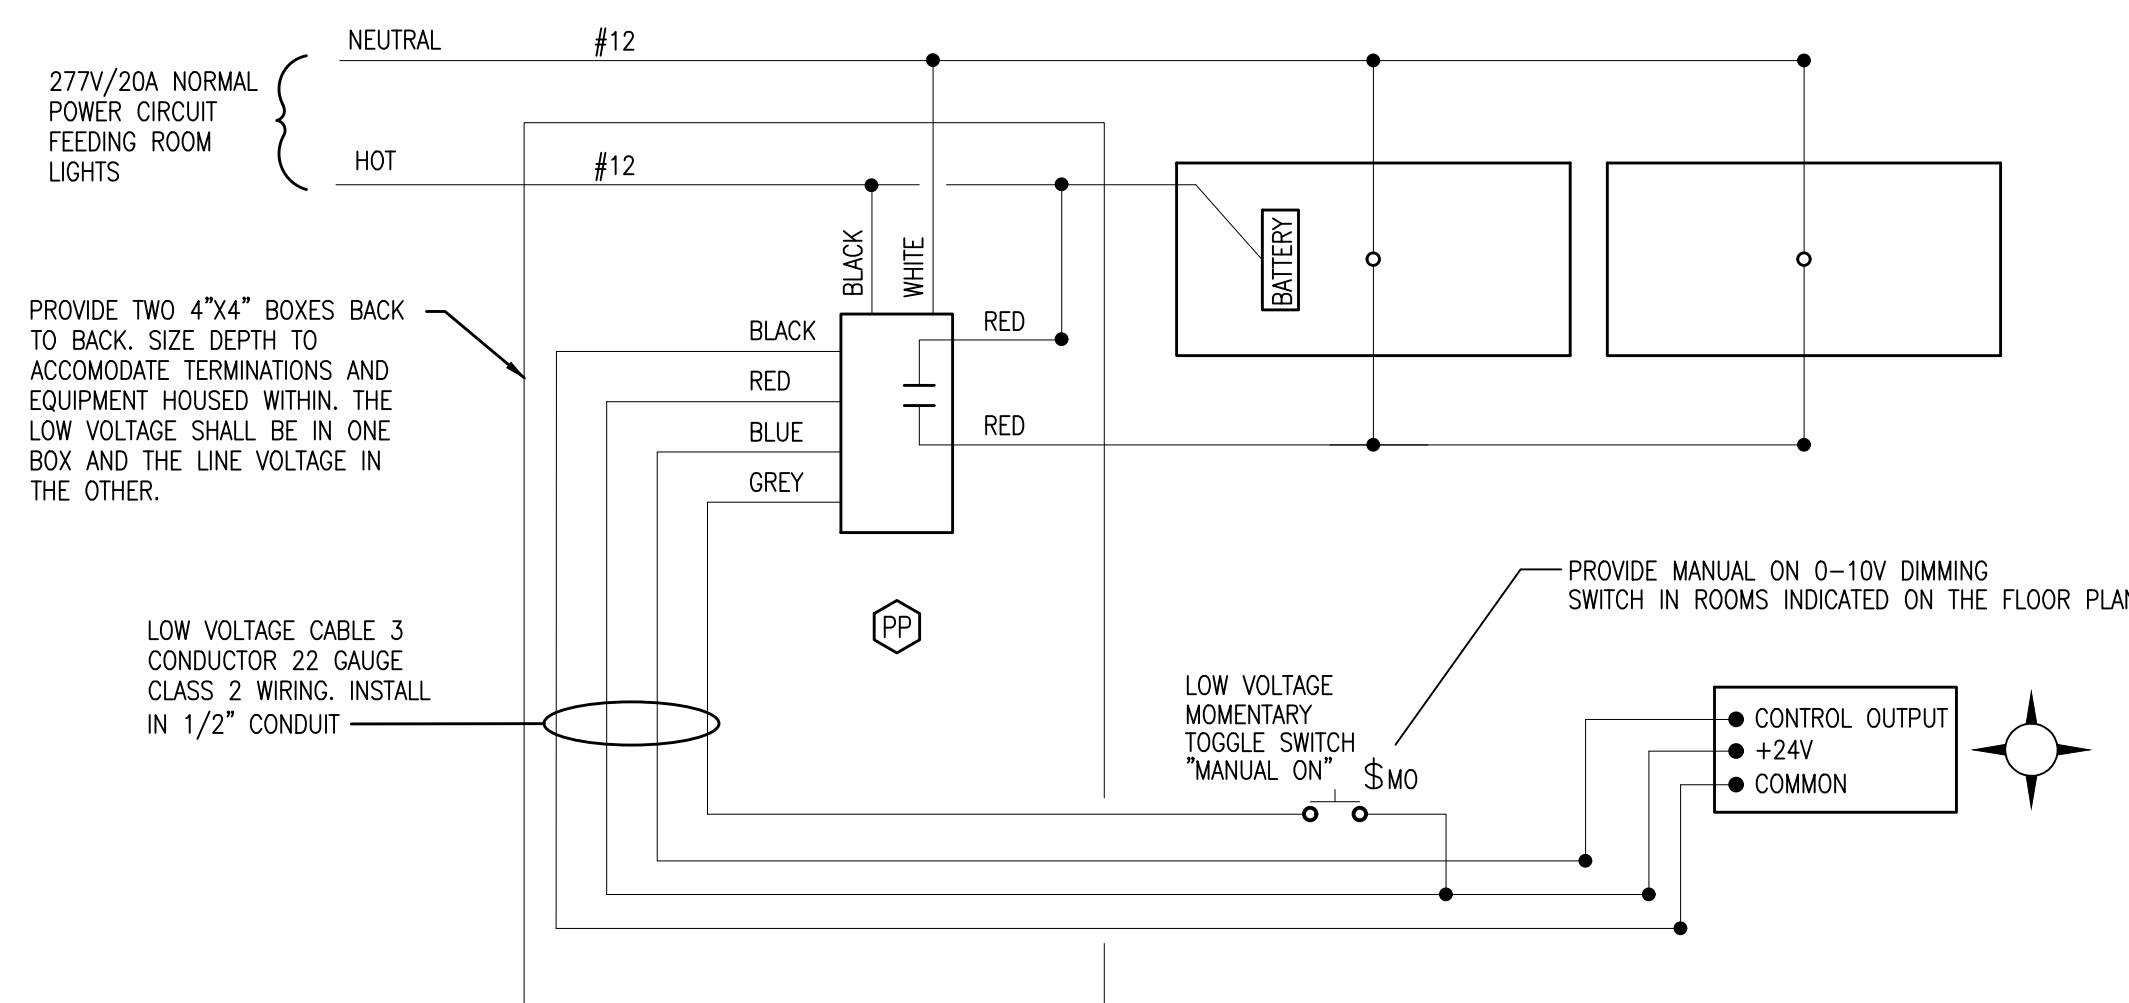


**TYPICAL OCCUPANCY SENSOR WIRING DIAGRAM**  
NOT TO SCALE

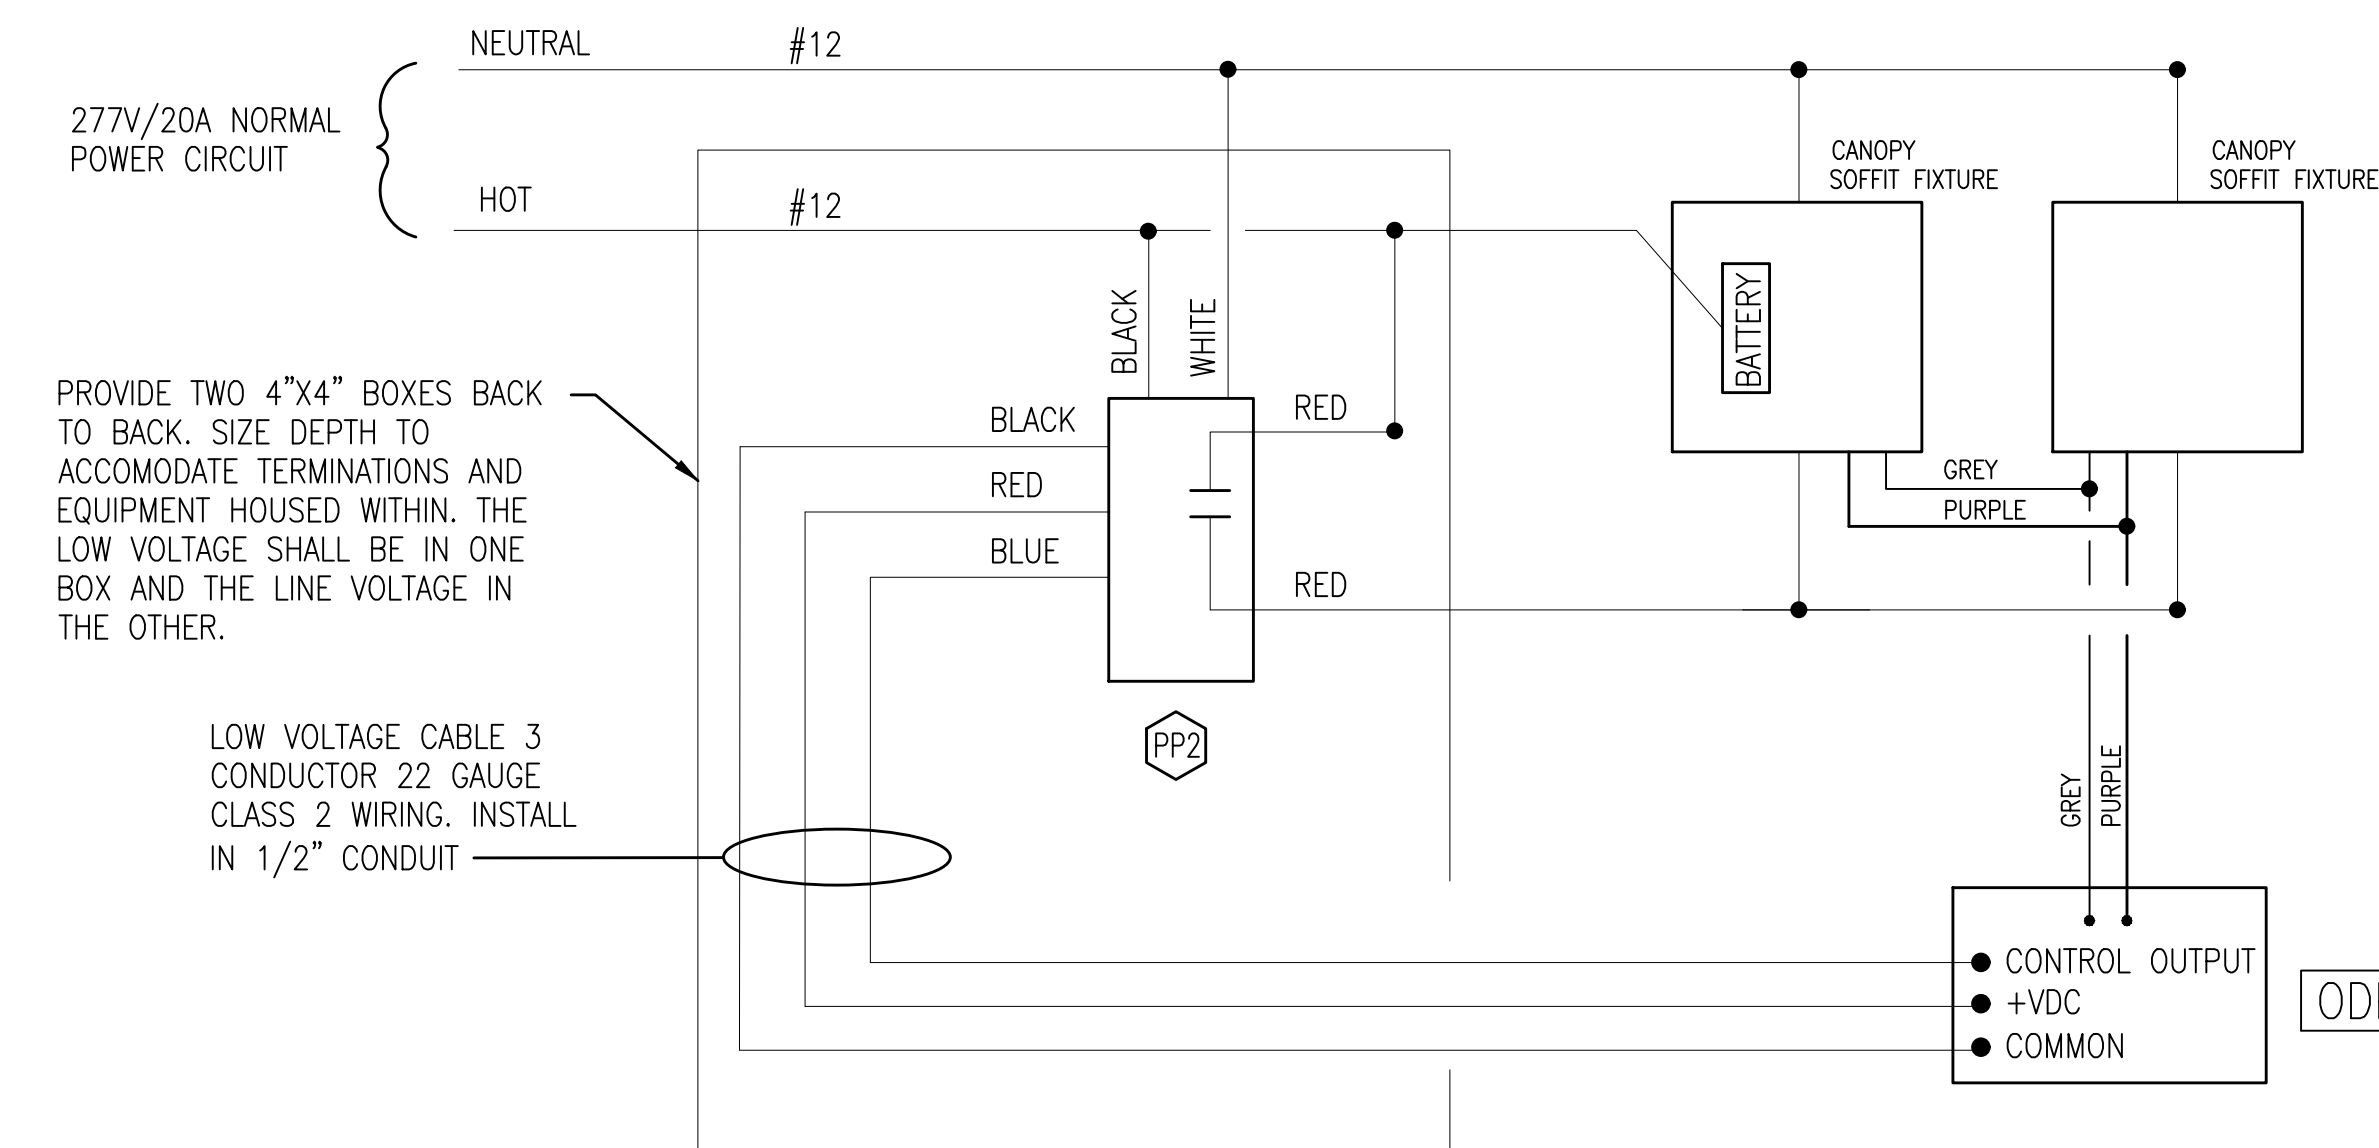

**CANOPY SOFFIT FIXTURE CONTROL DIAGRAM**  
NOT TO SCALE

SHEET TITLE: ELECTRICAL DETAILS

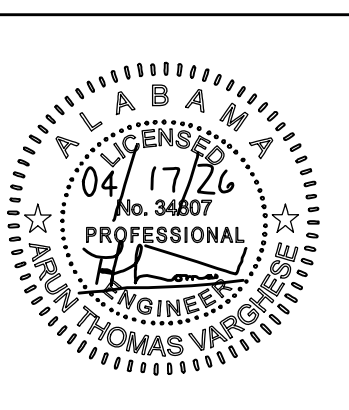

PROJ. MGR.: A. VARGHESE
DRAWN: C. PAGE
DATE: 03/25/26
REVISIONS
#1 04/17/26 DCM COMMENTS


JOB NO. 25-160B


SHEET NO:

E6.0



H.M. YONGE & ASSOCIATES, INC.  
CONSULTING ENGINEERS / EST. 1988  
51 EAST GREGORY STREET PENSACOLA, FLORIDA 32502  
253 ST. ANTHONY STREET MOBILE, ALABAMA 36603  
PHONE: (904)384-2061 PHONE: (251)690-7465

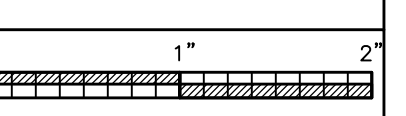

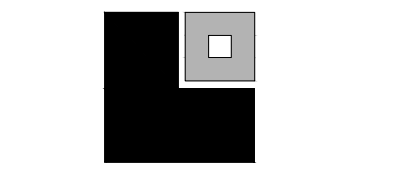


**DEMOLITION PLAN NOTES:**

1. THE ELECTRICAL CONTRACTOR IS RESPONSIBLE FOR SECURING ALL DEVICES, FIXTURES, WIRES, CONDUIT, ETC. ABOVE THE CEILING PRIOR TO CEILING DEMOLITION. THE ELECTRICAL CONTRACTOR IS RESPONSIBLE FOR DAMAGE CAUSED TO SUCH MATERIALS DURING THE CEILING DEMOLITION PHASE.
2. EXACT LOCATIONS FOR EXISTING MECHANICAL UNITS, DEVICES AND BOXES ARE TO BE FIELD VERIFIED.
3. ALL PENETRATIONS (NEW AND EXISTING) OF THE FIRE RATED BARRIERS SHALL BE FIRE STOPPED USING U.L. APPROVED METHODS AND MATERIALS.
4. ALL EXISTING PANELS ARE TO REMAIN (UNLESS OTHERWISE NOTED). THE ELECTRICAL CONTRACTOR IS TO VERIFY THE BREAKER SIZES, WIRE SIZES, PANEL SIZES, AND PANEL LOADS IN THE FIELD. ALL PANELS ARE TO BE COMPLETELY LABELED AND UPDATED DIRECTORIES INSTALLED. ALL PANELS ARE TO BE PROPERLY GROUNDED PER THE NATIONAL ELECTRIC CODE.
5. TERMINATED CIRCUITS THAT ARE NOT USED ON THE NEW WORK PLANS SHALL BE LABELED WITH THE SERVING PANEL AND CIRCUIT NUMBER CLEARLY MARKED ON THE TERMINATING JUNCTION BOX.
6. THE PHASING OF ALL WORK IS TO BE COORDINATED WITH OTHER CONTRACTORS (GENERAL, MECHANICAL, ETC.) PRIOR TO PROJECT COMMENCEMENT.
7. THE ELECTRICAL CONTRACTOR IS TO PROVIDE AND INSTALL JUNCTION BOX COVERS AS REQUIRED. ALL WIRE IN THE AREA OF WORK IS TO BE INSTALLED PROPERLY UPON COMPLETION OF THE PROJECT.
8. THE ELECTRICAL CONTRACTOR IS RESPONSIBLE FOR KEEPING ALL DEVICES, LIGHT FIXTURES AND OTHER EQUIPMENT TO REMAIN ACTIVE - CIRCUITS ASSOCIATED WITH BOTH REMOVED ELECTRICAL WORK AND ELECTRICAL WORK TO REMAIN ARE TO BE EXTENDED WITH WIRE, CONDUIT, BOXES, ETC. (SIZE TO MATCH EXISTING) TO KEEP THE WORK TO REMAIN ACTIVE.
9. **THE CONTRACTOR SHOULD MAINTAIN THE INTEGRITY OF THE FIRE ALARM SYSTEM IN THE FACILITY AND IN THE CONSTRUCTION AREA AT ALL TIMES.**

**LIGHTING DEMOLITION PLAN KEY NOTES:**

1. EXISTING LIGHT FIXTURE SHALL BE REMOVED, ALONG WITH ASSOCIATED CONDUIT AND WIRING. SEE NEW WORK PLAN FOR MORE INFORMATION.
2. EXISTING SWITCHES SERVING EXISTING LIBRARY SHALL BE REMOVED. INCLUDE WITH REMOVAL THE DEMOLITION OF EXISTING CONTROL WIRING AND CONTROLS CONDUIT FEEDING LIGHT CIRCUITS BEING SERVED BY SWITCHES.
3. EXISTING SWITCH SERVING ROOM SHALL BE REMOVED. INCLUDE WITH REMOVAL THE DEMOLITION OF EXISTING CONTROL WIRING AND CONTROLS CONDUIT FEEDING LIGHT CIRCUITS BEING SERVED BY SWITCHES.
4. EXISTING LIGHTS SHALL REMAIN. PROTECT DURING CONSTRUCTION.
5. EXISTING FIXTURES SHALL REMAIN CONNECTED TO EXISTING CIRCUITRY. EXISTING CIRCUITRY SHALL BE MODIFIED TO ACCOMMODATE NEW LIGHTING LAYOUT IN ADJACENT ROOM. SEE LIGHTING NEW WORK PLAN SHEET E1.2 FOR MORE INFORMATION.

'E' - DENOTES AN EXISTING DEVICE TO REMAIN.

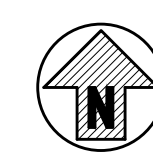

LIGHTING DEMOLITION PLAN -  
EXISTING LIBRARY  
SCALE: 1/8" = 1'-0"




**H.M. YONGE & ASSOCIATES, INC.**  
CONSULTING ENGINEERS / EST. 1988

51 EAST GREGORY STREET PENSACOLA, FLORIDA 32502  
PHONE: 1505434-2061

253 ST. ANTHONY STREET MOBILE, ALABAMA 36603  
PHONE: 1251690-7446

SHEET TITLE: LIGHTING DEMOLITION PLAN -  
EXISTING LIBRARY

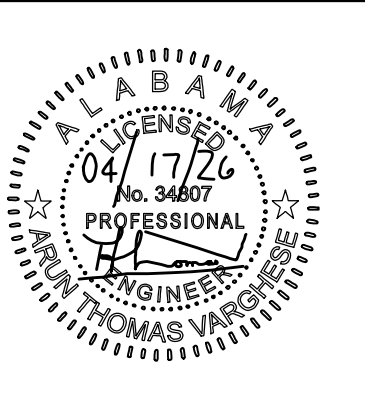


PROJ. MGR.: A. VARGHESE
DRAWN: C. PAGE
DATE: 03/25/26
REVISIONS
#1 04/17/26 DCM COMMENTS

JOB NO. 25-160B

SHEET NO:

ED1.1

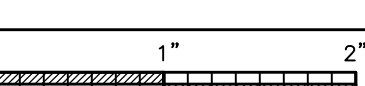




**DEMOLITION PLAN NOTES:**

1. THE ELECTRICAL CONTRACTOR IS RESPONSIBLE FOR SECURING ALL DEVICES, FIXTURES, WIRES, CONDUIT, ETC. ABOVE THE CEILING PRIOR TO CEILING DEMOLITION. THE ELECTRICAL CONTRACTOR IS RESPONSIBLE FOR DAMAGE CAUSED TO SUCH MATERIALS DURING THE CEILING DEMOLITION PHASE.
2. EXACT LOCATIONS FOR EXISTING MECHANICAL UNITS, DEVICES AND BOXES ARE TO BE FIELD VERIFIED.
3. ALL PENETRATIONS (NEW AND EXISTING) OF THE FIRE RATED BARRIERS SHALL BE FIRE STOPPED USING U.L. APPROVED METHODS AND MATERIALS.
4. ALL EXISTING PANELS ARE TO REMAIN (UNLESS OTHERWISE NOTED). THE ELECTRICAL CONTRACTOR IS TO VERIFY THE BREAKER SIZES, WIRE SIZES, PANEL SIZES, AND PANEL LOADS IN THE FIELD. ALL PANELS ARE TO BE COMPLETELY LABELED AND UPDATED DIRECTORIES INSTALLED. ALL PANELS ARE TO BE PROPERLY GROUNDED PER THE NATIONAL ELECTRIC CODE.
5. TERMINATED CIRCUITS THAT ARE NOT USED ON THE NEW WORK PLANS SHALL BE LABELED WITH THE SERVING PANEL AND CIRCUIT NUMBER CLEARLY MARKED ON THE TERMINATING JUNCTION BOX.
6. THE PHASING OF ALL WORK IS TO BE COORDINATED WITH OTHER CONTRACTORS (GENERAL, MECHANICAL, ETC.) PRIOR TO PROJECT COMMENCEMENT.
7. THE ELECTRICAL CONTRACTOR IS TO PROVIDE AND INSTALL JUNCTION BOX COVERS AS REQUIRED. ALL WIRE IN THE AREA OF WORK IS TO BE INSTALLED PROPERLY UPON COMPLETION OF THE PROJECT.
8. THE ELECTRICAL CONTRACTOR IS RESPONSIBLE FOR KEEPING ALL DEVICES, LIGHT FIXTURES AND OTHER EQUIPMENT TO REMAIN ACTIVE - CIRCUITS ASSOCIATED WITH BOTH REMOVED ELECTRICAL WORK AND ELECTRICAL WORK TO REMAIN ARE TO BE EXTENDED WITH WIRE, CONDUIT, BOXES, ETC. (SIZE TO MATCH EXISTING) TO KEEP THE WORK TO REMAIN ACTIVE.
9. THE CONTRACTOR SHOULD MAINTAIN THE INTEGRITY OF THE FIRE ALARM SYSTEM IN THE FACILITY AND IN THE CONSTRUCTION AREA AT ALL TIMES.

**ELECTRICAL DEMOLITION PLAN KEY NOTES:**


1. EXISTING AIR TERMINAL UNIT SHALL BE REMOVED. EXISTING CIRCUIT SHALL BE DISCONNECTED AND PREPARED FOR EXTENSION TO NEW UNIT. SEE NEW WORK PLAN FOR MORE INFORMATION.
2. EXISTING TEMPERATURE CONTROLLER SHALL BE REMOVED FROM WALL AND RELOCATED PER SYSTEMS NEW WORK PLAN. COORDINATE NEW TEMPERATURE CONTROLLER LOCATION WITH MECHANICAL CONTRACTOR.
3. EXISTING RECEPTACLE SHALL BE REMOVED. INCLUDE WITH REMOVAL THE DEMOLITION OF ANY CONDUIT AND WIRING ASSOCIATED WITH DEVICE. FIELD VERIFY EXACT LOCATION.
4. EXISTING ANNUNCIATOR PANEL SHALL REMAIN. PROTECT DURING DEMOLITION AND CONSTRUCTION. FIELD VERIFY EXACT LOCATION.
5. EXISTING FIRE ALARM CONTROL PANEL SHALL REMAIN. PROTECT DURING DEMOLITION AND CONSTRUCTION. FIELD VERIFY EXACT LOCATION.
6. EXISTING DATA RECEPTACLE SHALL BE REMOVED. INCLUDE WITH REMOVAL THE DEMOLITION OF ANY CONDUIT AND WIRING ASSOCIATED WITH DEVICE. FIELD VERIFY EXACT LOCATION.
7. EXISTING FIRE ALARM NOTIFICATION DEVICE SHALL BE DEMOLISHED. EXISTING FIRE ALARM CIRCUITS SHALL REMAIN AND BE REUSED WITH NEW FIRE ALARM LAYOUT.
8. EXISTING I.T. RACK SHALL REMAIN. PROTECT DURING DEMOLITION.

'E' - DENOTES AN EXISTING DEVICE TO REMAIN

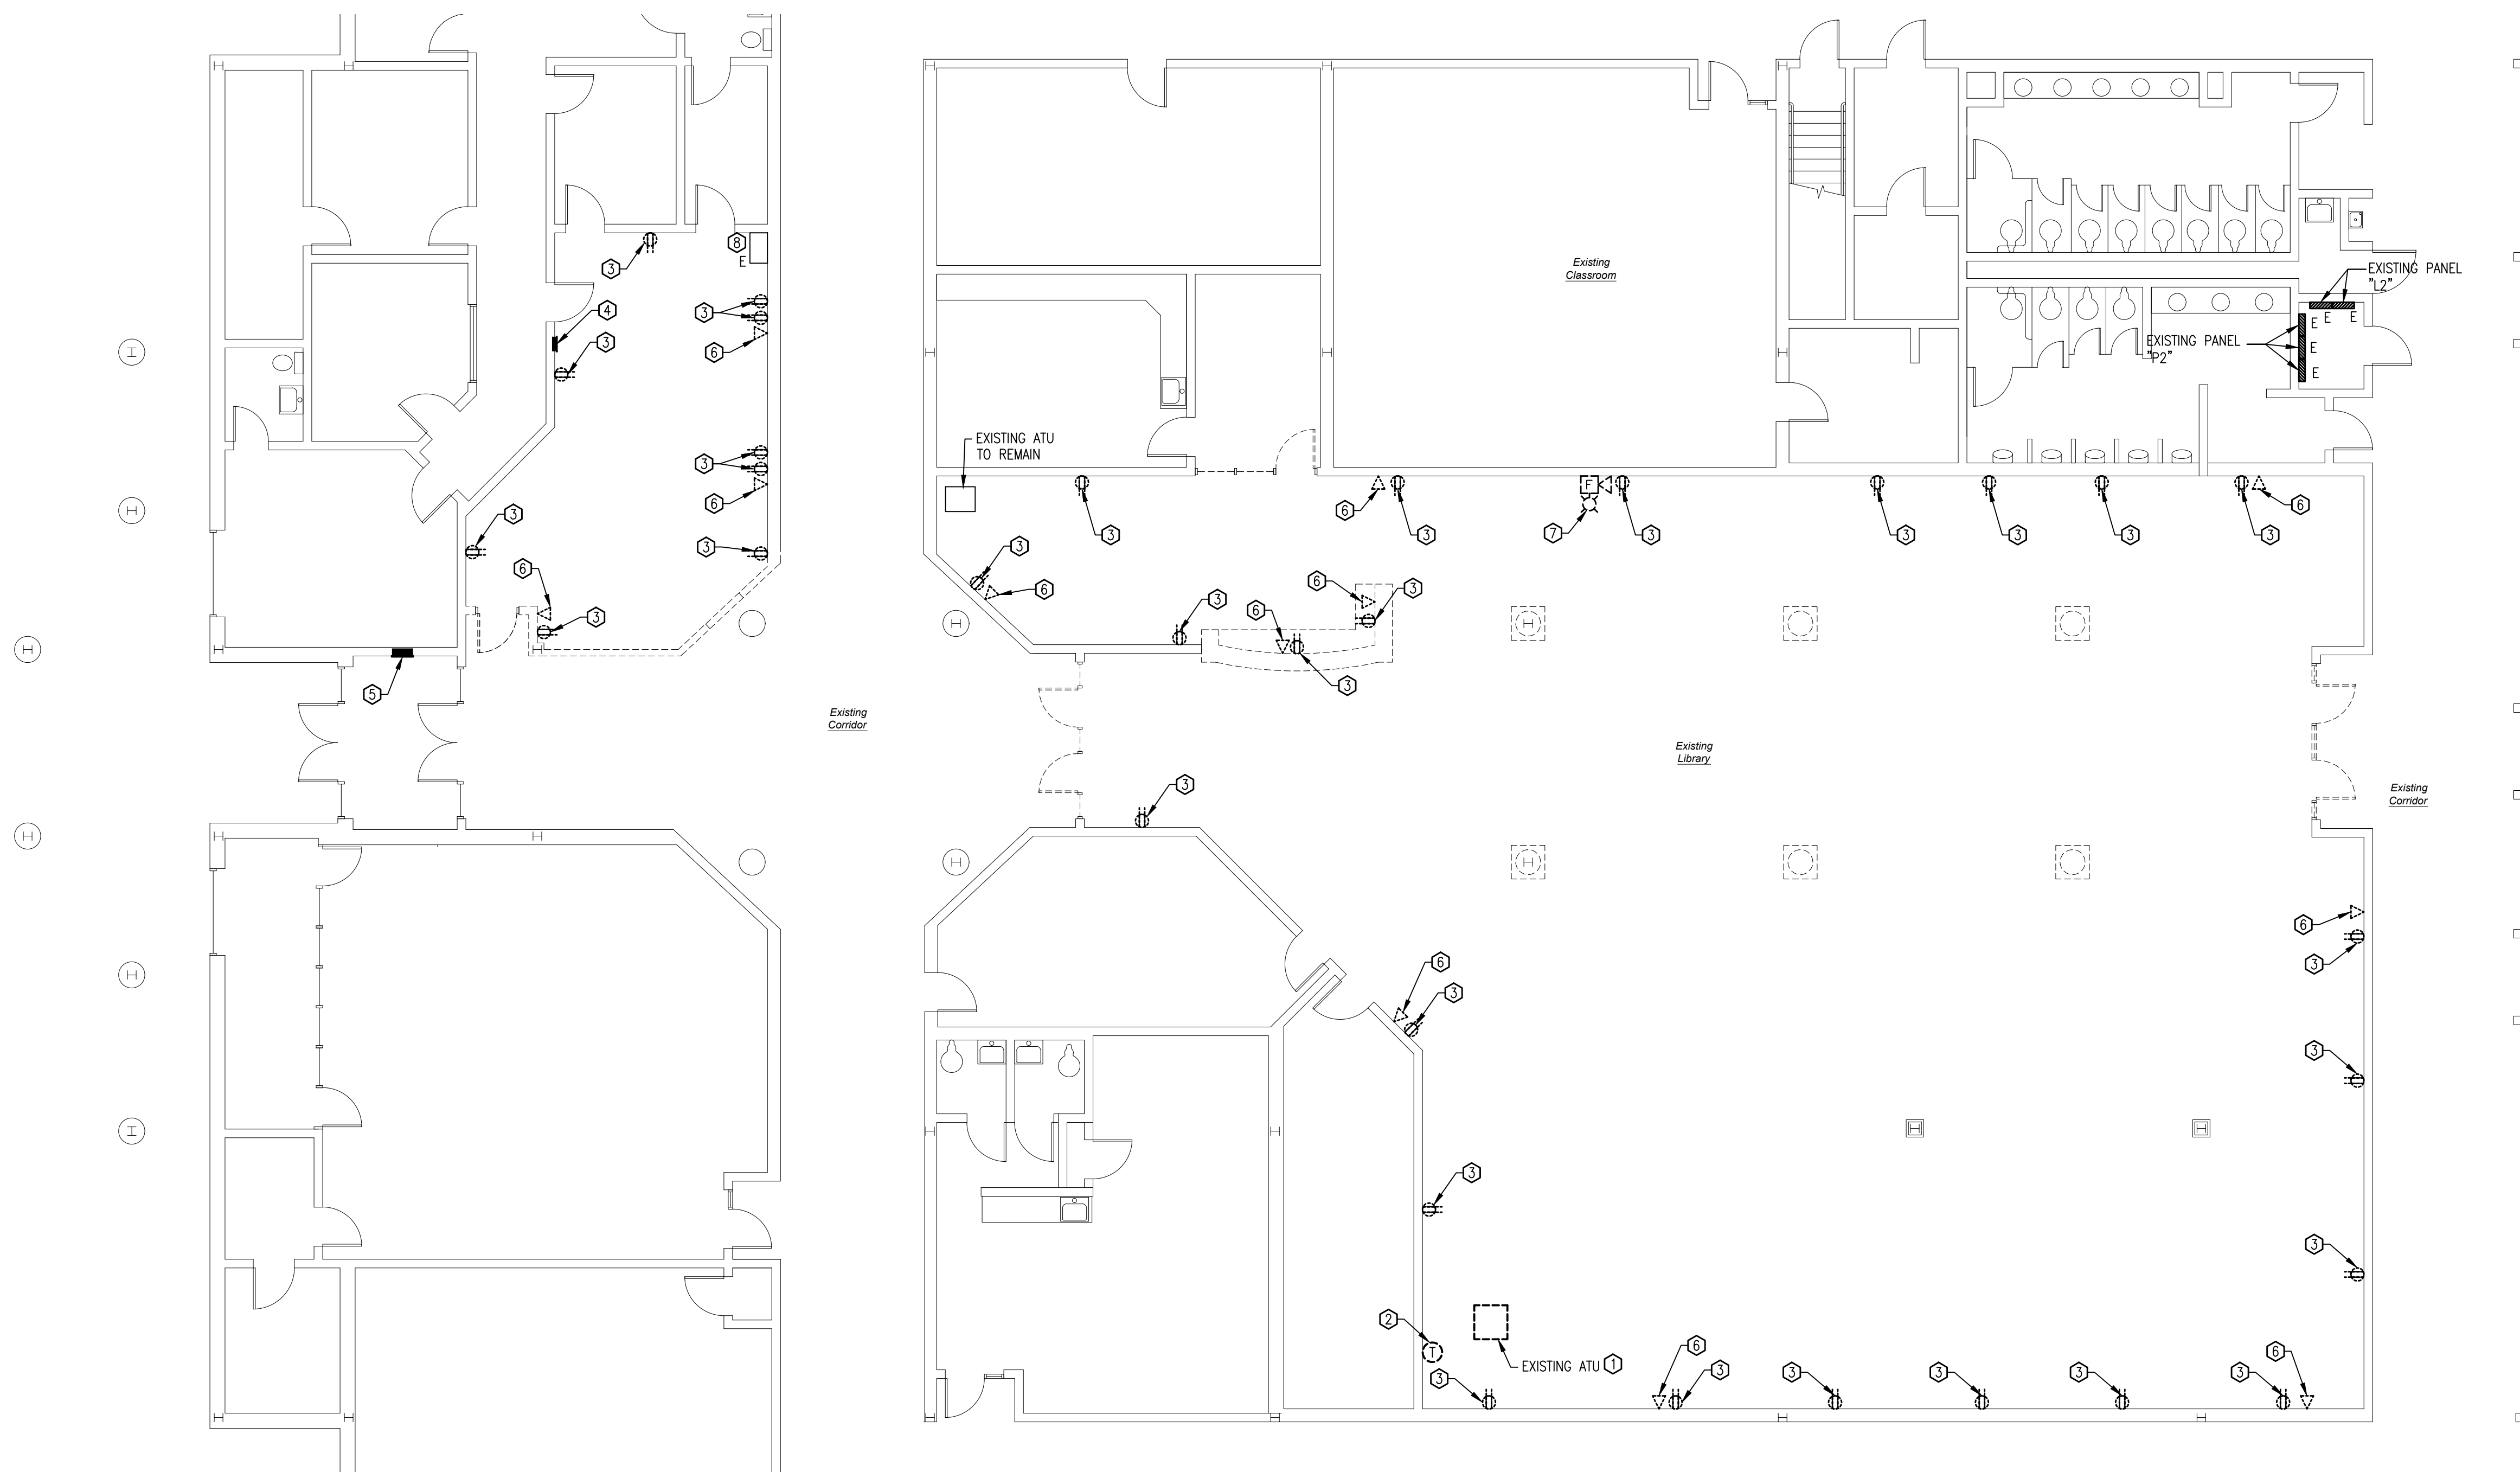

**ELECTRICAL DEMOLITION PLAN -  
EXISTING LIBRARY**  
SCALE: 1/8" = 1'-0"  
0 4 8  
2 6

SHEET TITLE: ELECTRICAL DEMOLITION PLAN -  
EXISTING LIBRARY

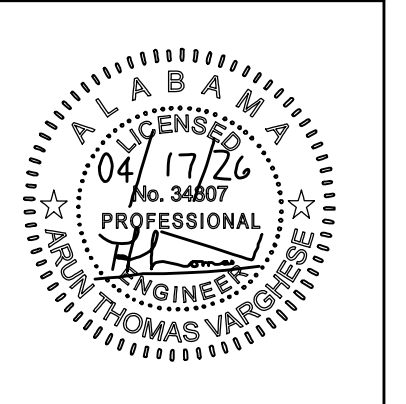

PROJ. MGR.:	A. VARGHESE
DRAWN:	C. PAGE
DATE:	03/25/26
REVISIONS	
#1	04/17/26 DCM COMMENTS

JOB NO.	25-160B
SHEET NO.	ED2.1

**H.M. YONGE & ASSOCIATES, INC.**  
CONSULTING ENGINEERS • EST. 1988  
51 EAST GREGORY STREET PENSACOLA, FLORIDA 32502  
253 ST. ANTHONY STREET MOBILE, ALABAMA 36603  
PHONE: (904)334-2061 PHONE: (251)690-7446